
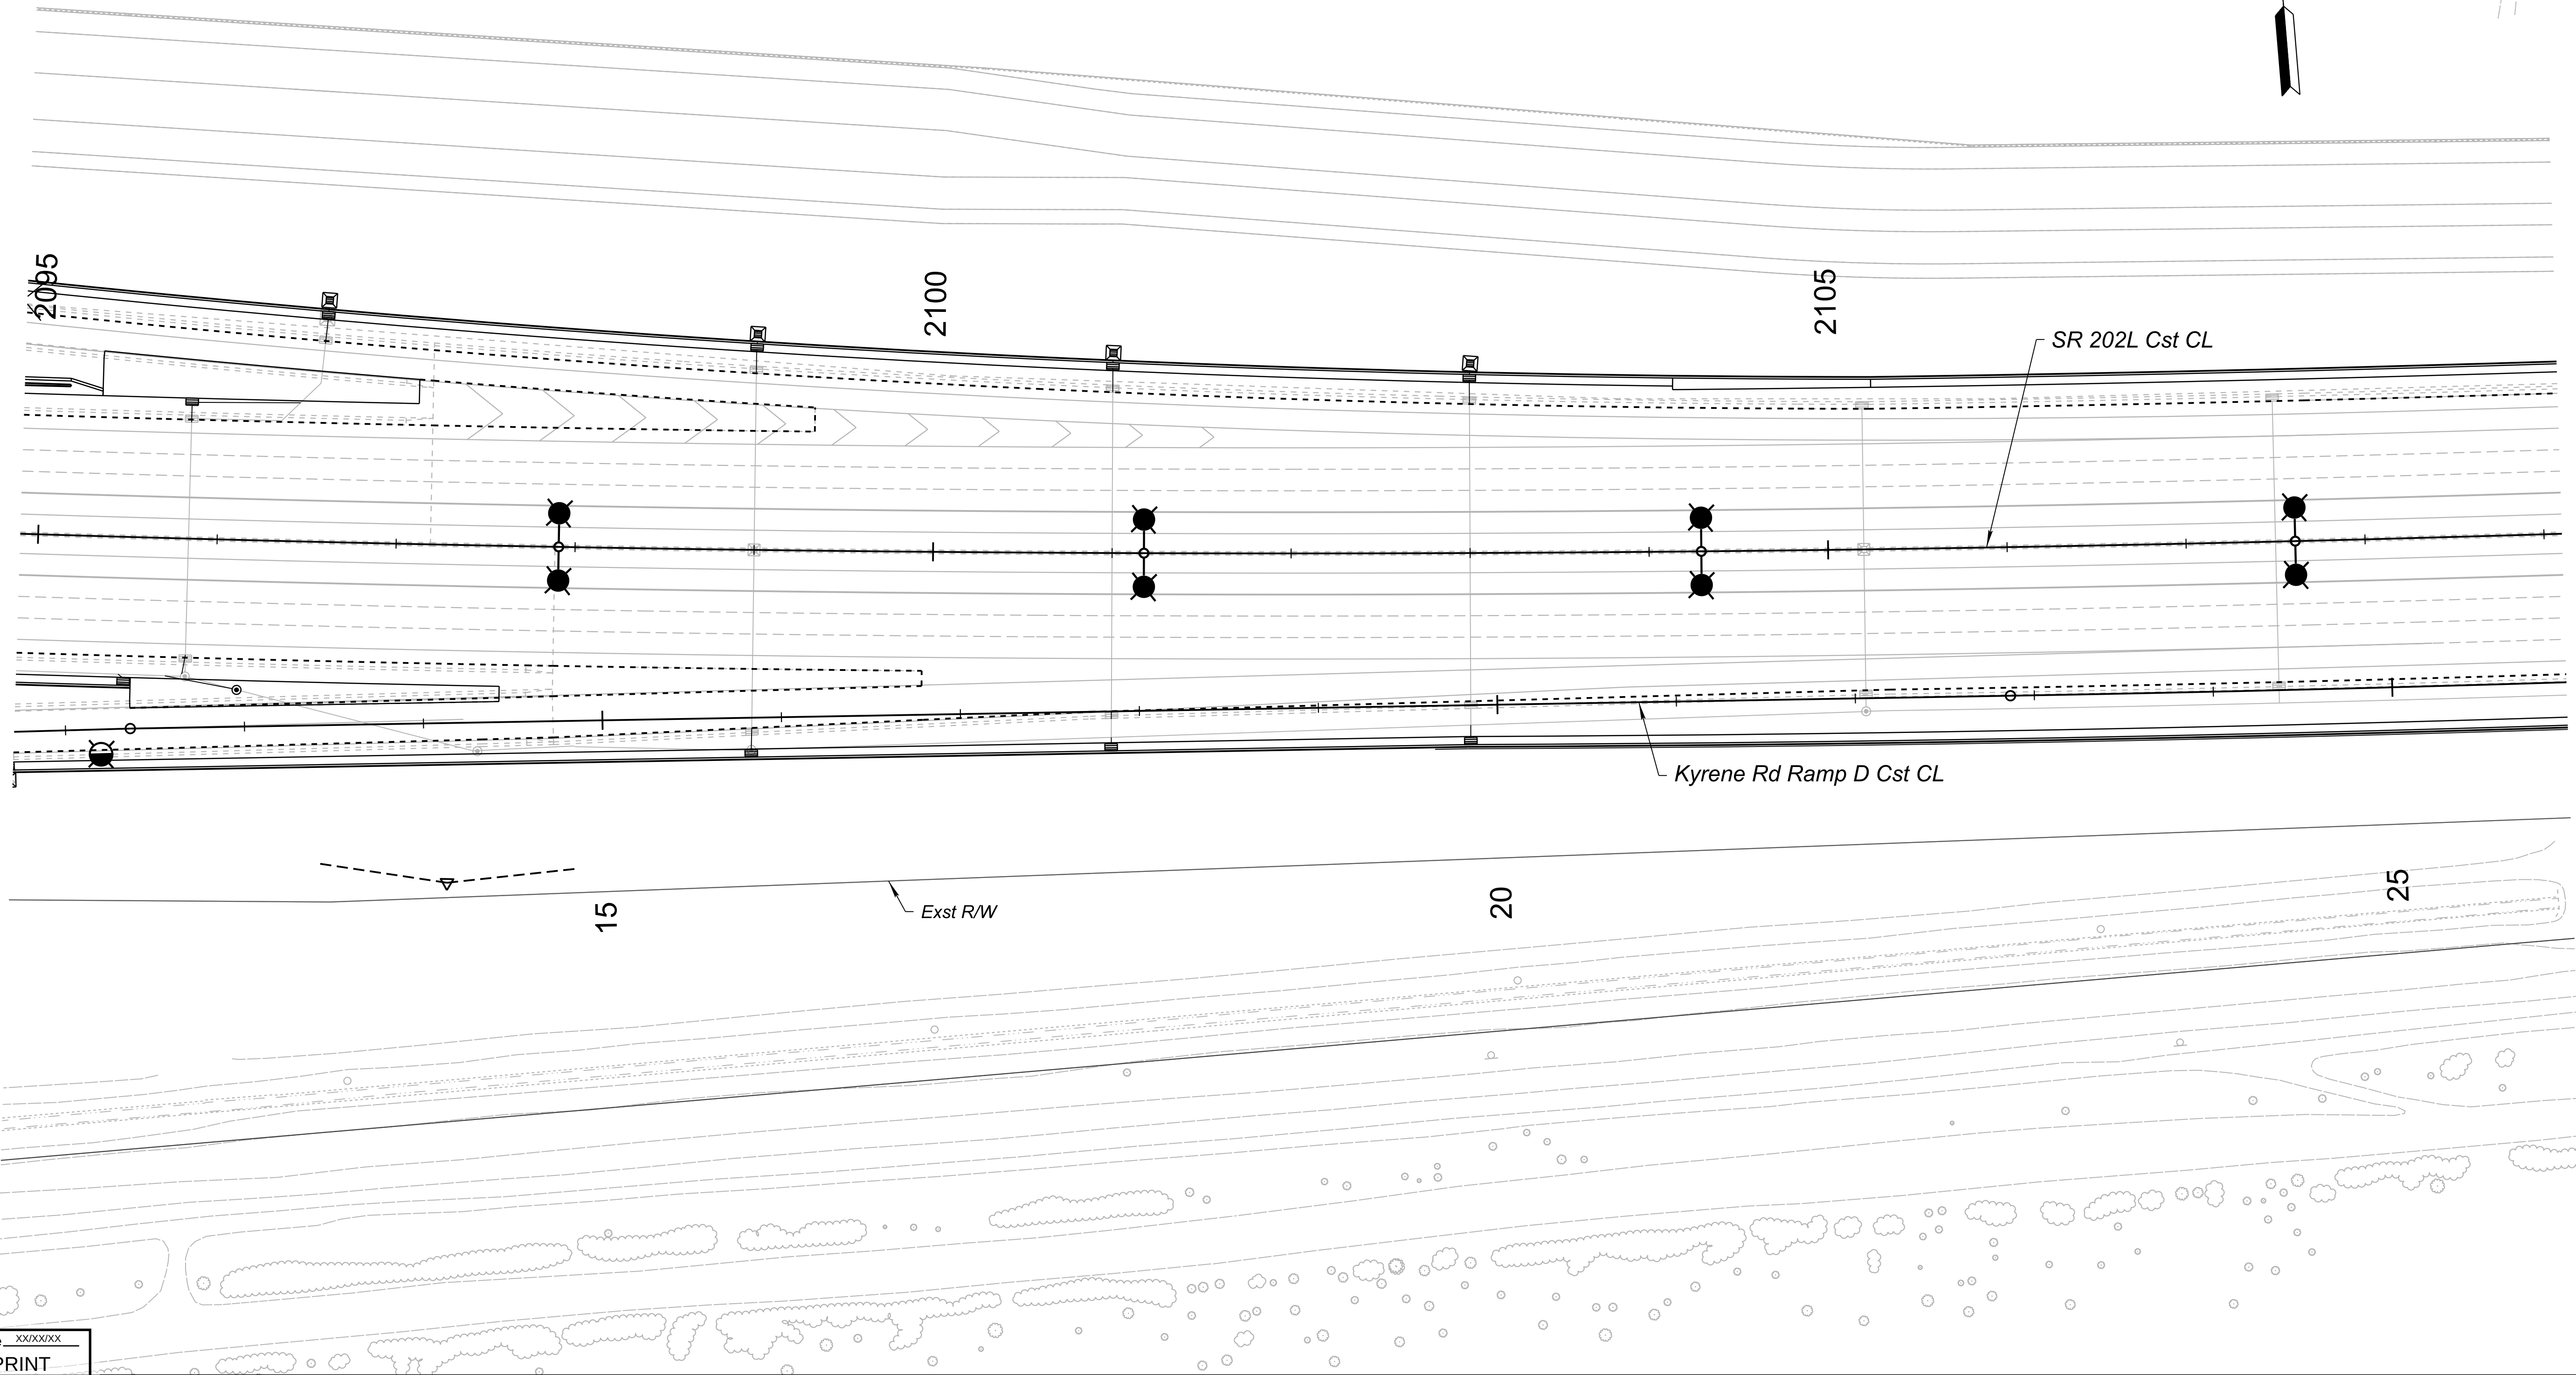


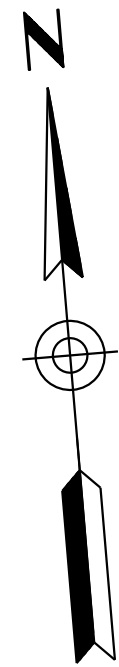

No. XXXX	Date XX/XX/XX
CHECK PRINT	
Dgn. checked against calcs. and calc. check confirmed.	
By X. XXXXXXXX	Date XX/XX/XX

Checked X. XXXXXX	Date XXXXXX
Backchecked X. XXXXXX	Date XXXXXX
Corrected X. XXXXXX	Date XXXXXX
Verified X. XXXXXX	Date XXXXXX

PRELIMINARY
STAGE III
Review
NOT FOR
CONSTRUCTION
OR RECORDING

DESIGN	NAME	DATE
DRAWN		
CHECKED		
	501 N 44th St, Suite 300 Phoenix, AZ 85008-4505 Tel (602) 454-0402 www.typsas.us	

ARIZONA DEPARTMENT OF TRANSPORTATION PROJECT DELIVERY AND OPERATIONS DIVISION DRAINAGE DESIGN SECTION
SR 202L DRAINAGE PLAN SHEET STA 2095+00 TO 2109+00

ROUTE SR 202L	F.H.W.A. Arizona Division	STATE ARIZ.	PROJECT NO.	FEDERAL ID NO.	SHEET NO.	TOTAL SHEETS	RECORD DRAWING
MILEPOST	SR 202L SANTAN FREEWAY - I-10 TO SR 101L						
STRUCTURE NO.	TRACS NO. F0847 01D						DWG No. D-02.10 ____ OF ____