
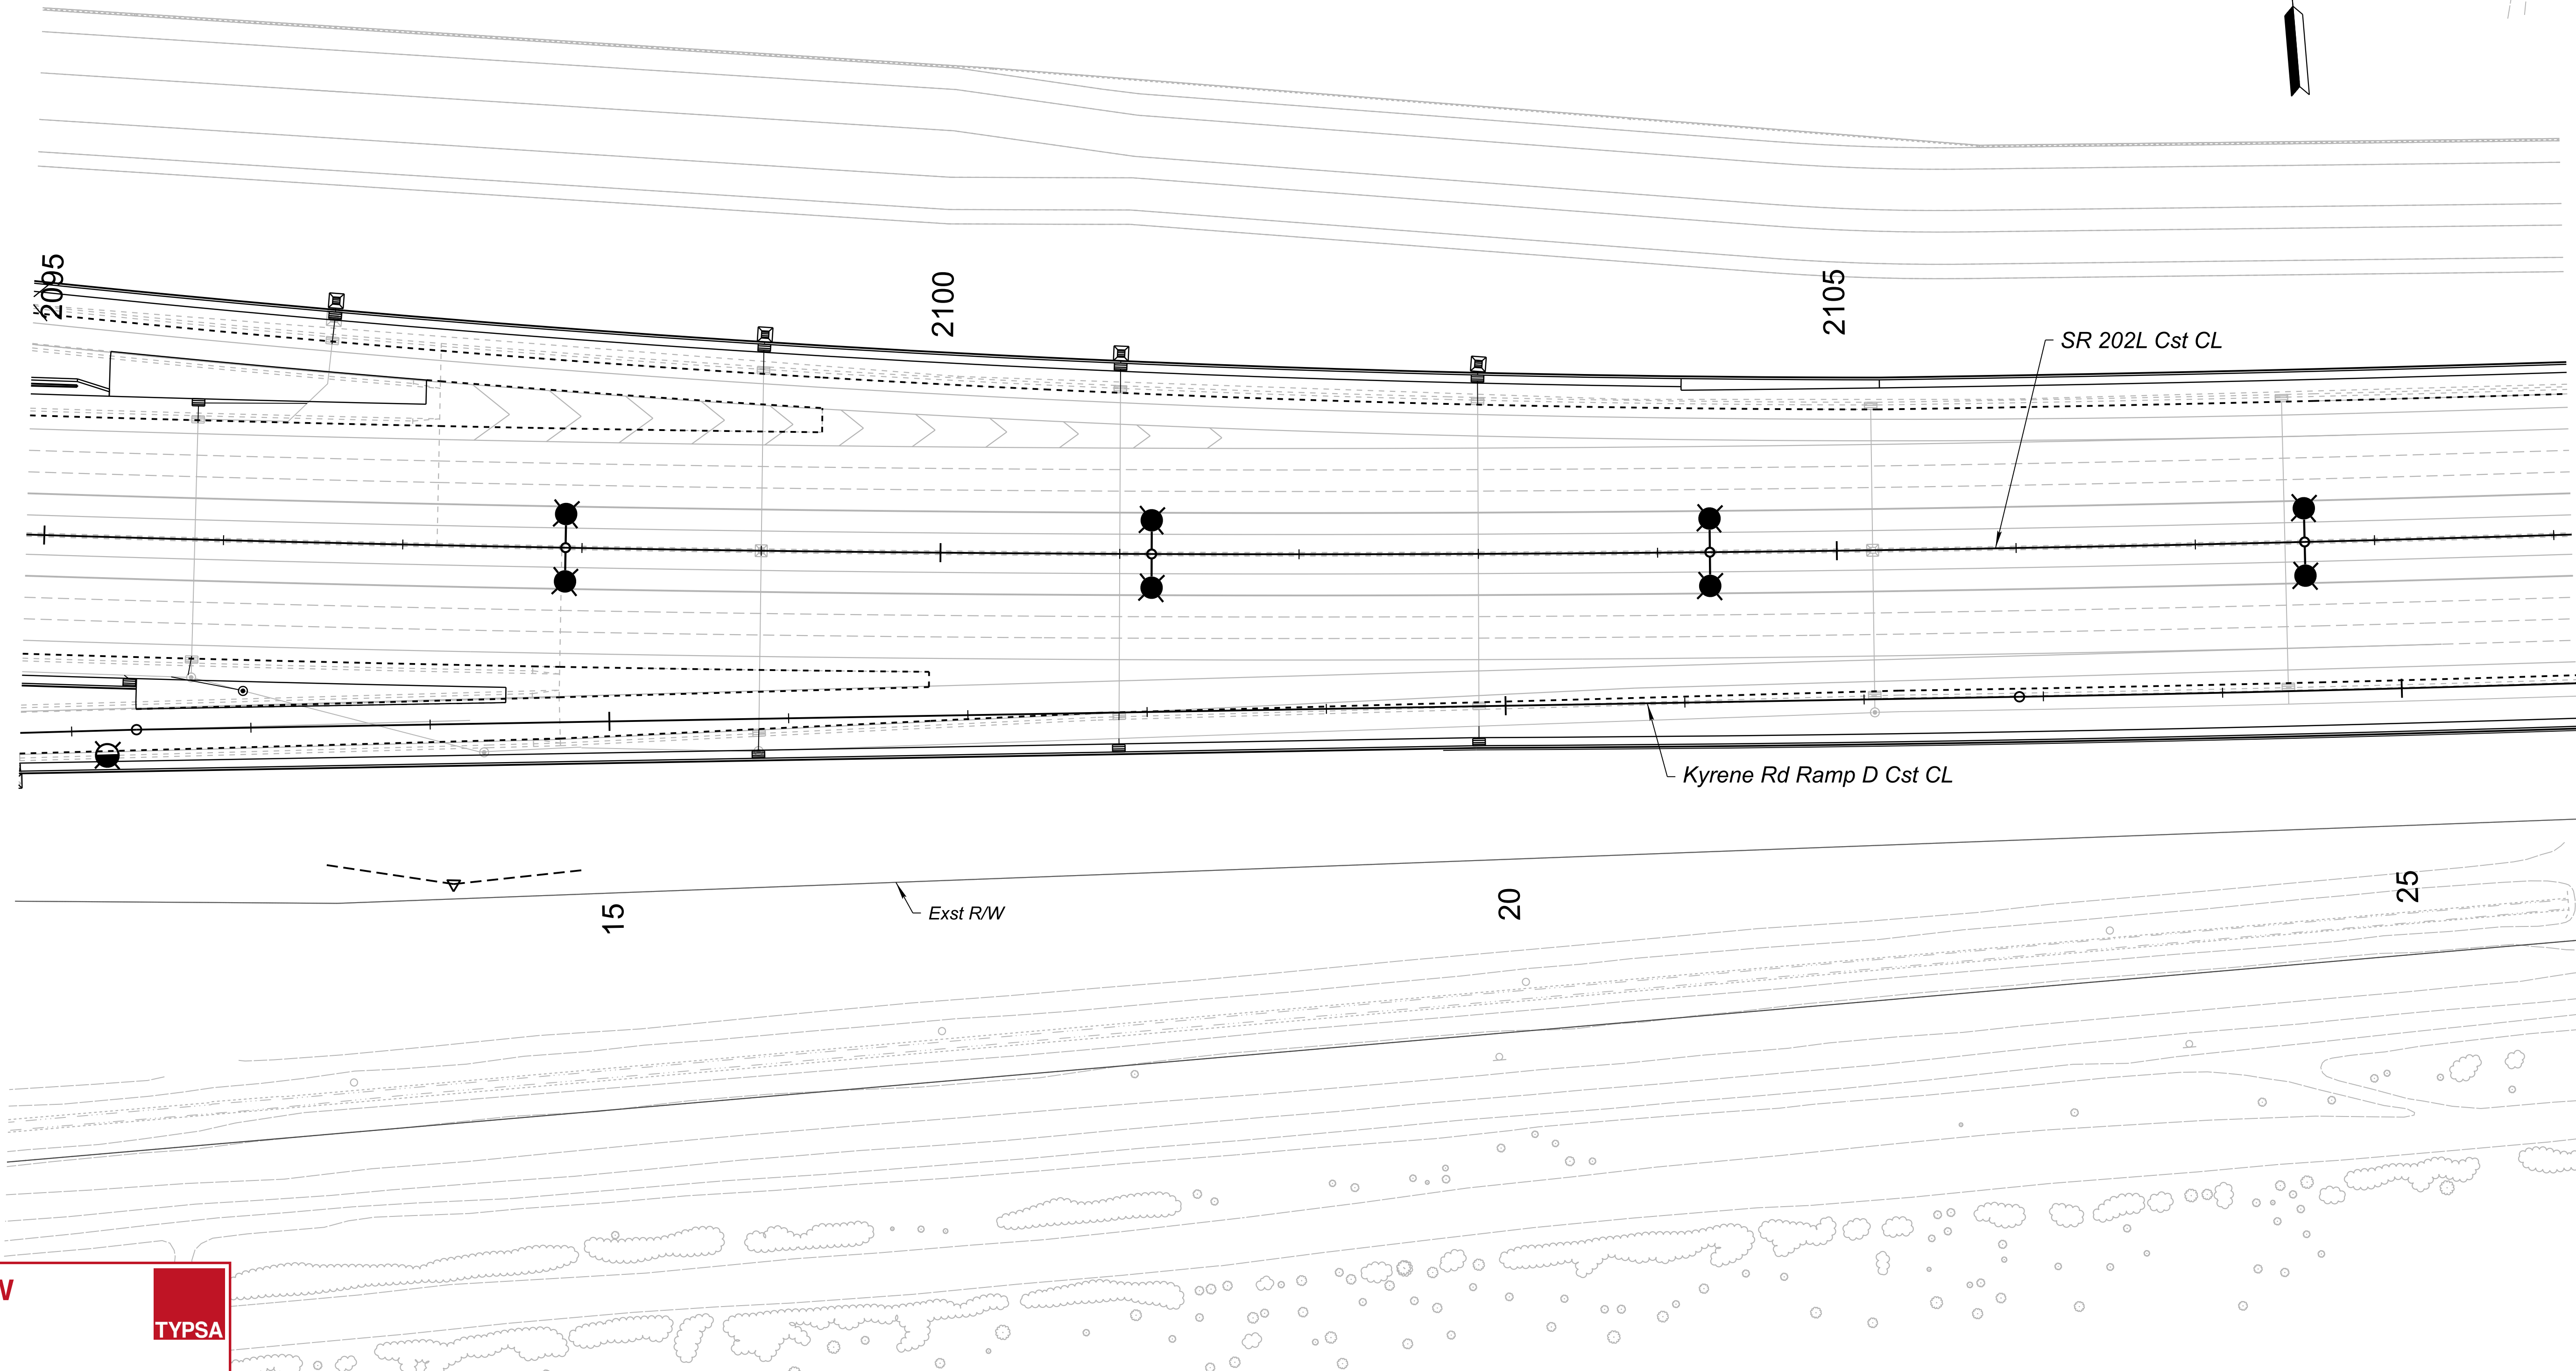


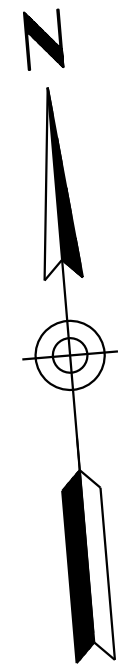

REVIEW

TYPSA

Originator
Checker
Backchecker
Updater
Rechecker

Date
Date
PRELIMINARY
STAGE III
Review
NOT FOR
CONSTRUCTION
OR RECORDING

DESIGN	NAME	DATE
DRAWN		
CHECKED		
	501 N 44th St, Suite 300 Phoenix, AZ 85008-4505 Tel (602) 454-0402 www.tyrsa.us	

ARIZONA DEPARTMENT OF TRANSPORTATION
PROJECT DELIVERY AND OPERATIONS DIVISION
DRAINAGE DESIGN SECTION
SR 202L
DRAINAGE PLAN SHEET
STA 2095+00 TO 2109+00

ROUTE
SR 202L
MILEPOST
STRUCTURE NO.

F.H.W.A. Arizona Division	STATE ARIZ.	PROJECT NO.	FEDERAL ID NO.	SHEET NO.	TOTAL SHEETS	RECORD DRAWING
SR 202L SANTAN FREEWAY - I-10 TO SR 101L						DWG No. D-02.10
TRACS NO. F0847 01D						___ OF ___