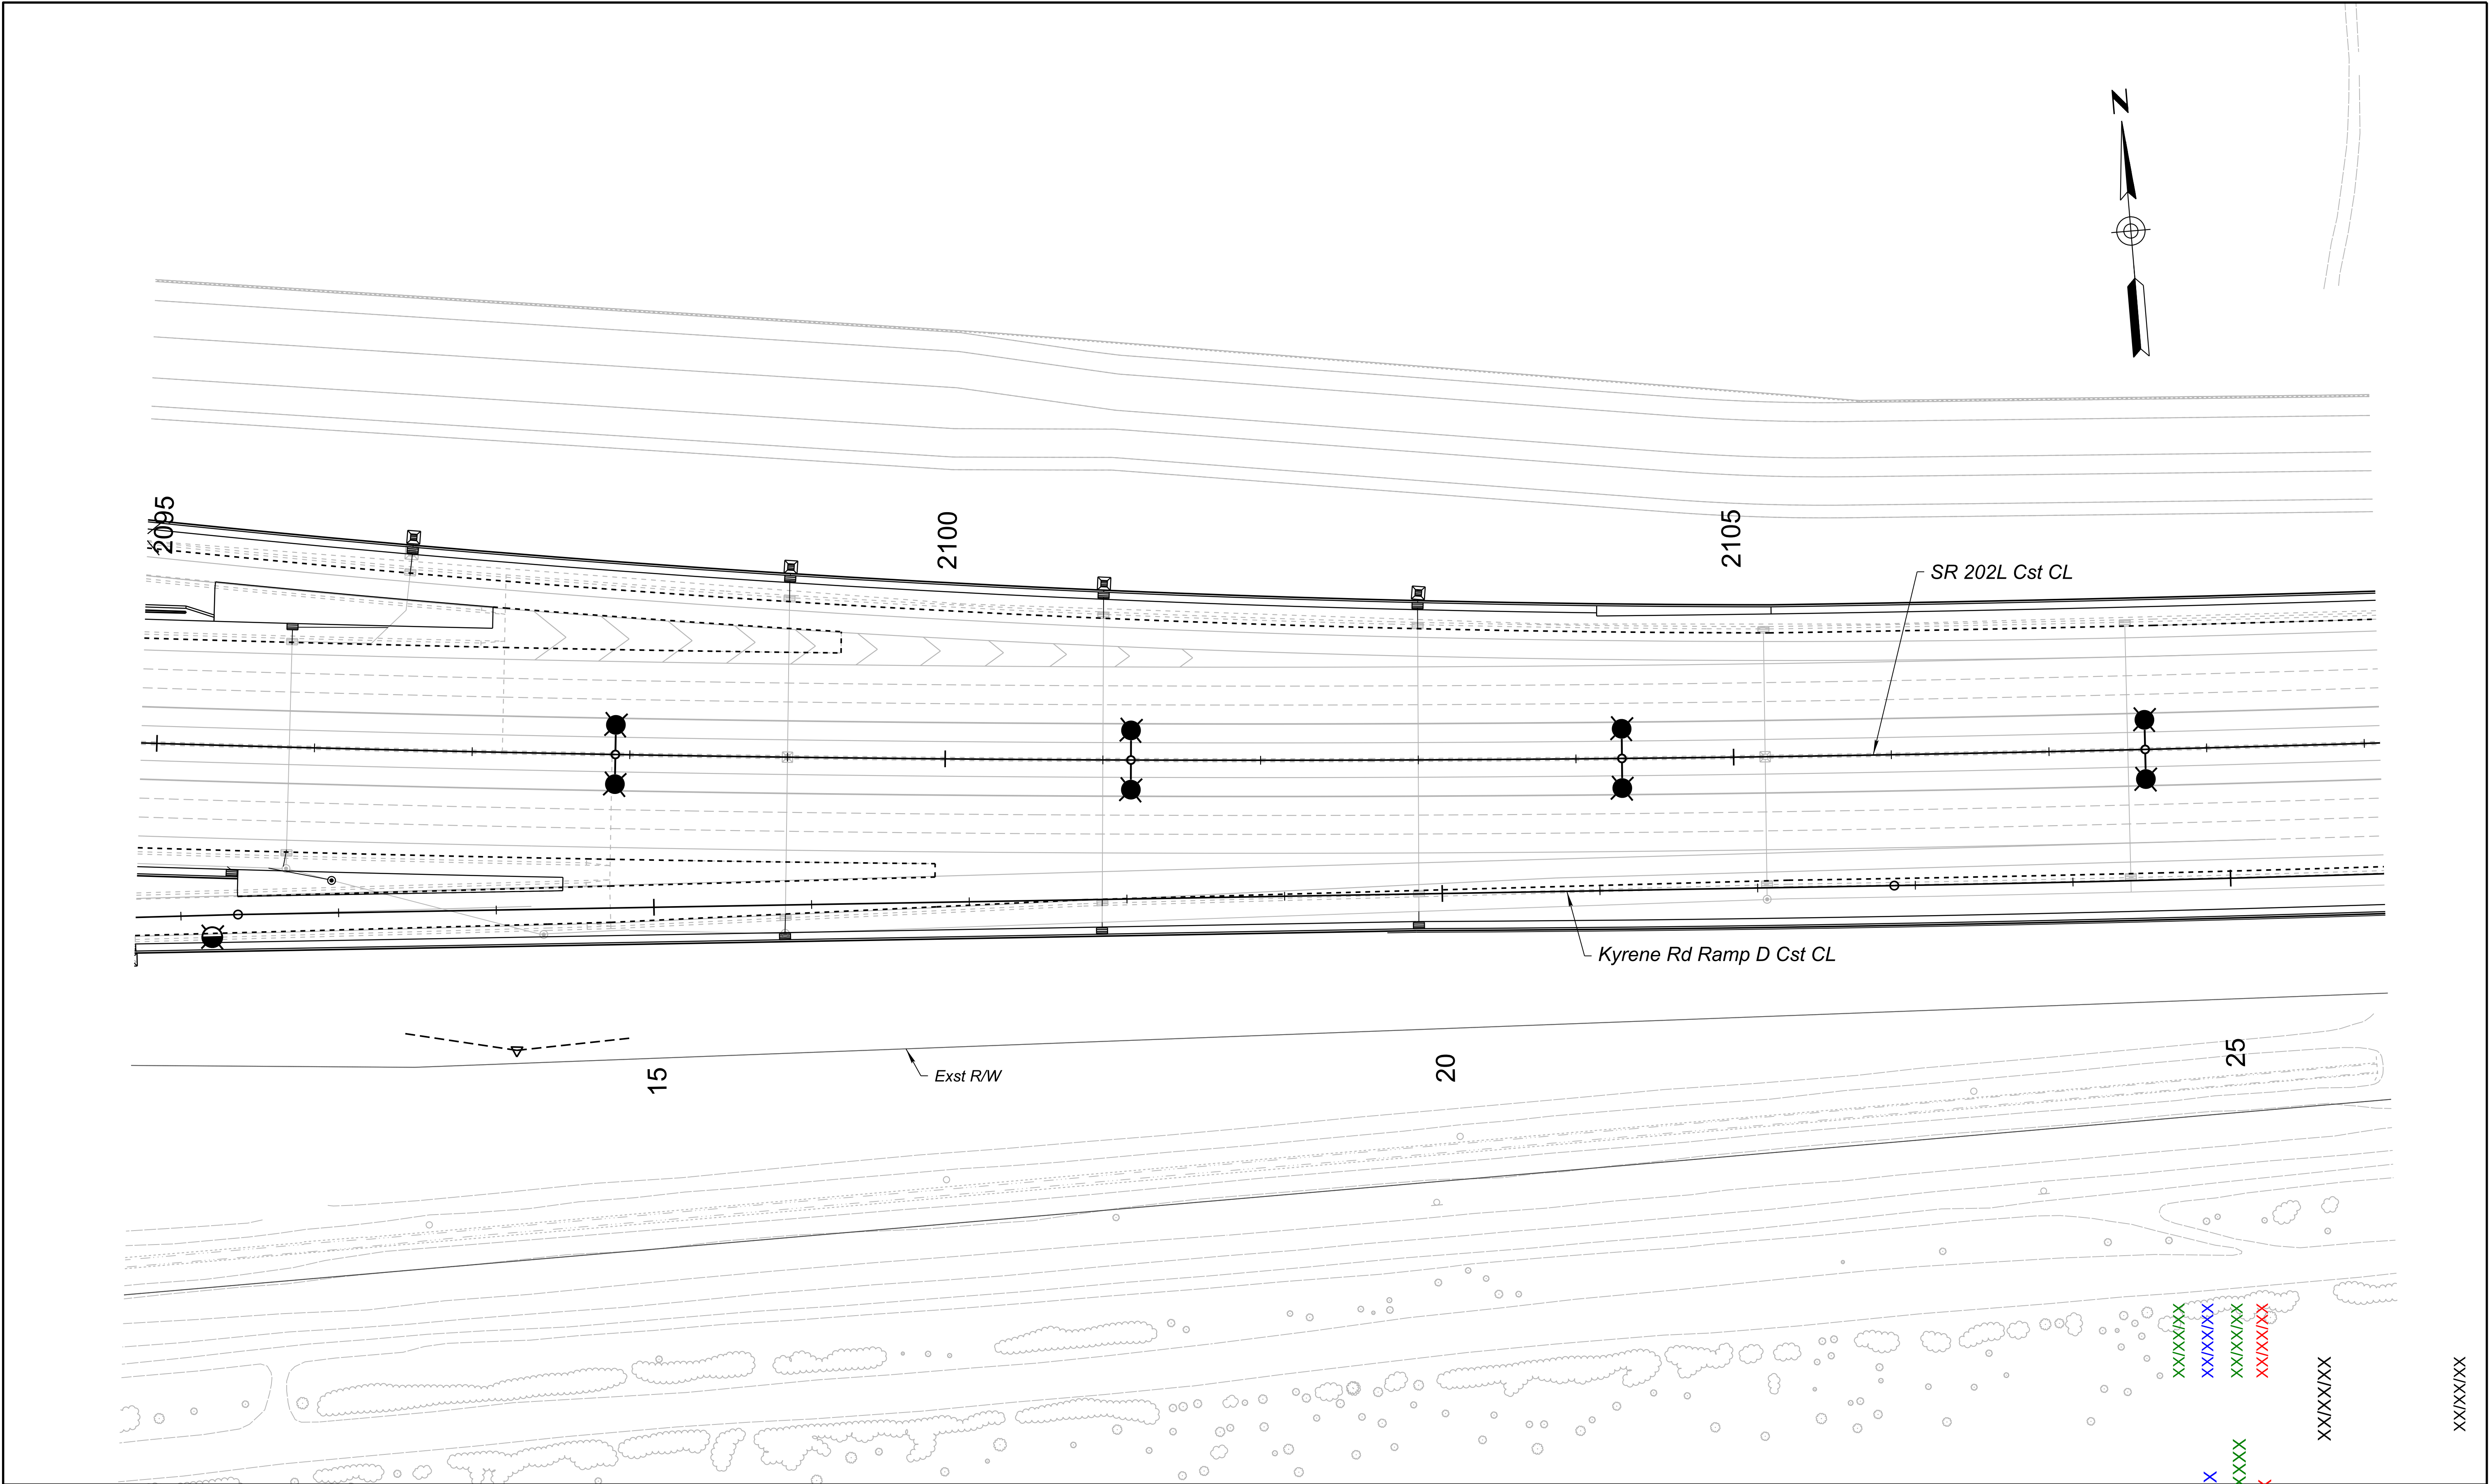


PRELIMINARY STAGE III Review NOT FOR CONSTRUCTION OR RECORDING	DESIGN	NAME	DATE	ARIZONA DEPARTMENT OF TRANSPORTATION PROJECT DELIVERY AND OPERATIONS DIVISION DRAINAGE DESIGN SECTION SR 202L DRAINAGE PLAN SHEET STA 2095+00 TO 2109+00	ROUTE SR 202L	F.H.W.A. Arizona Division	STATE ARIZ.	PROJECT NO.	FEDERAL AID NO.	SHEET NO.	TOTAL SHEETS	RECORD DRAWING
	DRAWN											
	CHECKED					MILEPOST	LOCATION SR 202L SANTAN FREEWAY - I-10 TO SR 101L					
	501 N 44th St, Suite 300 Phoenix, AZ 85008-4505 Tel (602) 454-0402 www.typsas.us	STRUCTURE NO.						TRACS NO. F0847 01D		DWG No. D-02.10 OF 10		