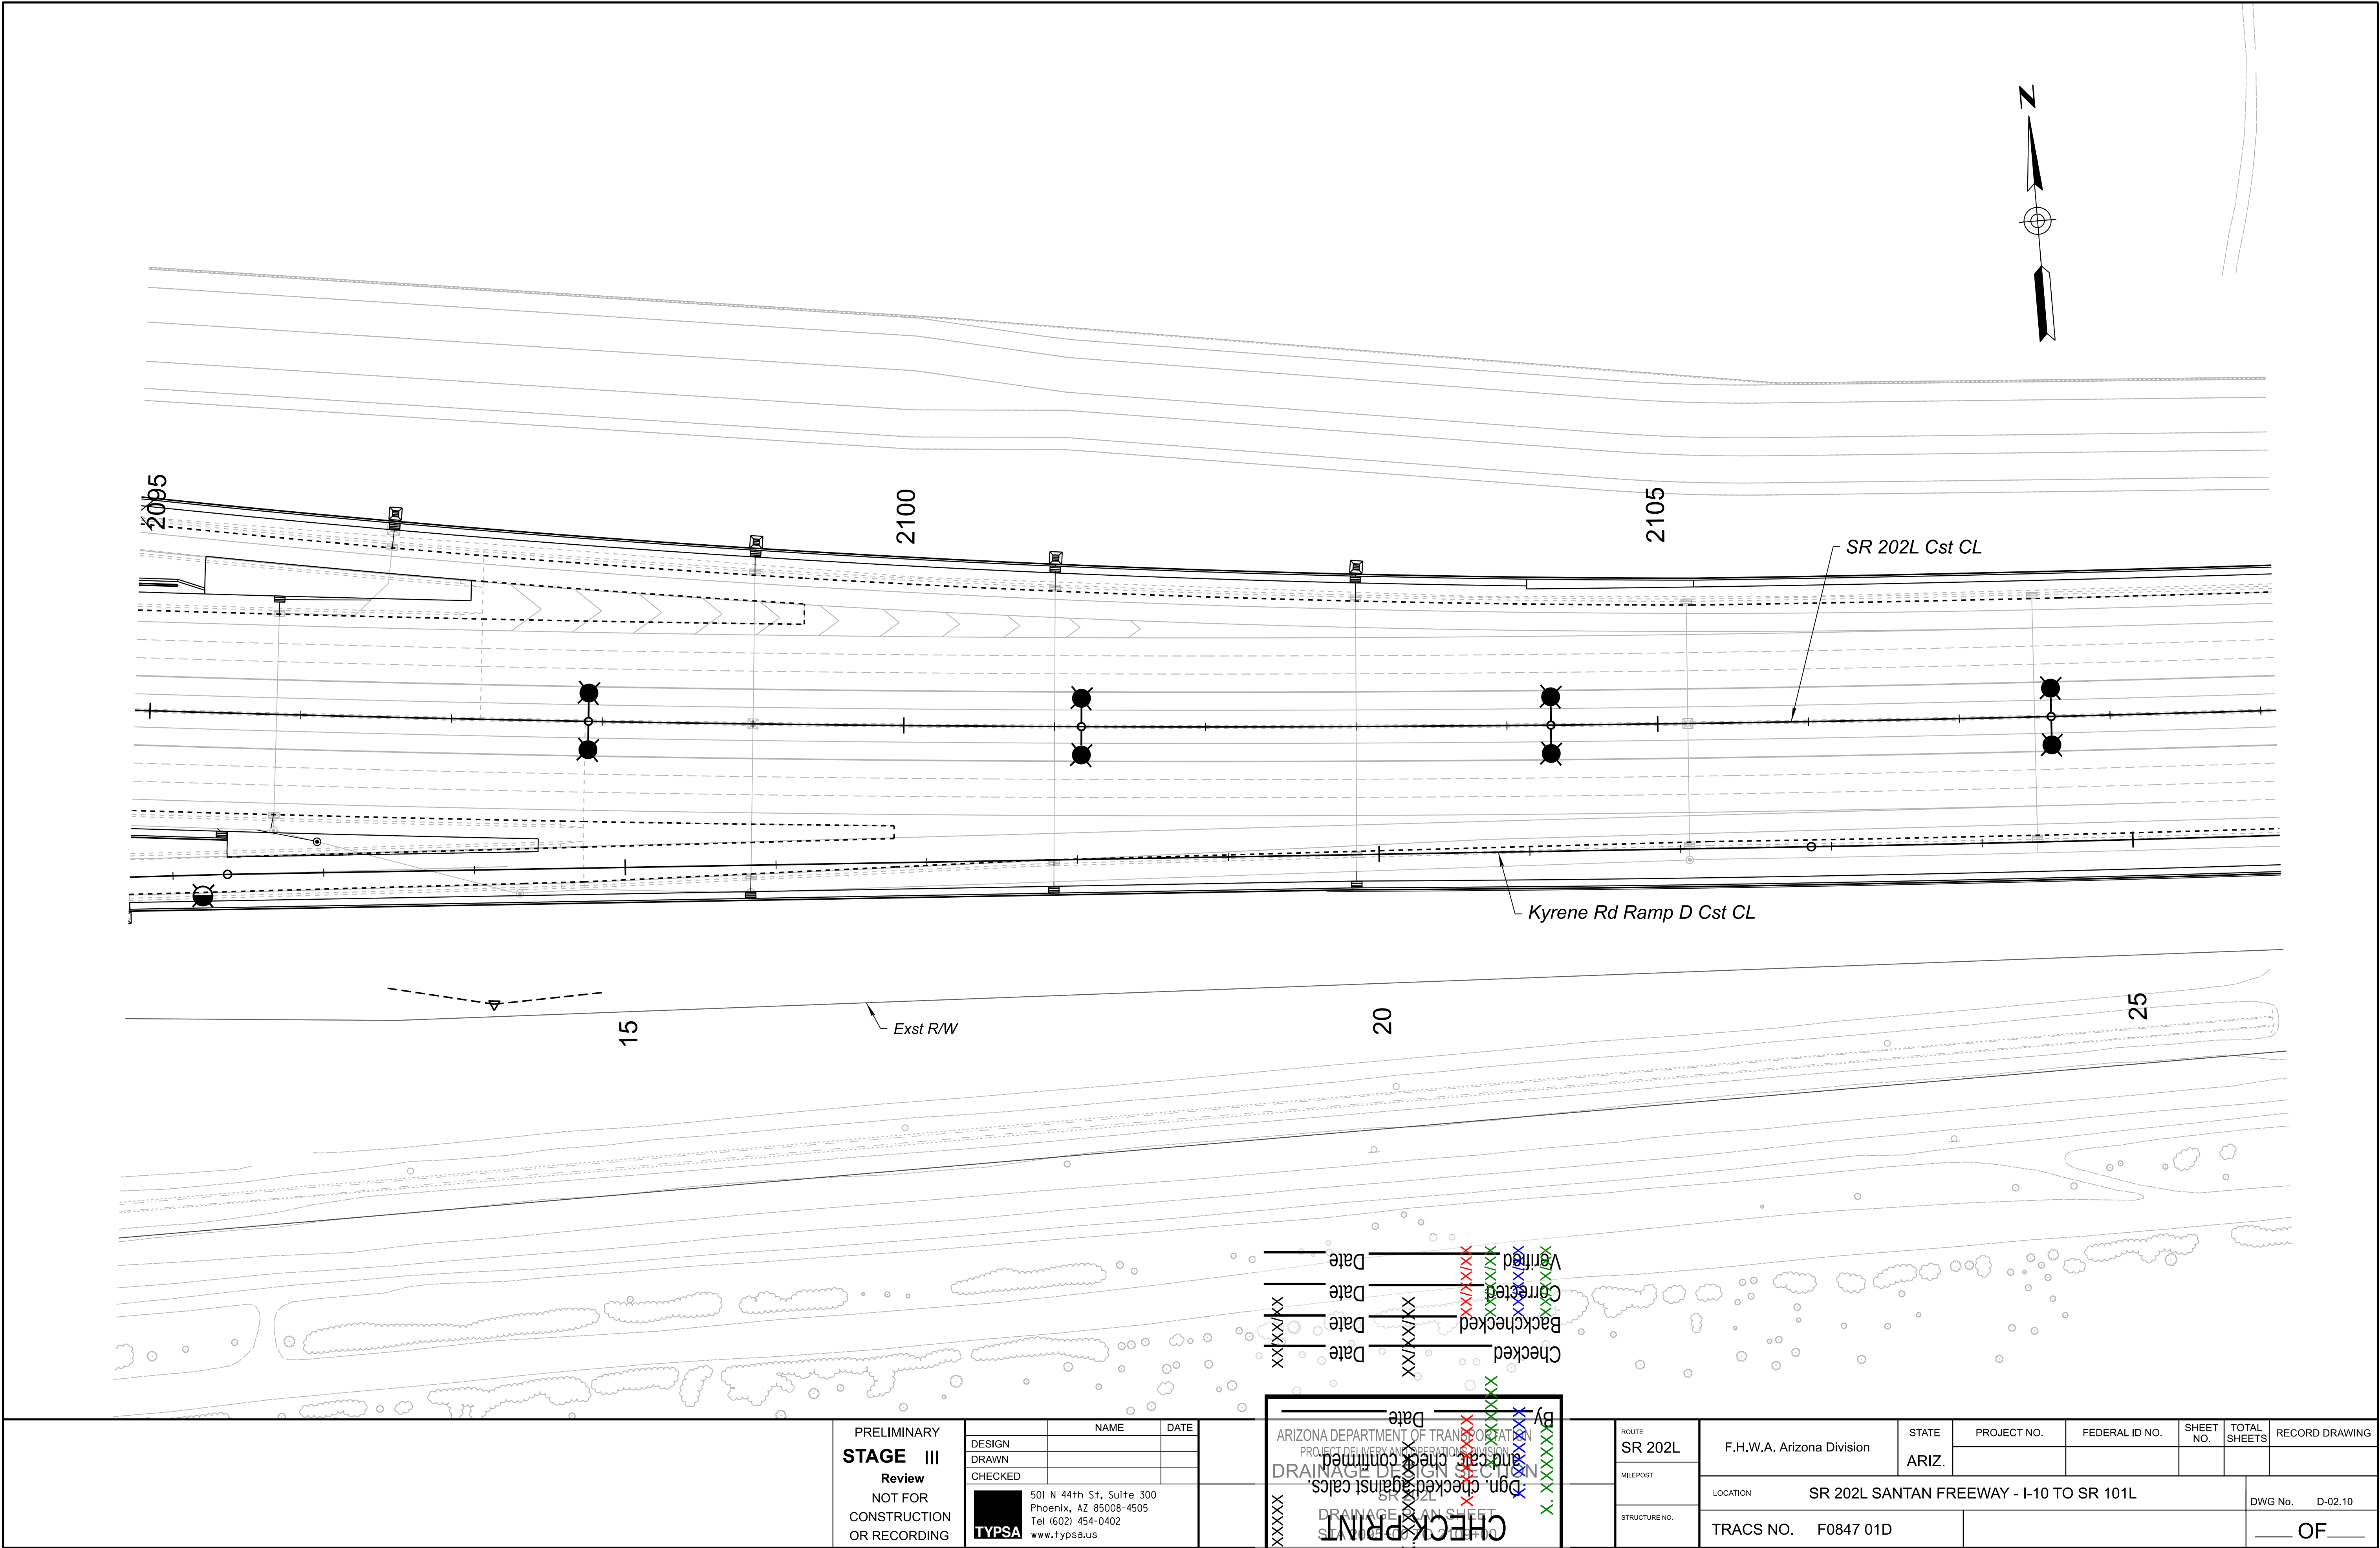


Checked	Date	xxx/xxx/xx
Backchecked	Date	xxx/xxx/xx
Corrected	Date	xxx/xxx/xx
Verified	Date	xxx/xxx/xx

No.	Date	xxx/xxx/xx
Checked	Date	xxx/xxx/xx
Backchecked	Date	xxx/xxx/xx
Corrected	Date	xxx/xxx/xx
Verified	Date	xxx/xxx/xx

PRELIMINARY STAGE III Review NOT FOR CONSTRUCTION OR RECORDING	DESIGN	NAME	DATE	ARIZONA DEPARTMENT OF TRANSPORTATION PROJECT DELIVERY AND OPERATIONS DIVISION DRAINAGE DESIGN SECTION DRAINAGE PLAN SHEET SR 202L SANTAN FREEWAY - I-10 TO SR 101L DGN, checked against calcs and all check confirmed By: [Signature] Date: [Date]	ROUTE	SR 202L	F.H.W.A. Arizona Division	STATE	ARIZ.	PROJECT NO.	FEDERAL ID NO.	SHEET NO.	TOTAL SHEETS	RECORD DRAWING
	DRAWN				MILEPOST		LOCATION	SR 202L SANTAN FREEWAY - I-10 TO SR 101L				DWG No.	D-02.10	
	CHECKED				STRUCTURE NO.		TRACS NO.	F0847 01D				OF		

501 N 44th St, Suite 300
Phoenix, AZ 85008-4505
Tel (602) 454-0402
www.typpsa.us

TYPSA