


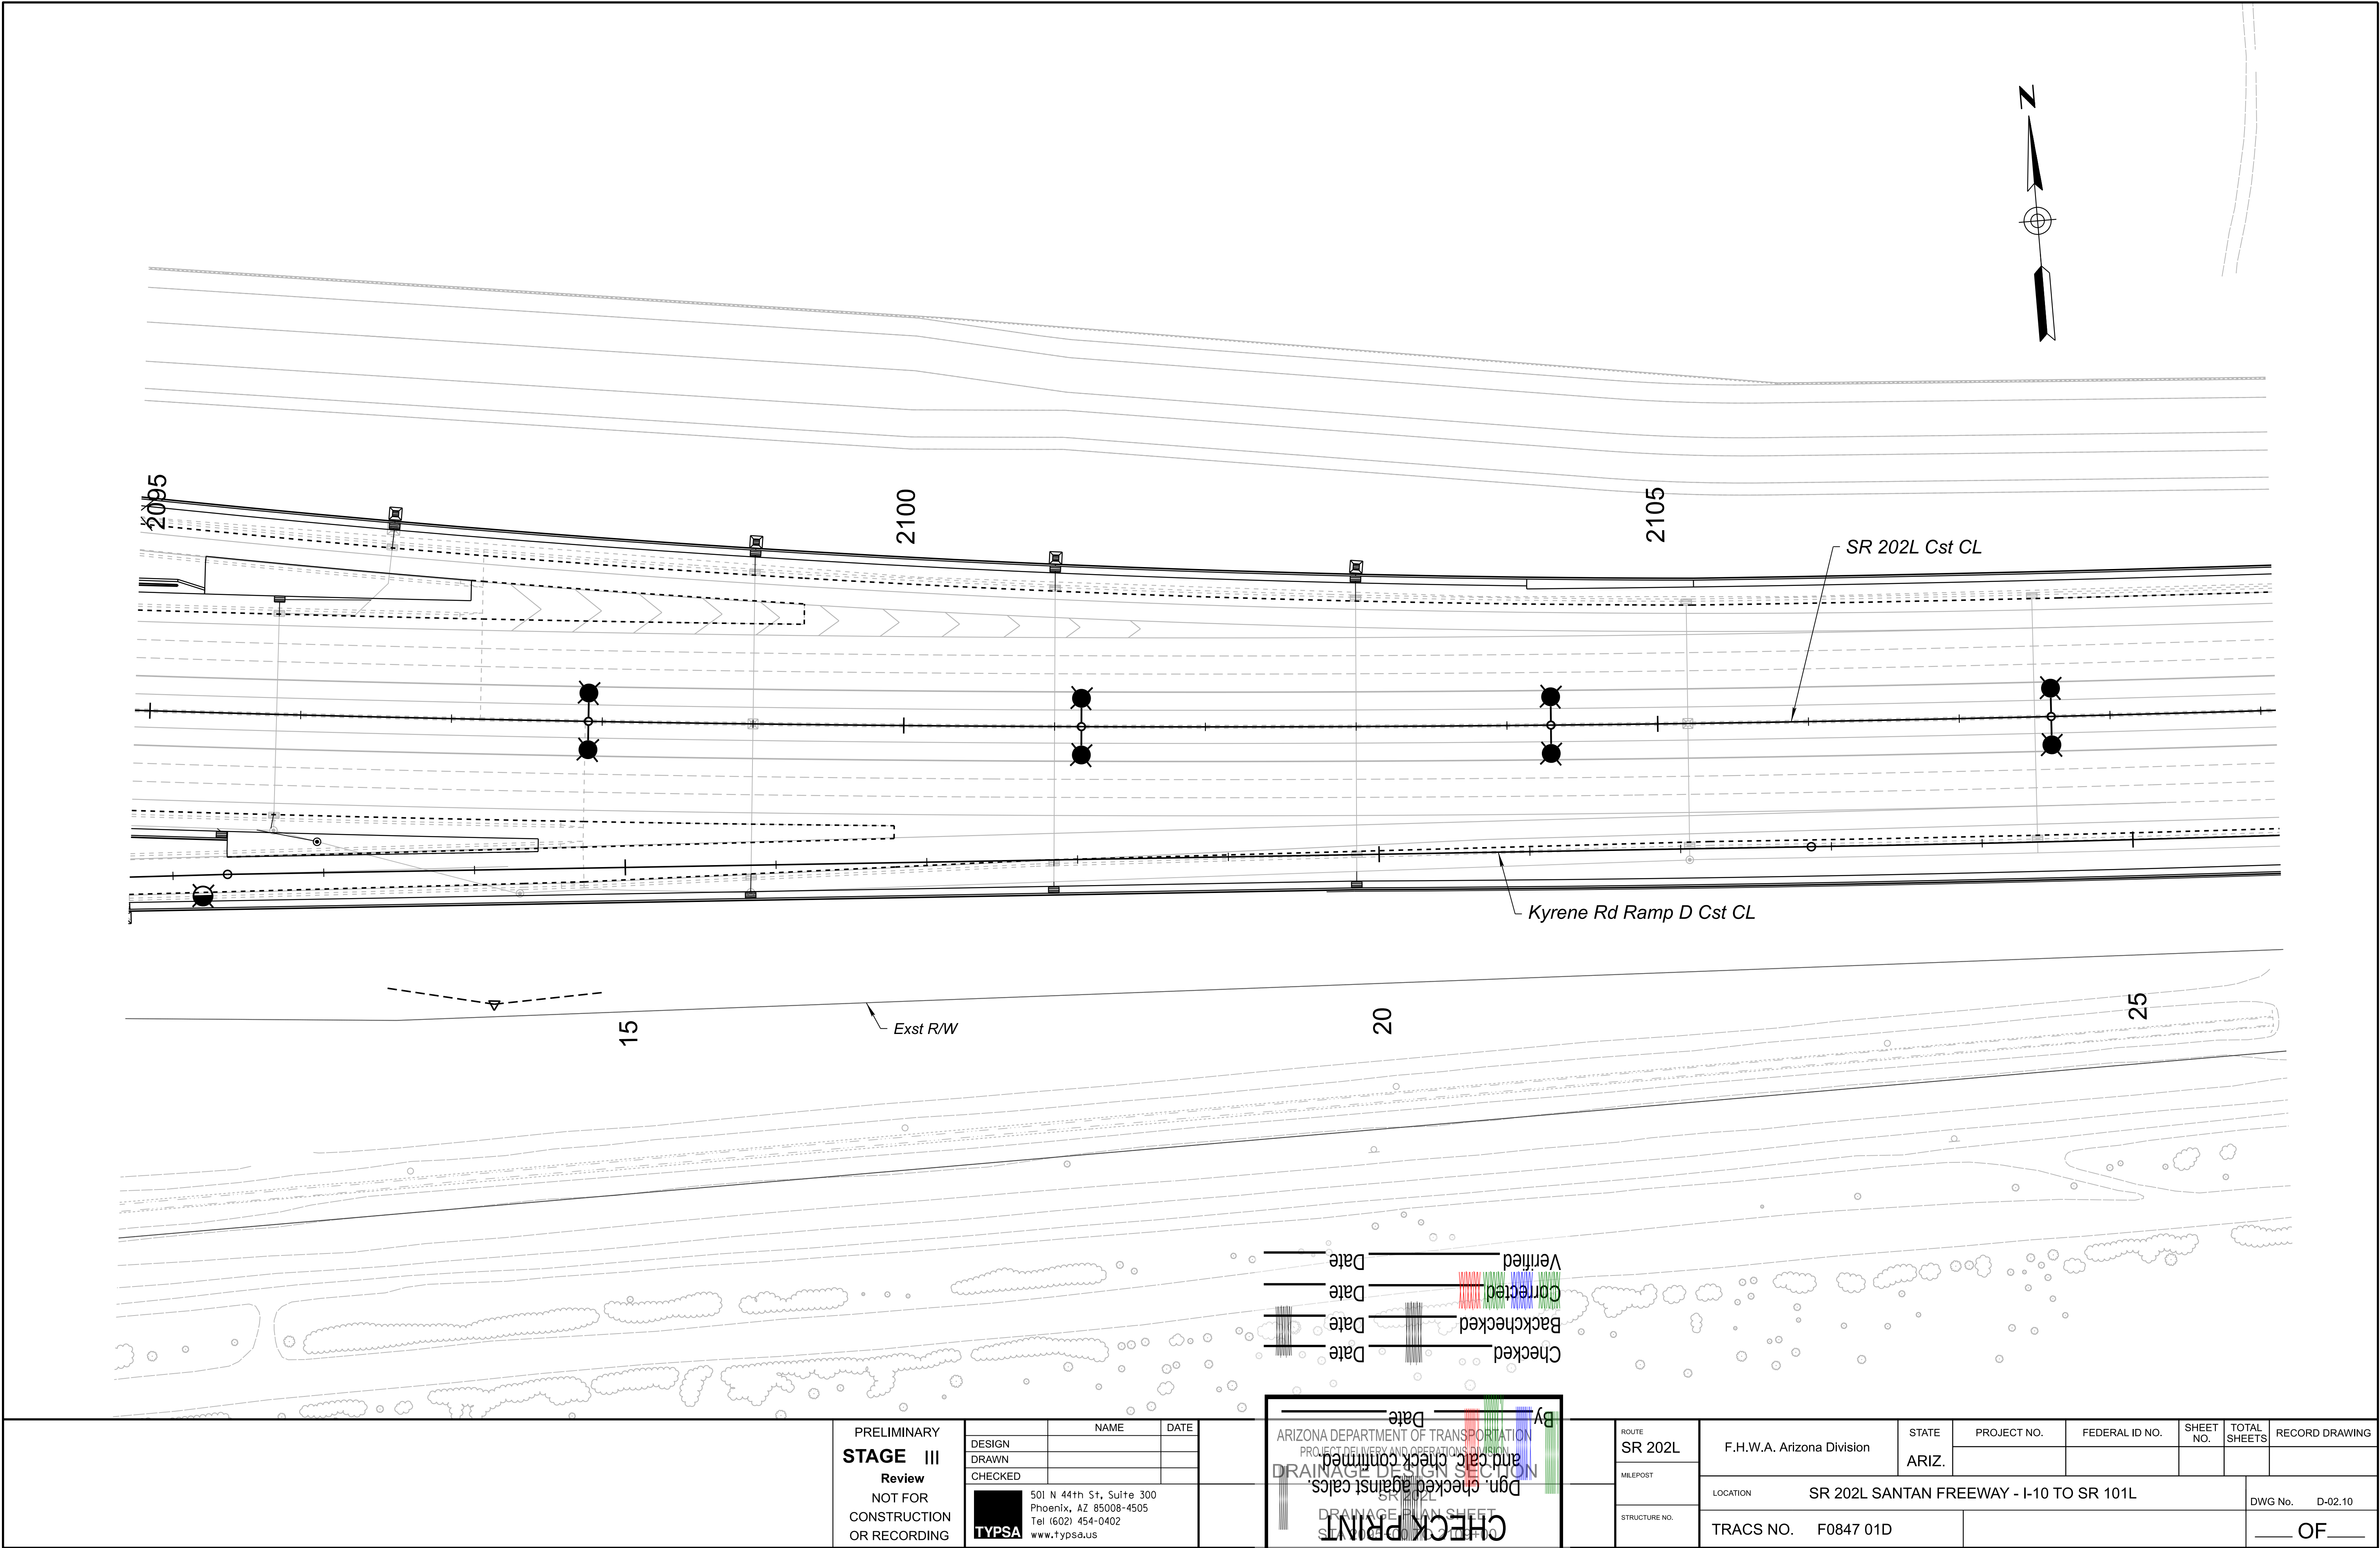 


Checked
Date
Backchecked
Date
Corrected
Date
Verified
Date

By
Date

ARIZONA DEPARTMENT OF TRANSPORTATION
PROJECT DELIVERY AND OPERATIONS DIVISION
DRAINAGE DESIGN SECTION
Dgn. checked against calcs.
and calc. check confirmed

DRAINAGE DESIGN SECTION
CHECK PRINT
No.
Date

PRELIMINARY STAGE III Review NOT FOR CONSTRUCTION OR RECORDING	DESIGN	NAME	DATE	ARIZONA DEPARTMENT OF TRANSPORTATION PROJECT DELIVERY AND OPERATIONS DIVISION DRAINAGE DESIGN SECTION SR 202L Dgn. checked against calcs and calc. check confirmed DRAINAGE PUMP SHEET SR 202L CHECK PRINT	ROUTE	F.H.W.A. Arizona Division	STATE	PROJECT NO.	FEDERAL ID NO.	SHEET NO.	TOTAL SHEETS	RECORD DRAWING
	DRAWN				MILEPOST		ARIZ.					
	CHECKED				STRUCTURE NO.	LOCATION SR 202L SANTAN FREEWAY - I-10 TO SR 101L						
	 501 N 44th St, Suite 300 Phoenix, AZ 85008-4505 Tel (602) 454-0402 www.typsas.us					DWG No. D-02.10						
							TRACS NO. F0847 01D					
____ OF ____												