


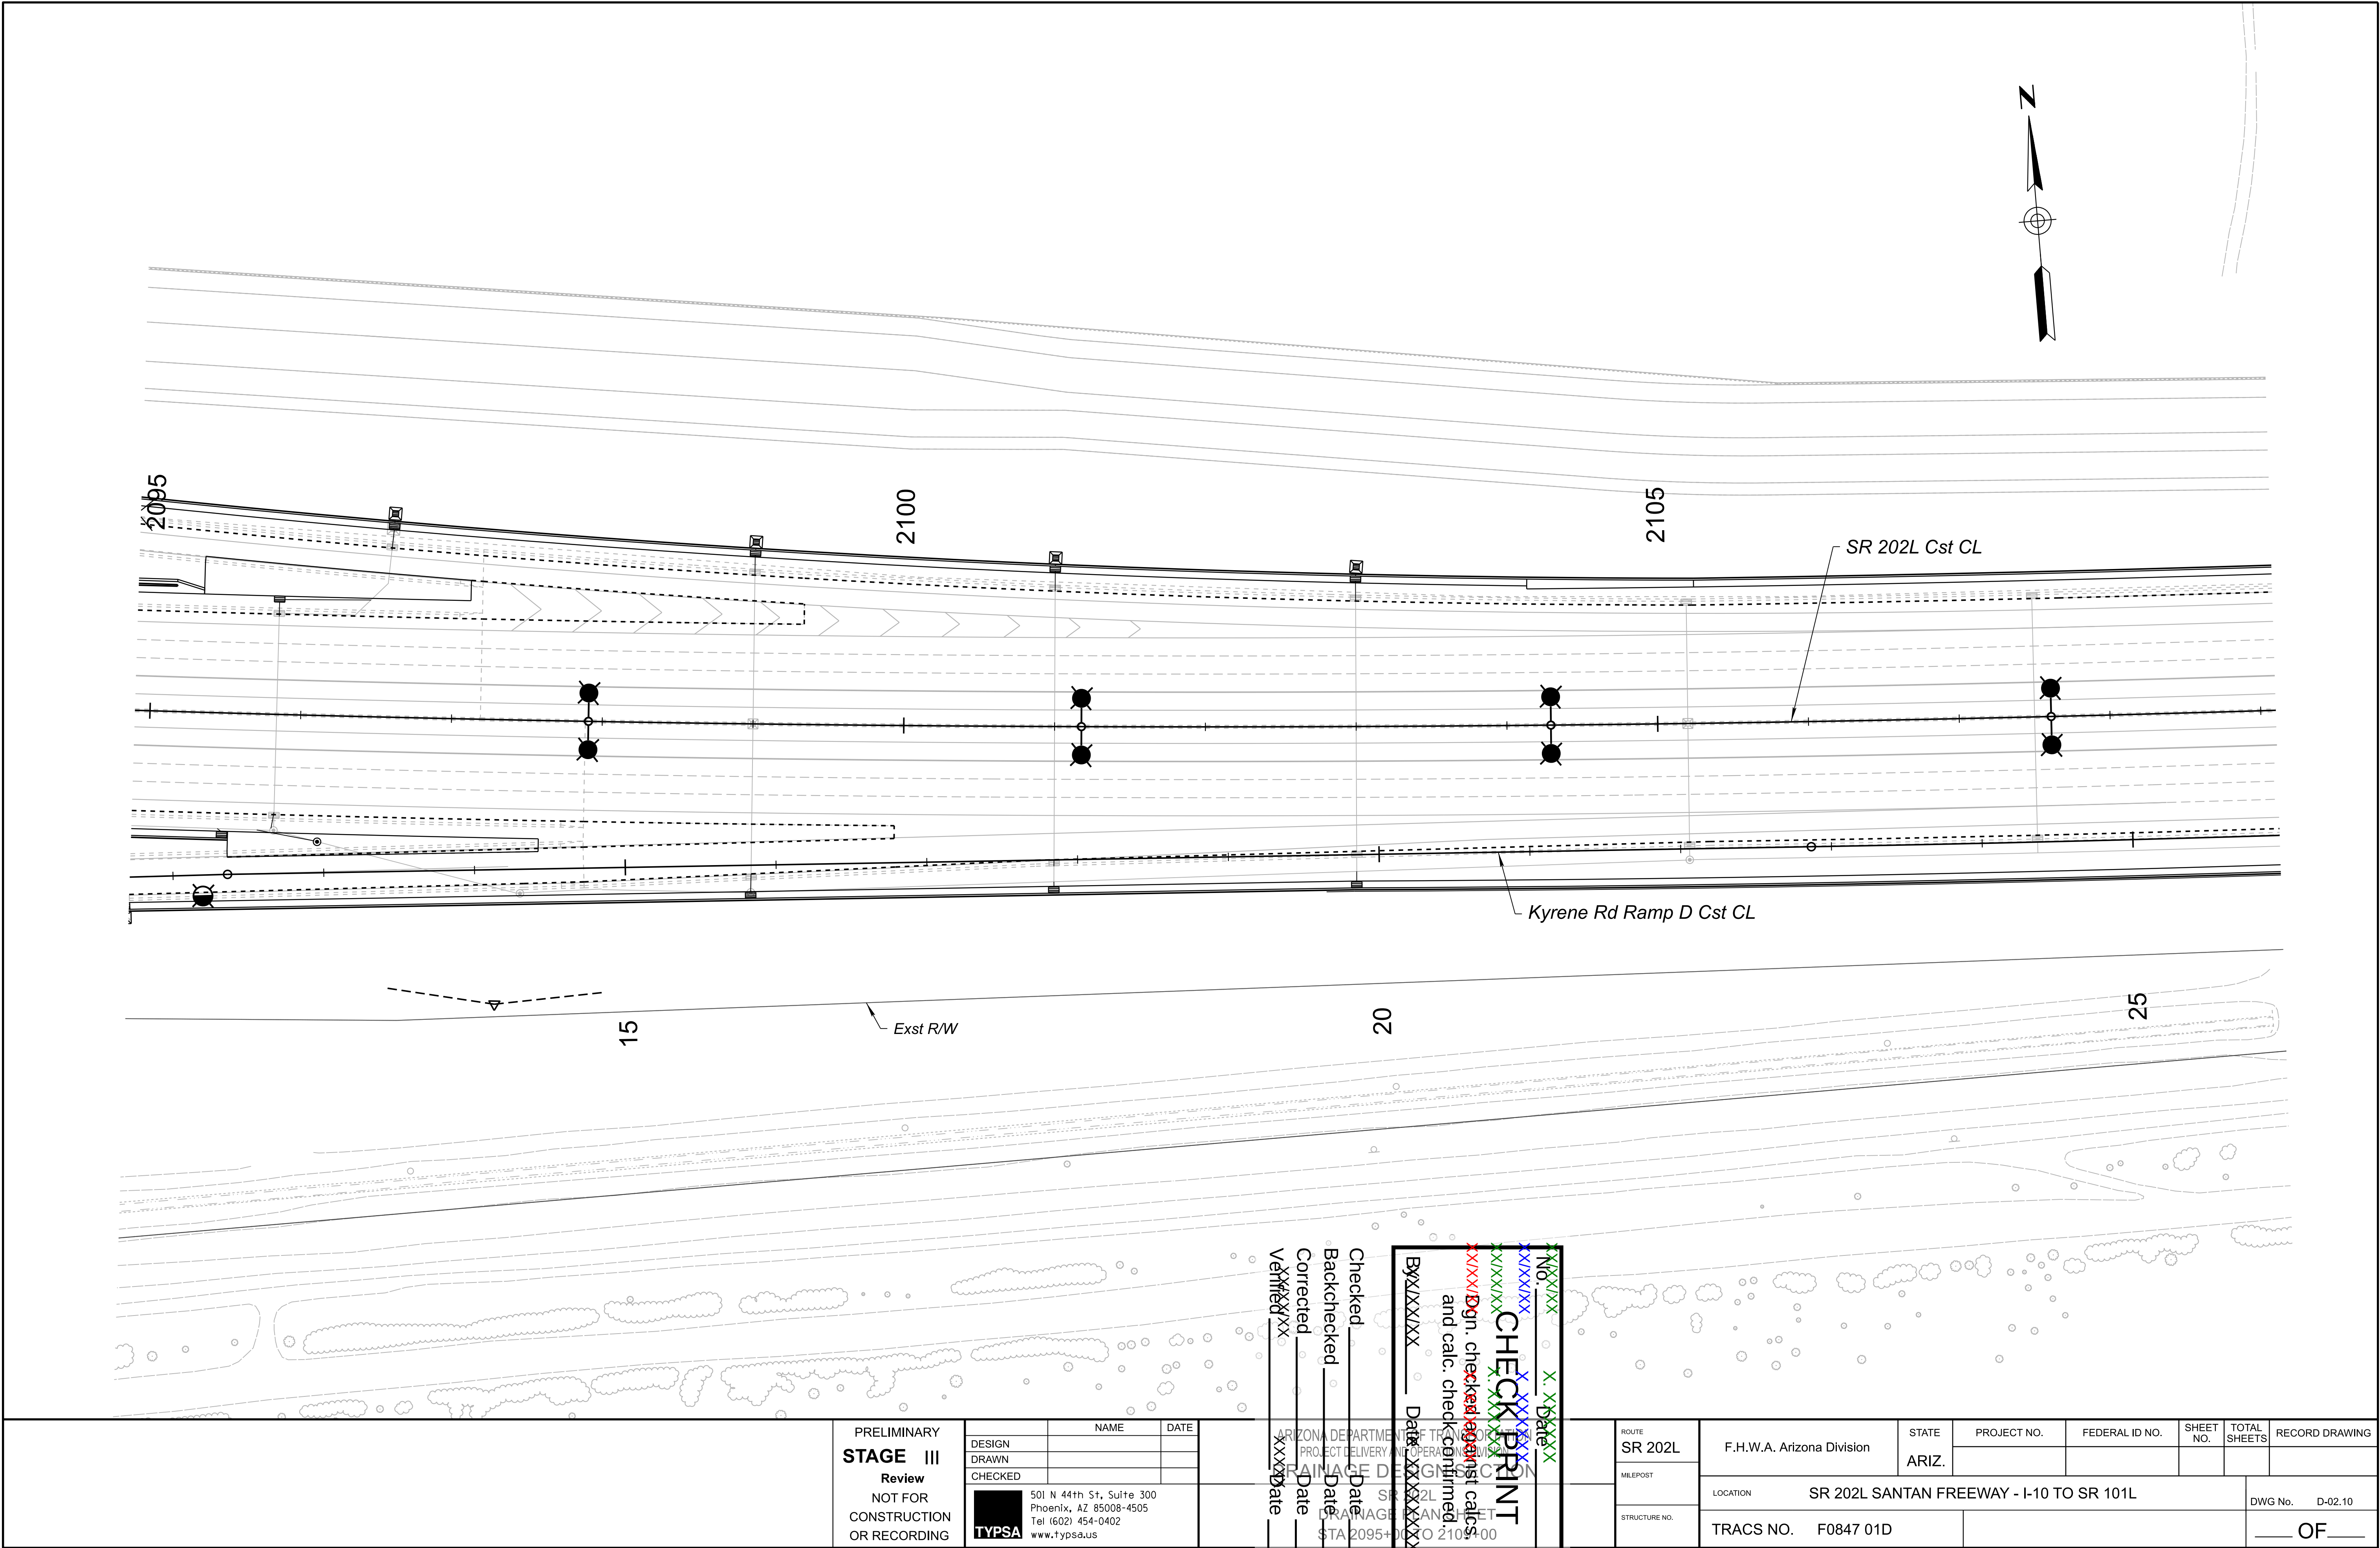

PRELIMINARY STAGE III Review NOT FOR CONSTRUCTION OR RECORDING	DESIGN	NAME	DATE	ARIZONA DEPARTMENT OF TRANSPORTATION PROJECT DELIVERY AND OPERATIONS DIVISION DRAINAGE DESIGN SECTION SR 202L SANTAN FREEWAY - I-10 TO SR 101L DRAINAGE PLAN SHEET STA 2095+00 TO 2105+00	ROUTE	SR 202L	F.H.W.A. Arizona Division	STATE	ARIZ.	PROJECT NO.	FEDERAL ID NO.	SHEET NO.	TOTAL SHEETS	RECORD DRAWING
	DRAWN				MILEPOST		LOCATION	SR 202L SANTAN FREEWAY - I-10 TO SR 101L				DWG No. D-02.10		
	CHECKED				STRUCTURE NO.		TRACS NO.	F0847 01D				OF		

501 N 44th St, Suite 300
Phoenix, AZ 85008-4505
Tel (602) 454-0402
www.typpsa.us

TYPPSA