


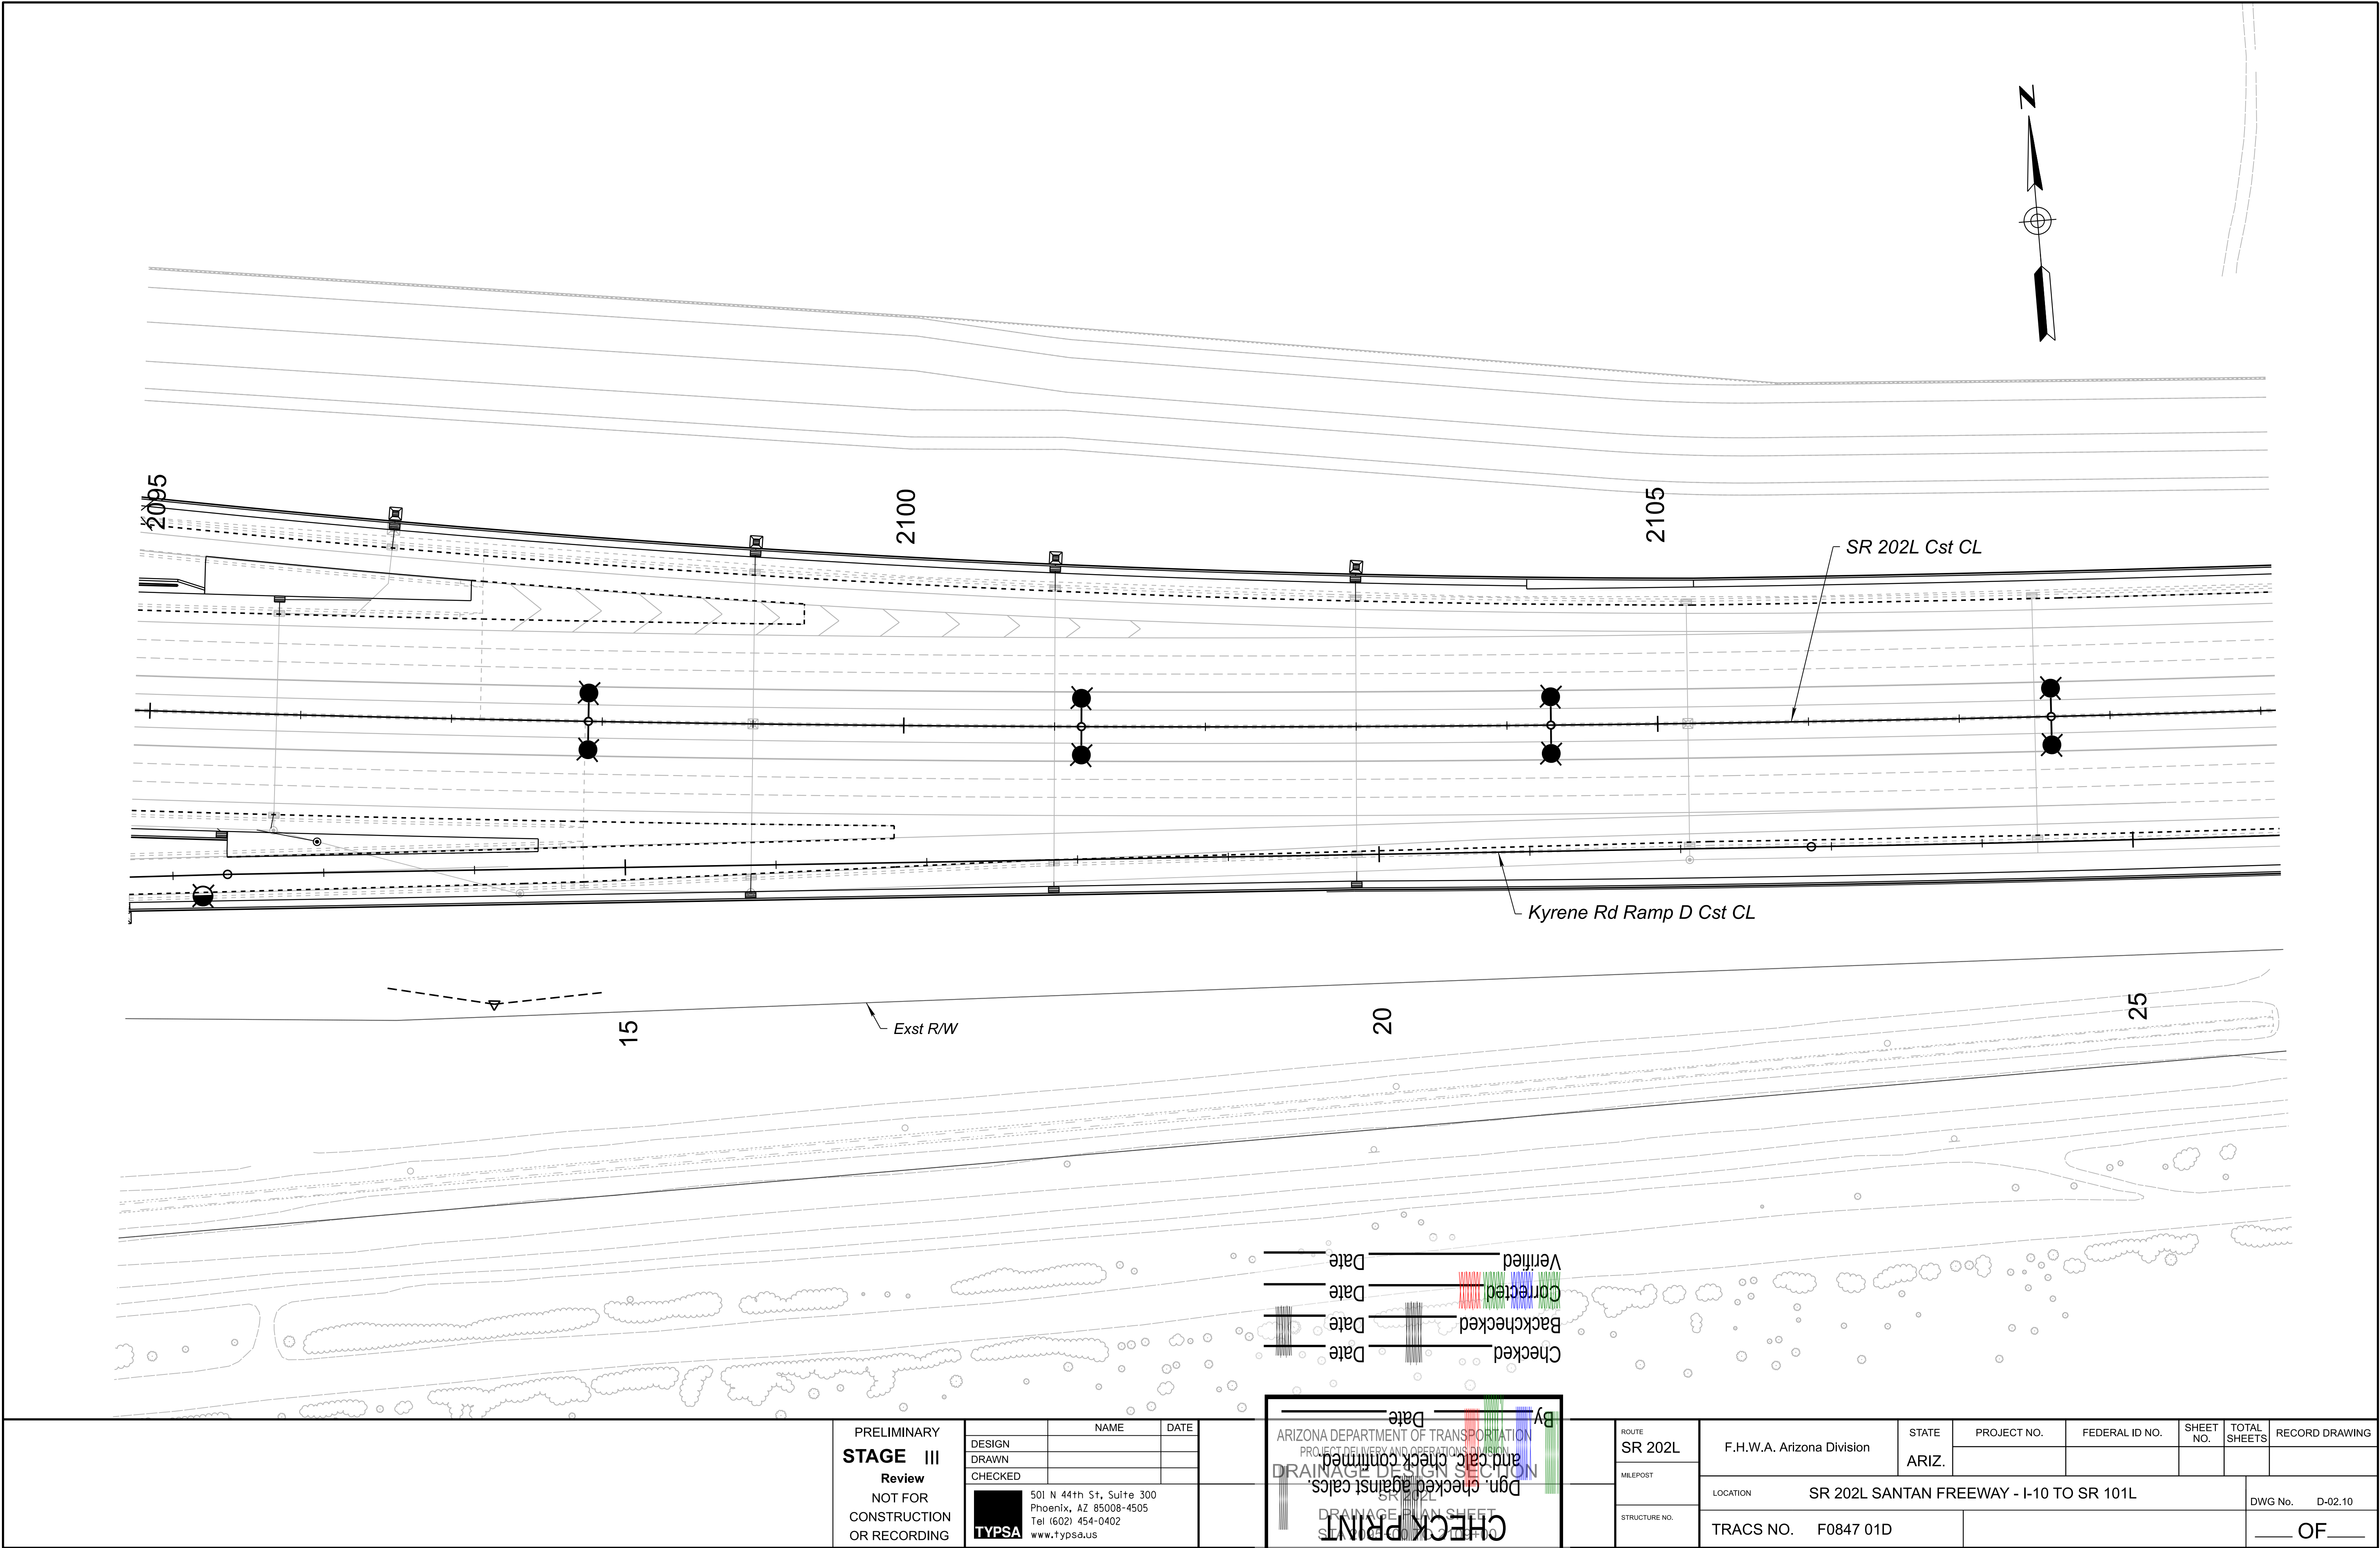

Checked
Date _____
Backchecked
Date _____
Corrected
Date _____
Verified
Date _____

By _____ Date _____

ARIZONA DEPARTMENT OF TRANSPORTATION
PROJECT DELIVERY AND OPERATIONS DIVISION
DRAINAGE DESIGN SECTION

Dgn. checked against calcs.
and calc. check confirmed

CHECK PRINT
DRAINAGE MAIN SHEET
SR 202L

No. _____ Date _____

PRELIMINARY STAGE III Review NOT FOR CONSTRUCTION OR RECORDING	DESIGN	NAME	DATE	ROUTE SR 202L	F.H.W.A. Arizona Division	STATE ARIZ.	PROJECT NO.	FEDERAL ID NO.	SHEET NO.	TOTAL SHEETS	RECORD DRAWING	
	DRAWN											
	CHECKED											
	501 N 44th St, Suite 300 Phoenix, AZ 85008-4505 Tel (602) 454-0402 www.typpsa.us											
TYPSA							LOCATION SR 202L SANTAN FREEWAY - I-10 TO SR 101L				DWG No. D-02.10	
							TRACS NO. F0847 01D				____ OF ____	