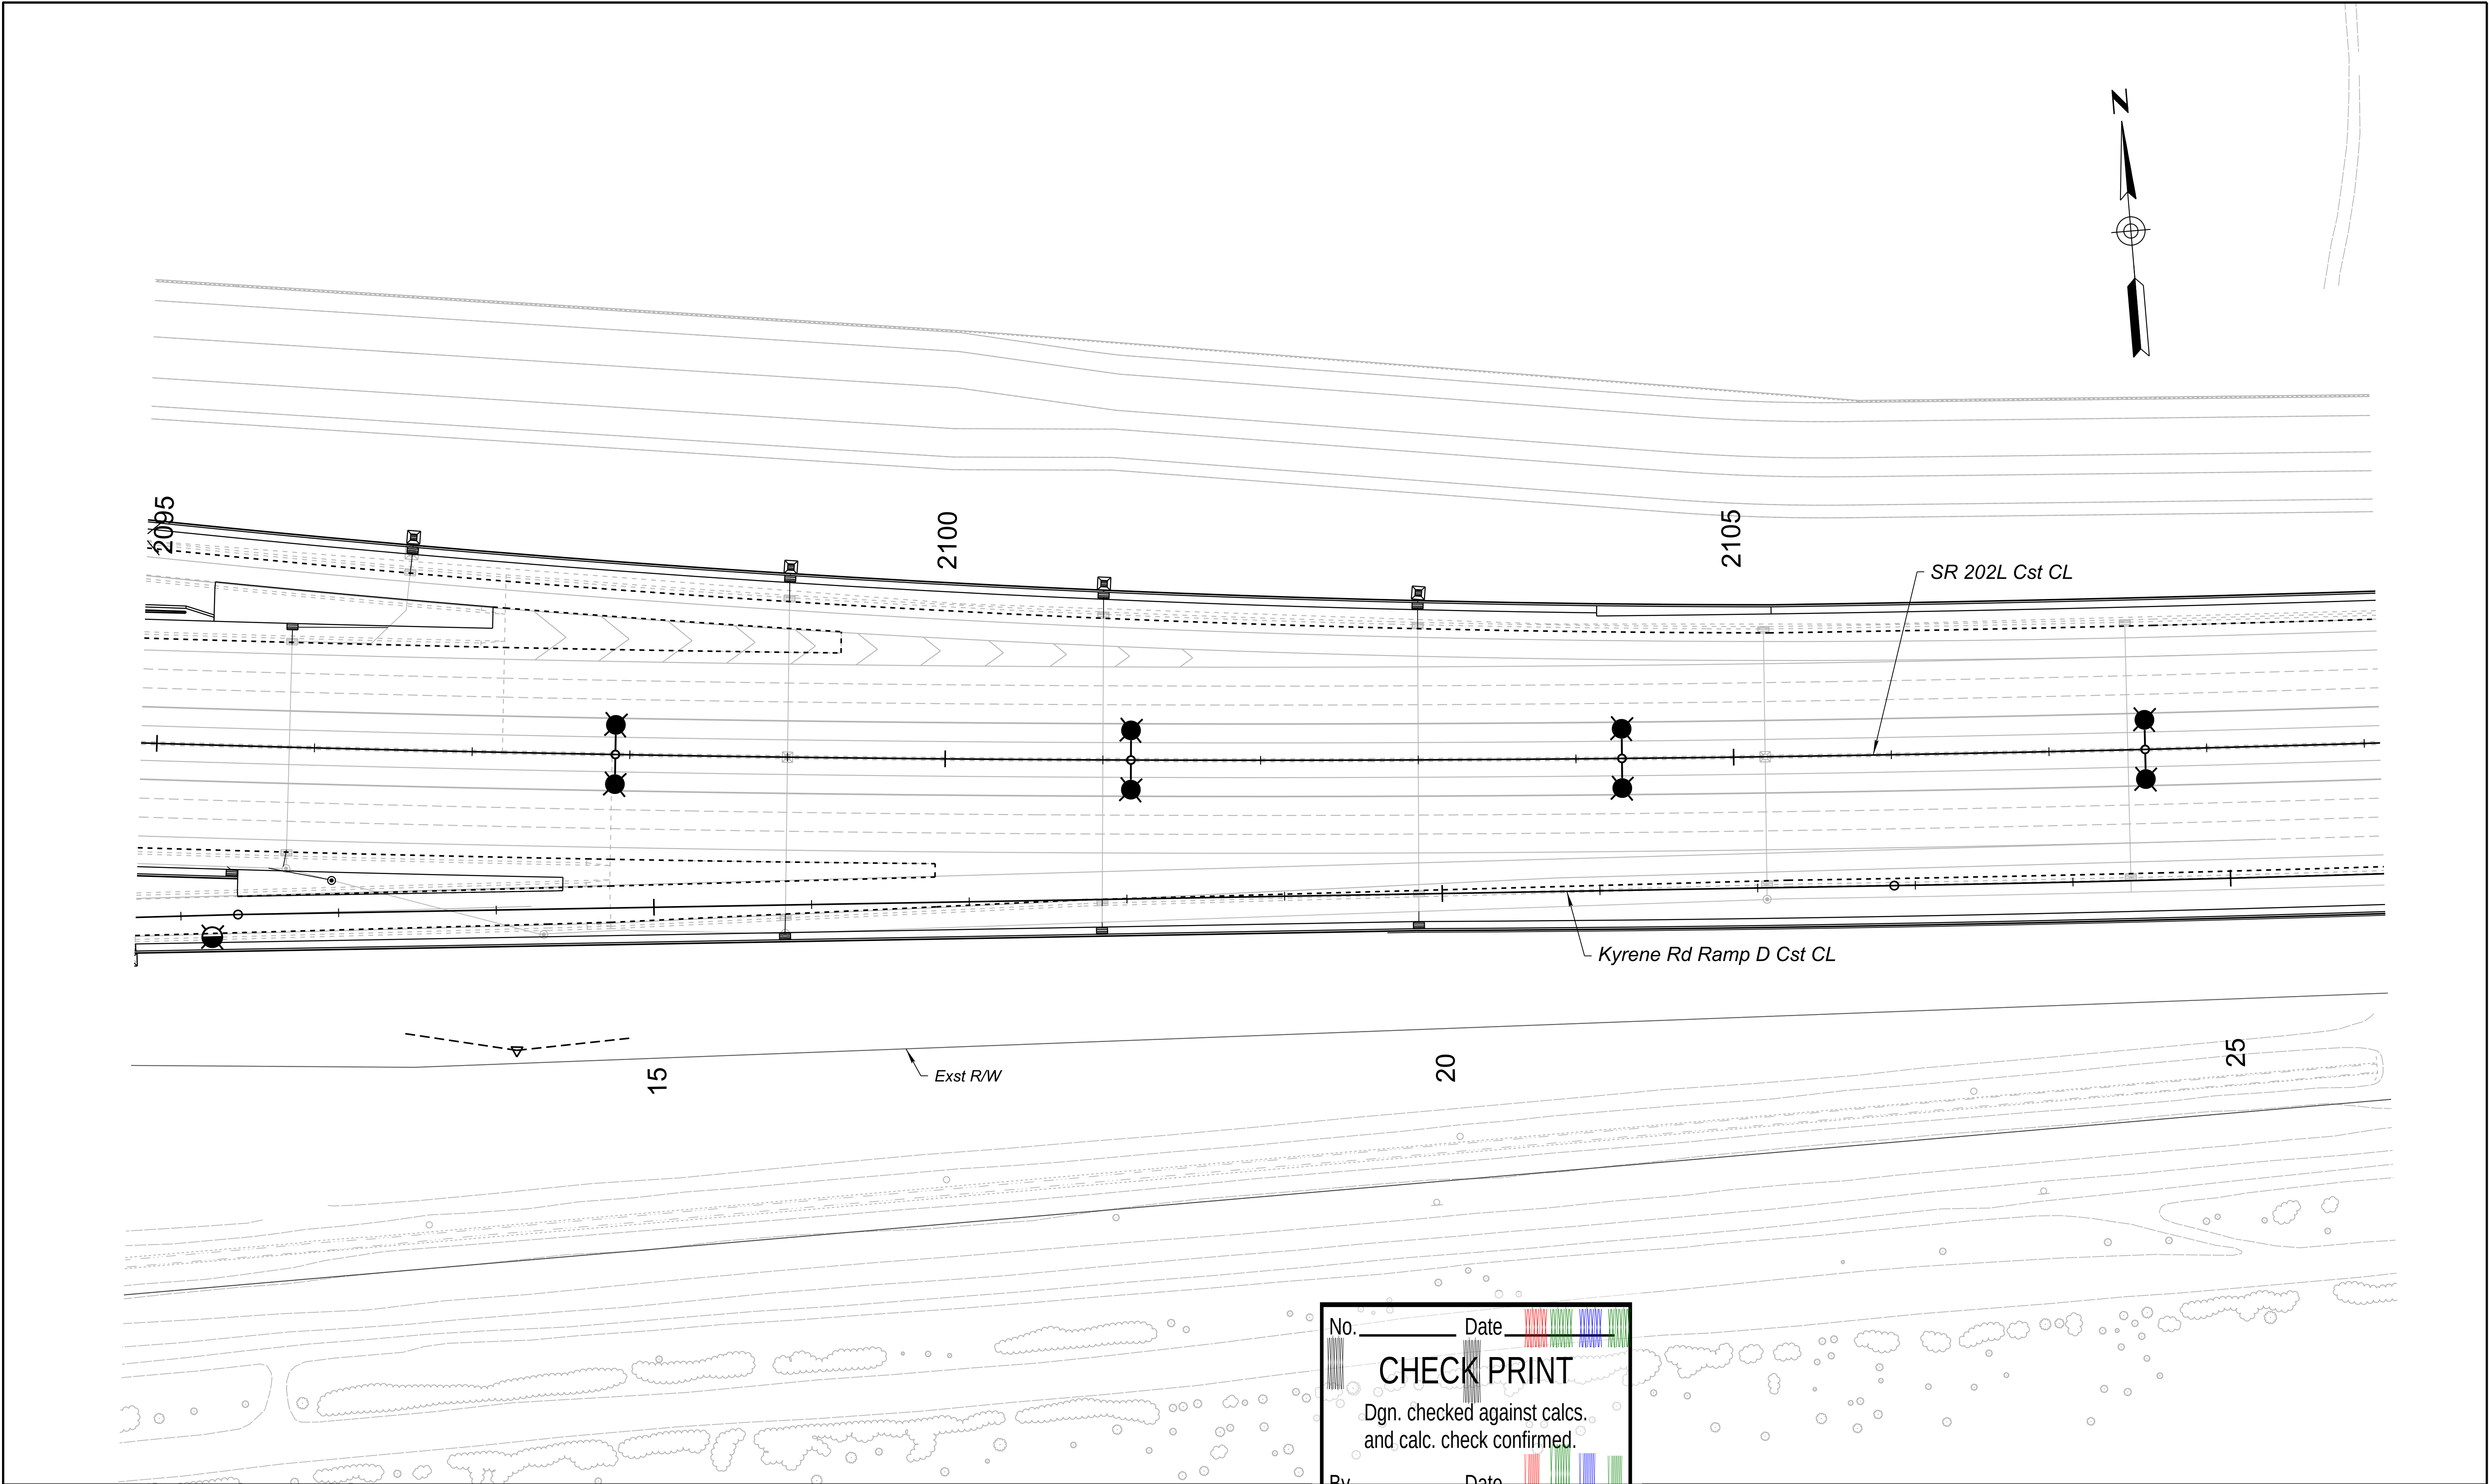


No. _____ Date _____

CHECK PRINT

Dgn. checked against calcs.
and calc. check confirmed.

By _____ Date _____

PRELIMINARY STAGE III Review NOT FOR CONSTRUCTION OR RECORDING	DESIGN	NAME	DATE	501 N 44th St, Suite 300 Phoenix, AZ 85008-4505 Tel (602) 454-0402 www.typpsa.us	ROUTE	F.H.W.A. Arizona Division	STATE	PROJECT NO.	FEDERAL ID NO.	SHEET NO.	TOTAL SHEETS	RECORD DRAWING
	DRAWN				SR 202L		ARIZ.					
	CHECKED					LOCATION SR 202L SANTAN FREEWAY - I-10 TO SR 101L						
	TYPSA					STRUCTURE NO.	TRACS NO. F0847 01D					DWG No. D-02.10
											OF	