


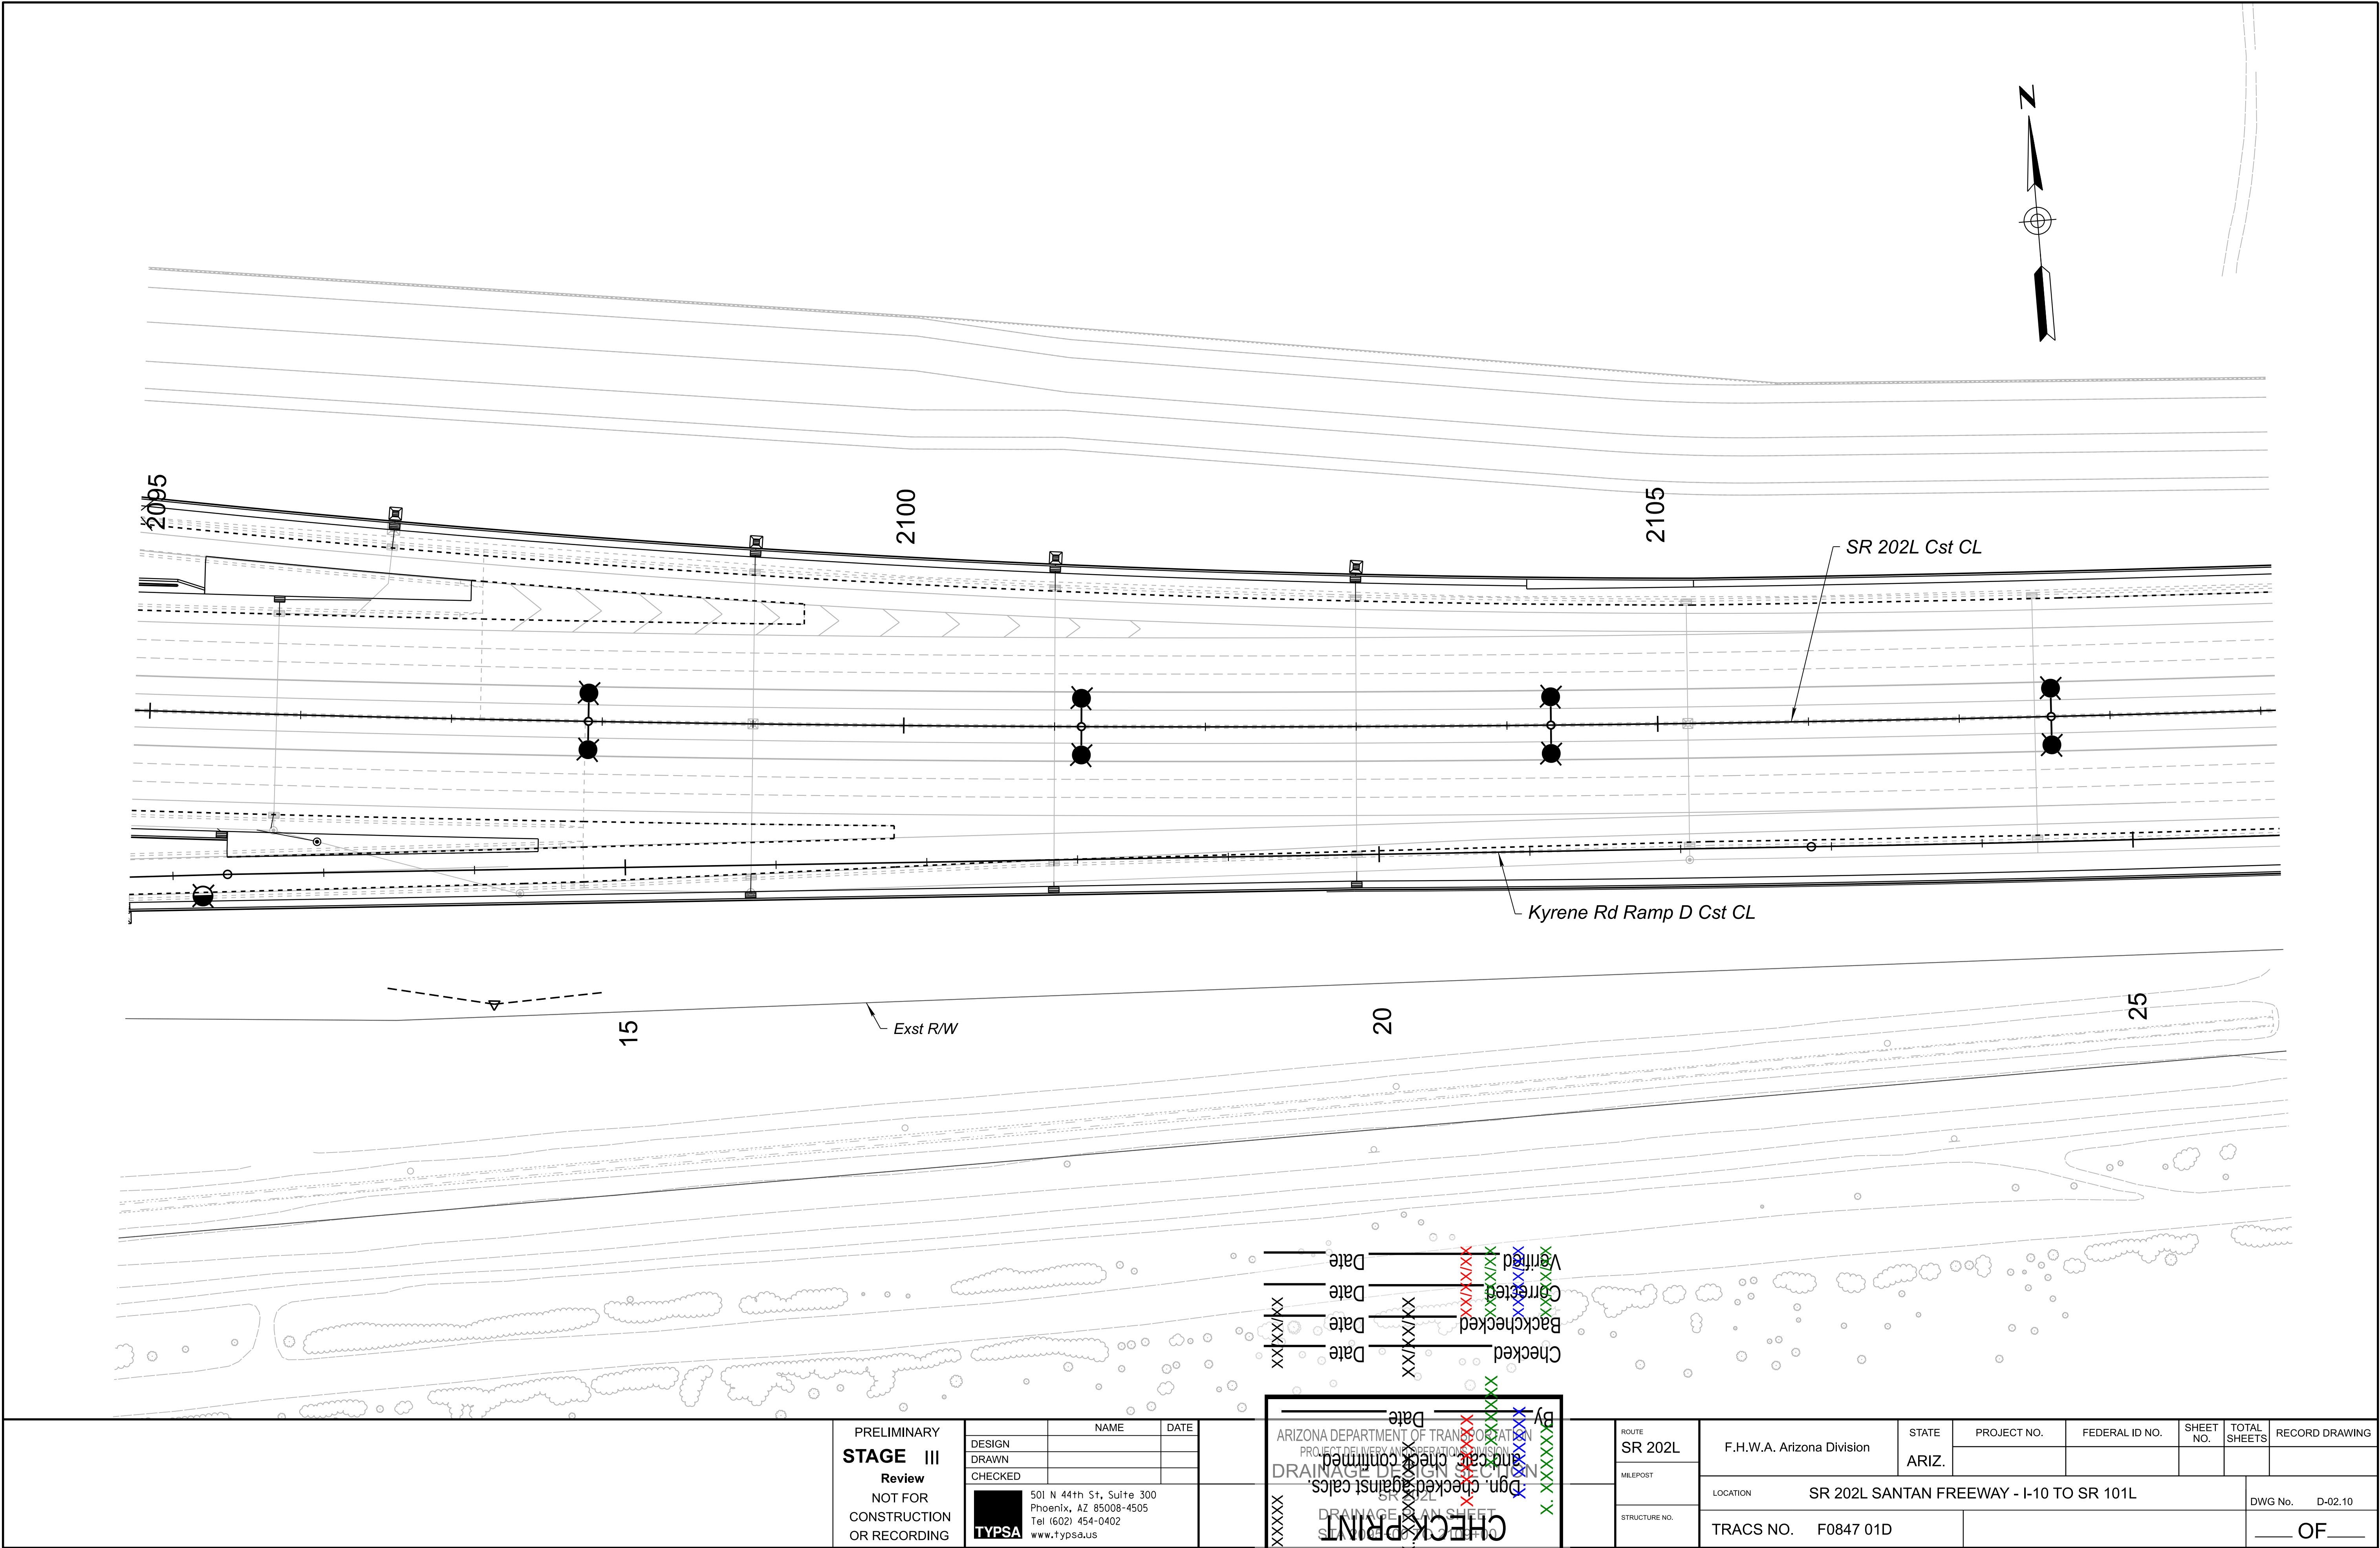

PRELIMINARY STAGE III Review NOT FOR CONSTRUCTION OR RECORDING	DESIGN	NAME	DATE	ARIZONA DEPARTMENT OF TRANSPORTATION PROJECT DELIVERY AND OPERATIONS DIVISION DRAINAGE DESIGN SECTION DRAINAGE PLAN SHEET SR 202L No. _____ Date _____ Checked _____ Date _____ Backchecked _____ Date _____ Corrected _____ Date _____ Verified _____ Date _____					
	DRAWN								
	CHECKED								
	TYP SA 501 N 44th St, Suite 300 Phoenix, AZ 85008-4505 Tel (602) 454-0402 www.typpsa.us								
ROUTE SR 202L		F.H.W.A. Arizona Division		STATE ARIZ.	PROJECT NO.	FEDERAL ID NO.	SHEET NO.	TOTAL SHEETS	RECORD DRAWING
MILEPOST		LOCATION SR 202L SANTAN FREEWAY - I-10 TO SR 101L							
STRUCTURE NO.		TRACS NO. F0847 01D							
		DWG No. D-02.10 ____ OF ____							