


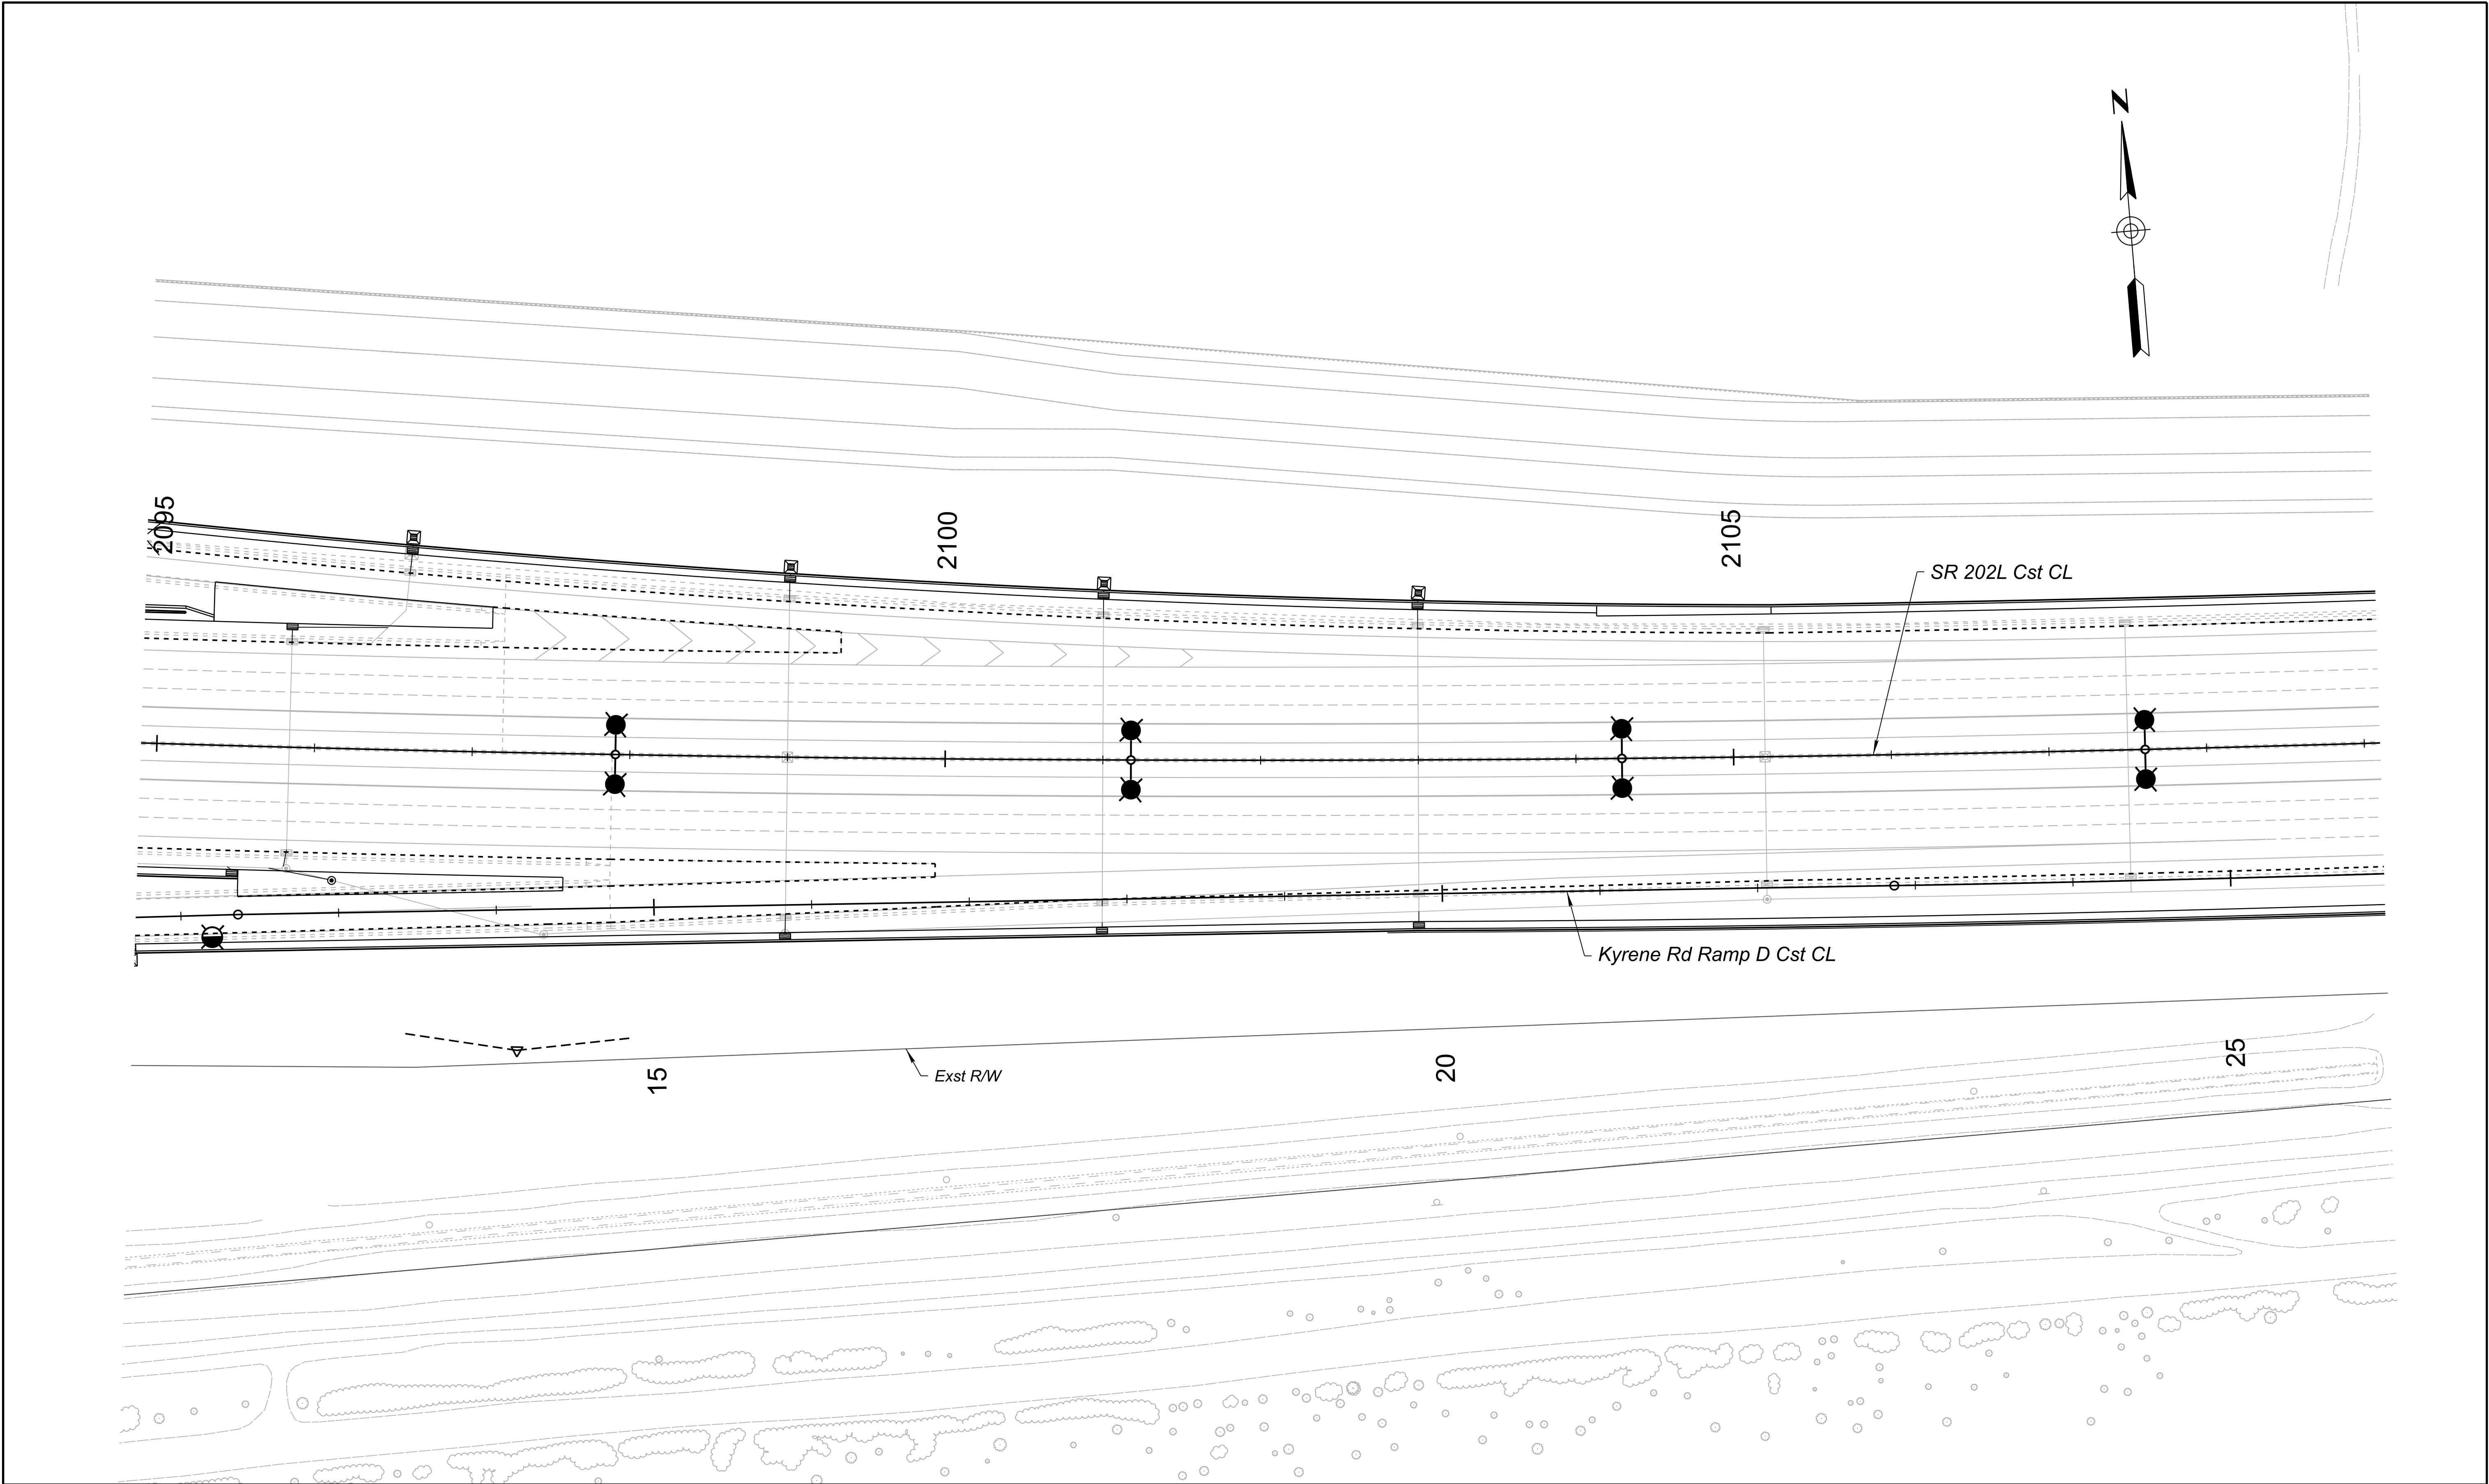

	PRELIMINARY STAGE III Review NOT FOR CONSTRUCTION OR RECORDING		NAME	DATE	ARIZONA DEPARTMENT OF TRANSPORTATION PROJECT DELIVERY AND OPERATIONS DIVISION DRAINAGE DESIGN SECTION	ROUTE	F.H.W.A. Arizona Division	STATE ARIZ.	PROJECT NO.	FEDERAL ID NO.	SHEET NO.	TOTAL SHEETS	RECORD DRAWING		
		DESIGN				SR 202L			LOCATION	SR 202L SANTAN FREEWAY - I-10 TO SR 101L				DWG No. D-02.10	
		DRAWN													
		CHECKED													
		 501 N 44th St, Suite 300 Phoenix, AZ 85008-4505 Tel (602) 454-0402 www.typsas.us	SR 202L DRAINAGE PLAN SHEET STA 2095+00 TO 2109+00				TRACS NO. F0847 01D							____ OF ____	