


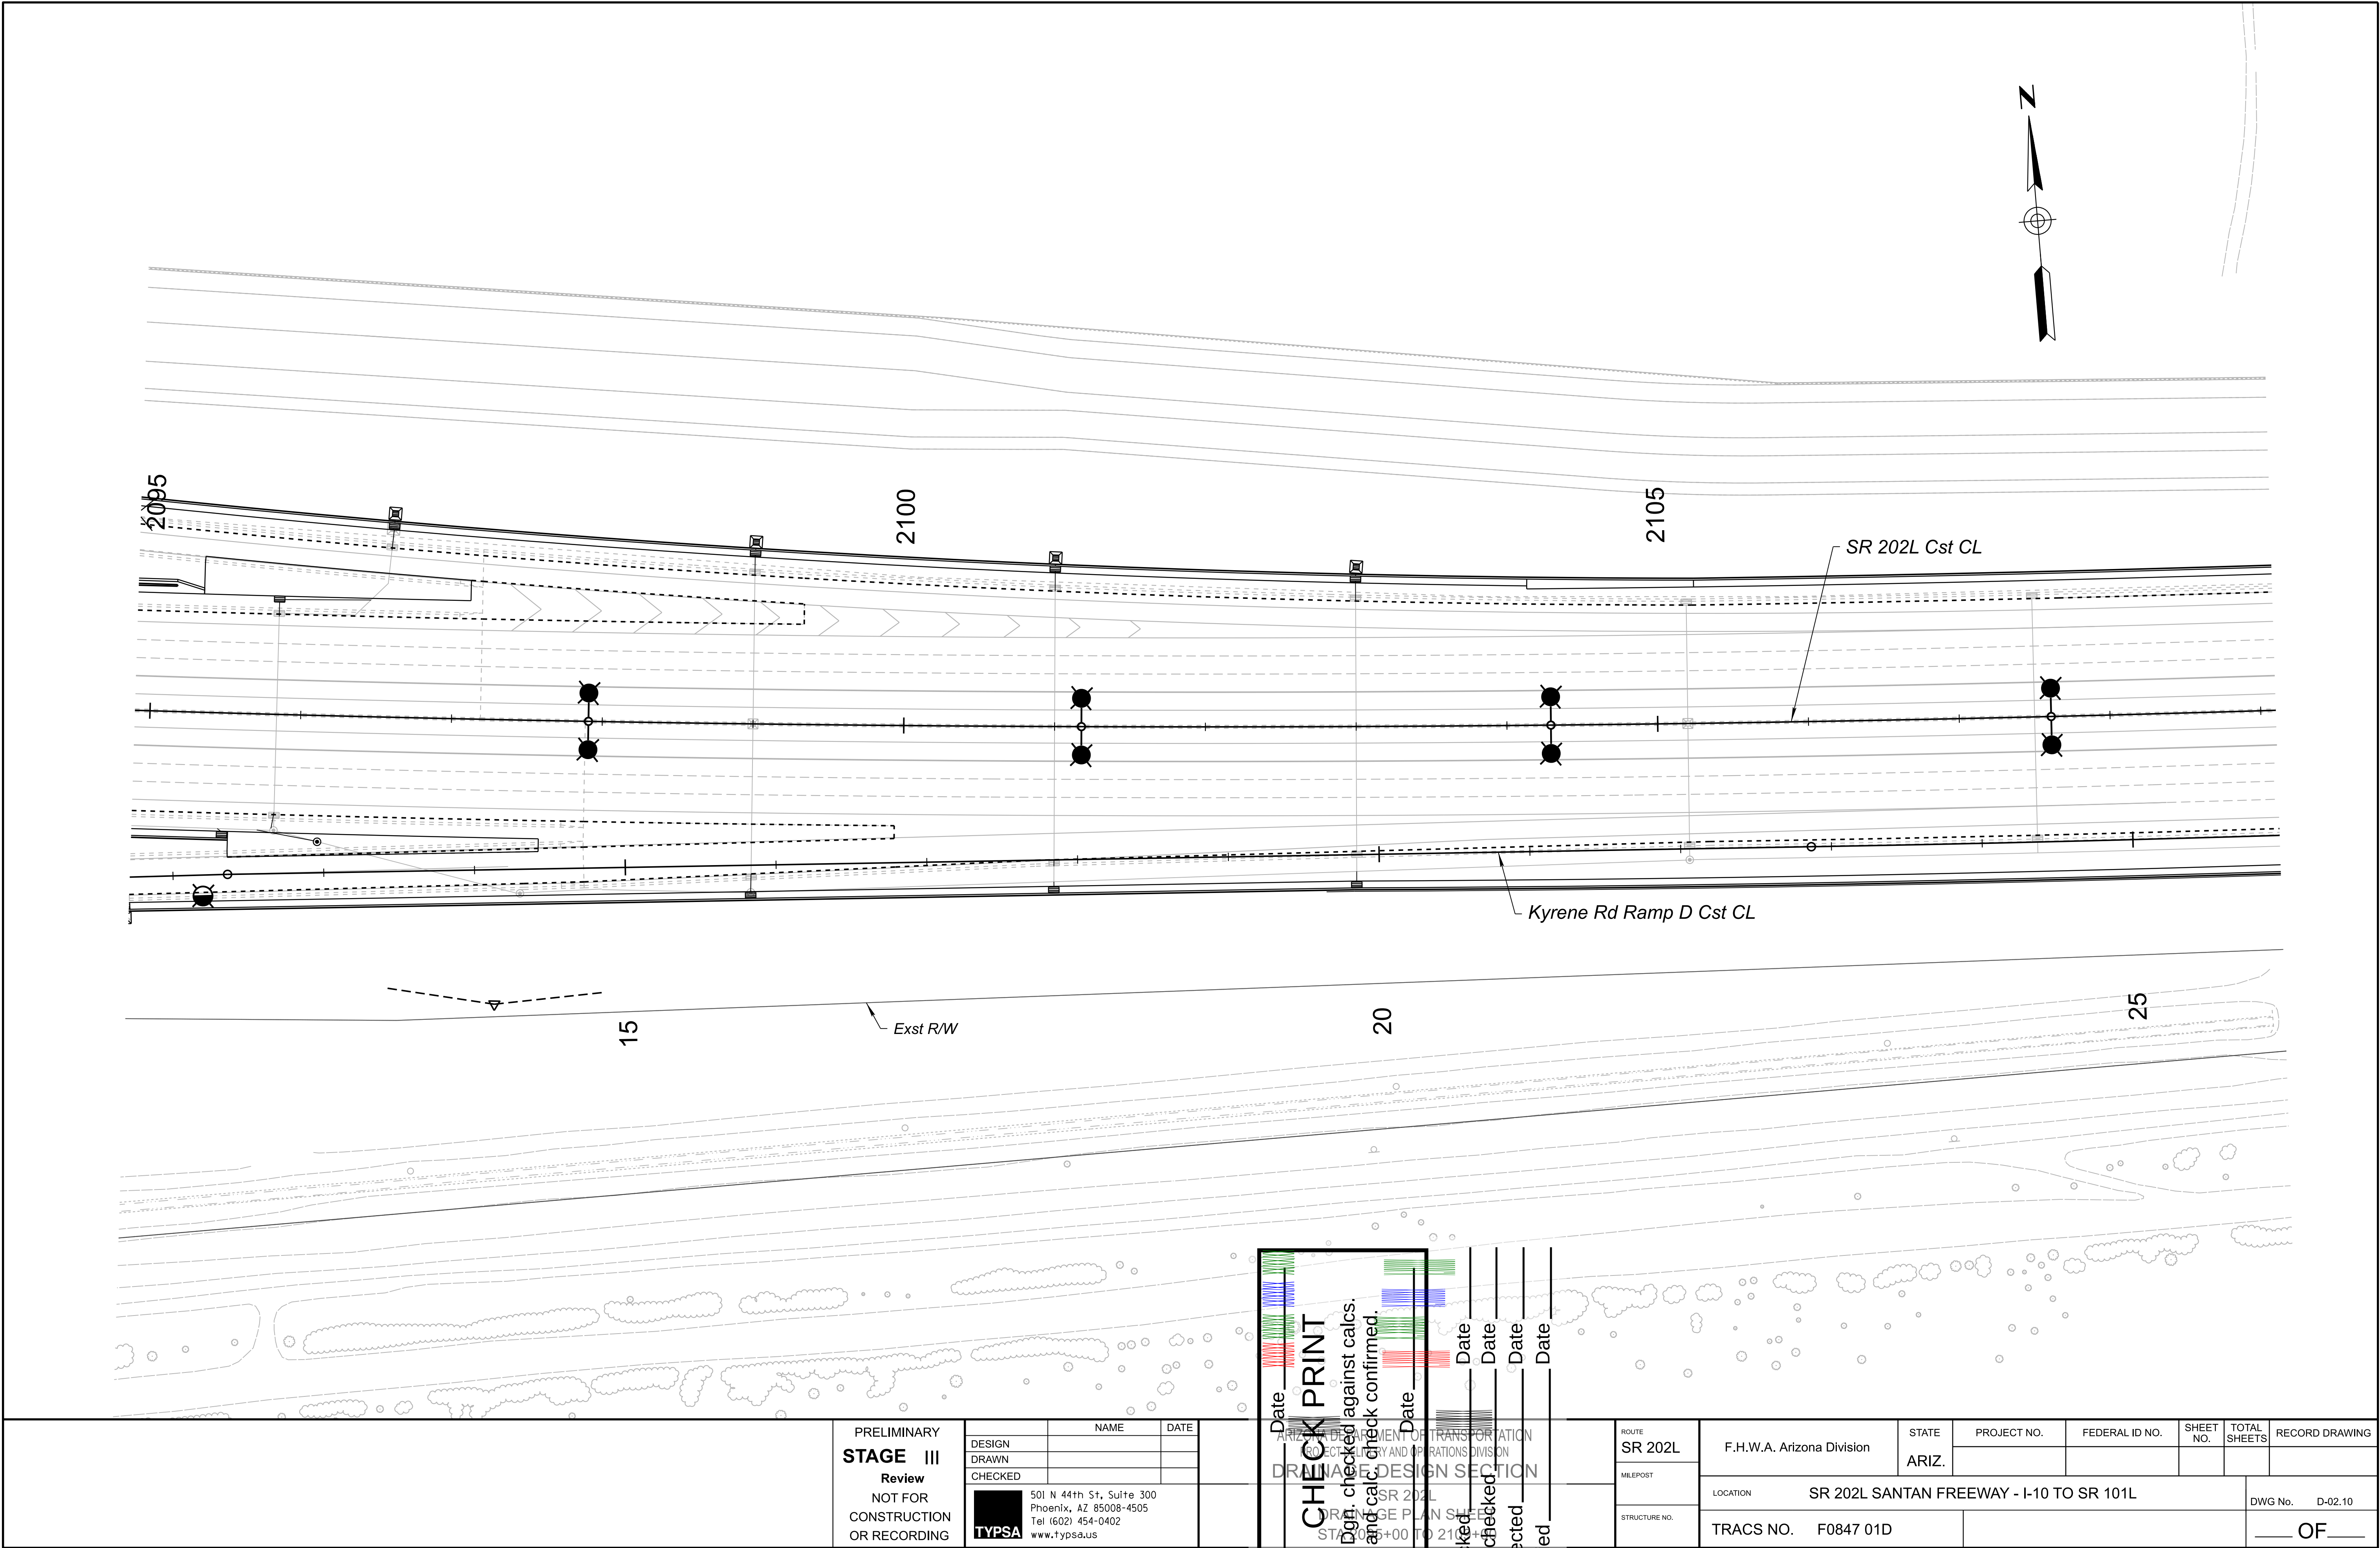

PRELIMINARY STAGE III Review NOT FOR CONSTRUCTION OR RECORDING	DESIGN	NAME	DATE	ROUTE SR 202L MILEPOST STRUCTURE NO.	STATE	PROJECT NO.	FEDERAL ID NO.	SHEET NO.	TOTAL SHEETS	RECORD DRAWING	
	DRAWN				F.H.W.A. Arizona Division	ARIZ.					
	CHECKED					LOCATION	SR 202L SANTAN FREEWAY - I-10 TO SR 101L				DWG No. D-02.10
	501 N 44th St, Suite 300 Phoenix, AZ 85008-4505 Tel (602) 454-0402 www.typsas.us	TRACS NO.	F0847 01D				OF				

No. _____

By _____

Checked _____

Backchecked _____

Corrected _____

Verified _____

Date _____

Date _____

Date _____

Date _____

CHECK PRINT

Don't check against calcs.
and calc check confirmed.