


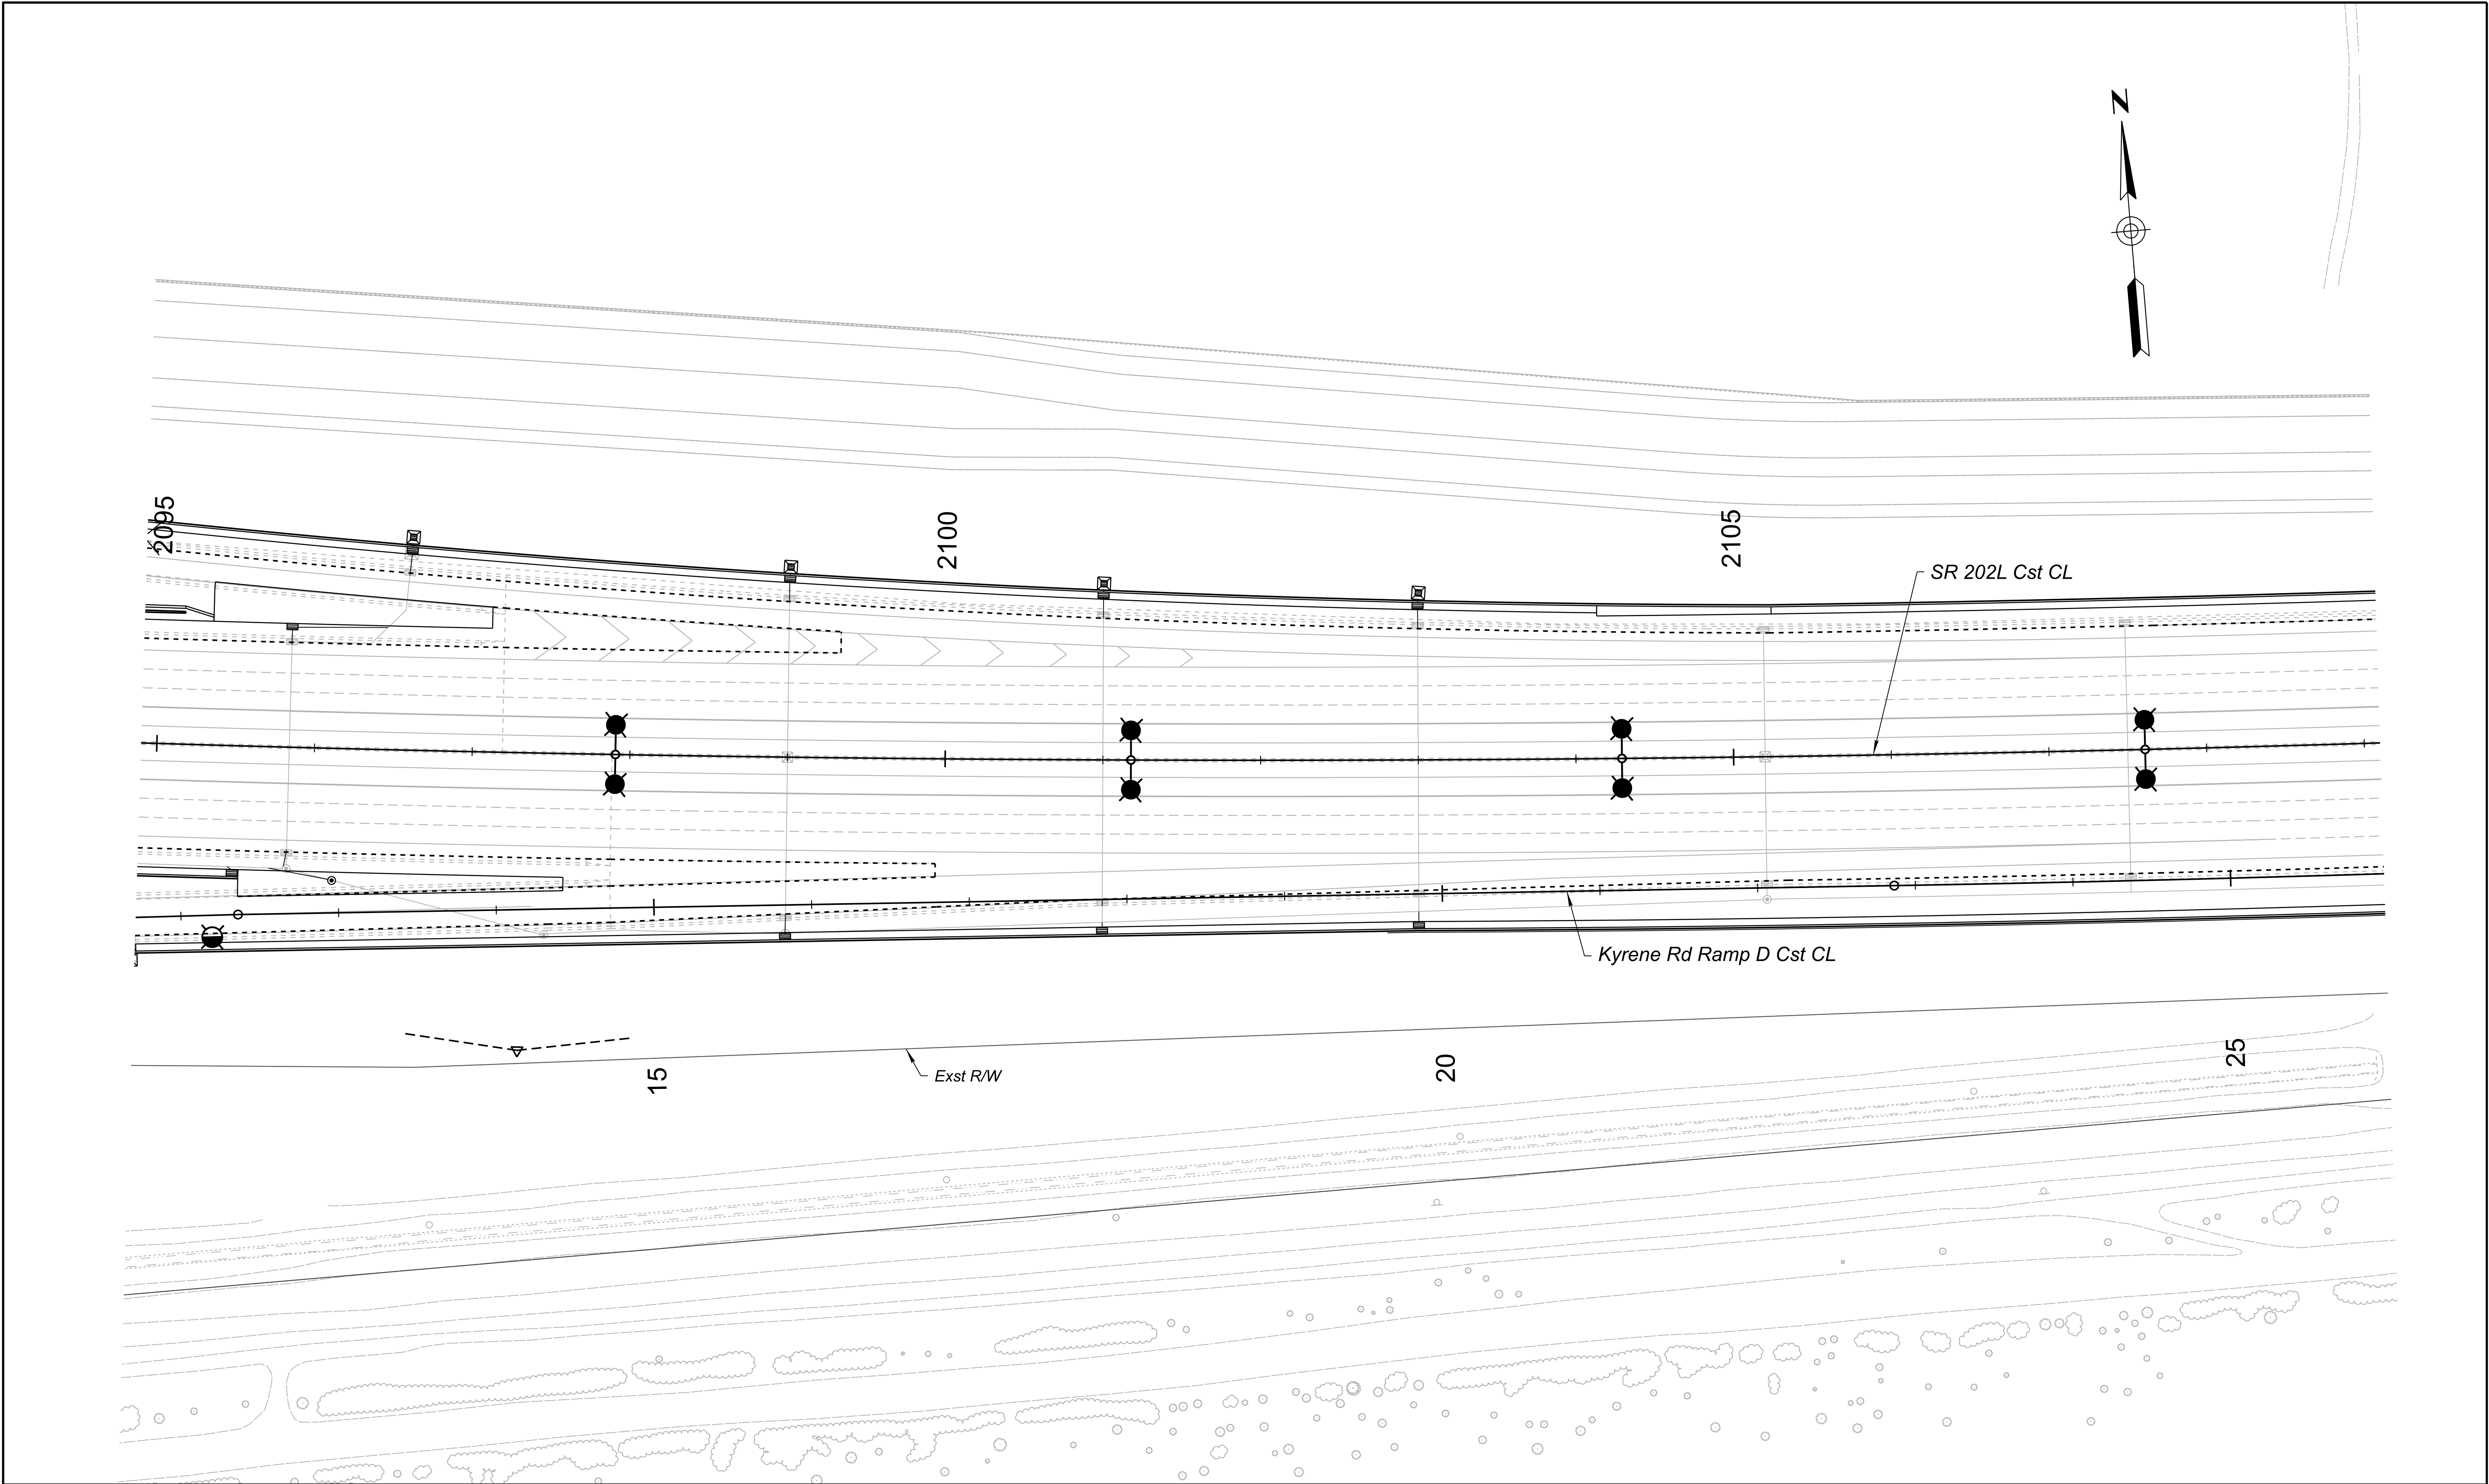

PRELIMINARY STAGE III Review NOT FOR CONSTRUCTION OR RECORDING	DESIGN	NAME	DATE	ARIZONA DEPARTMENT OF TRANSPORTATION PROJECT DELIVERY AND OPERATIONS DIVISION DRAINAGE DESIGN SECTION	ROUTE	F.H.W.A. Arizona Division	STATE ARIZ.	PROJECT NO.	FEDERAL ID NO.	SHEET NO.	TOTAL SHEETS	RECORD DRAWING
	DRAWN				MILEPOST							
	CHECKED				STRUCTURE NO.	LOCATION SR 202L SANTAN FREEWAY - I-10 TO SR 101L					DWG No. D-02.10	
	 501 N 44th St, Suite 300 Phoenix, AZ 85008-4505 Tel (602) 454-0402 www.typpsa.us	SR 202L DRAINAGE PLAN SHEET STA 2095+00 TO 2109+00			TRACS NO. F0847 01D		___ OF ___					