


NO.	DESCRIPTION OF REVISIONS	MADE BY	DATE
R00	RFC RELEASE	TM	08/18/25

SURVEY NO.	FINISHED PLANS	REVISIONS	LOCATION	DATE

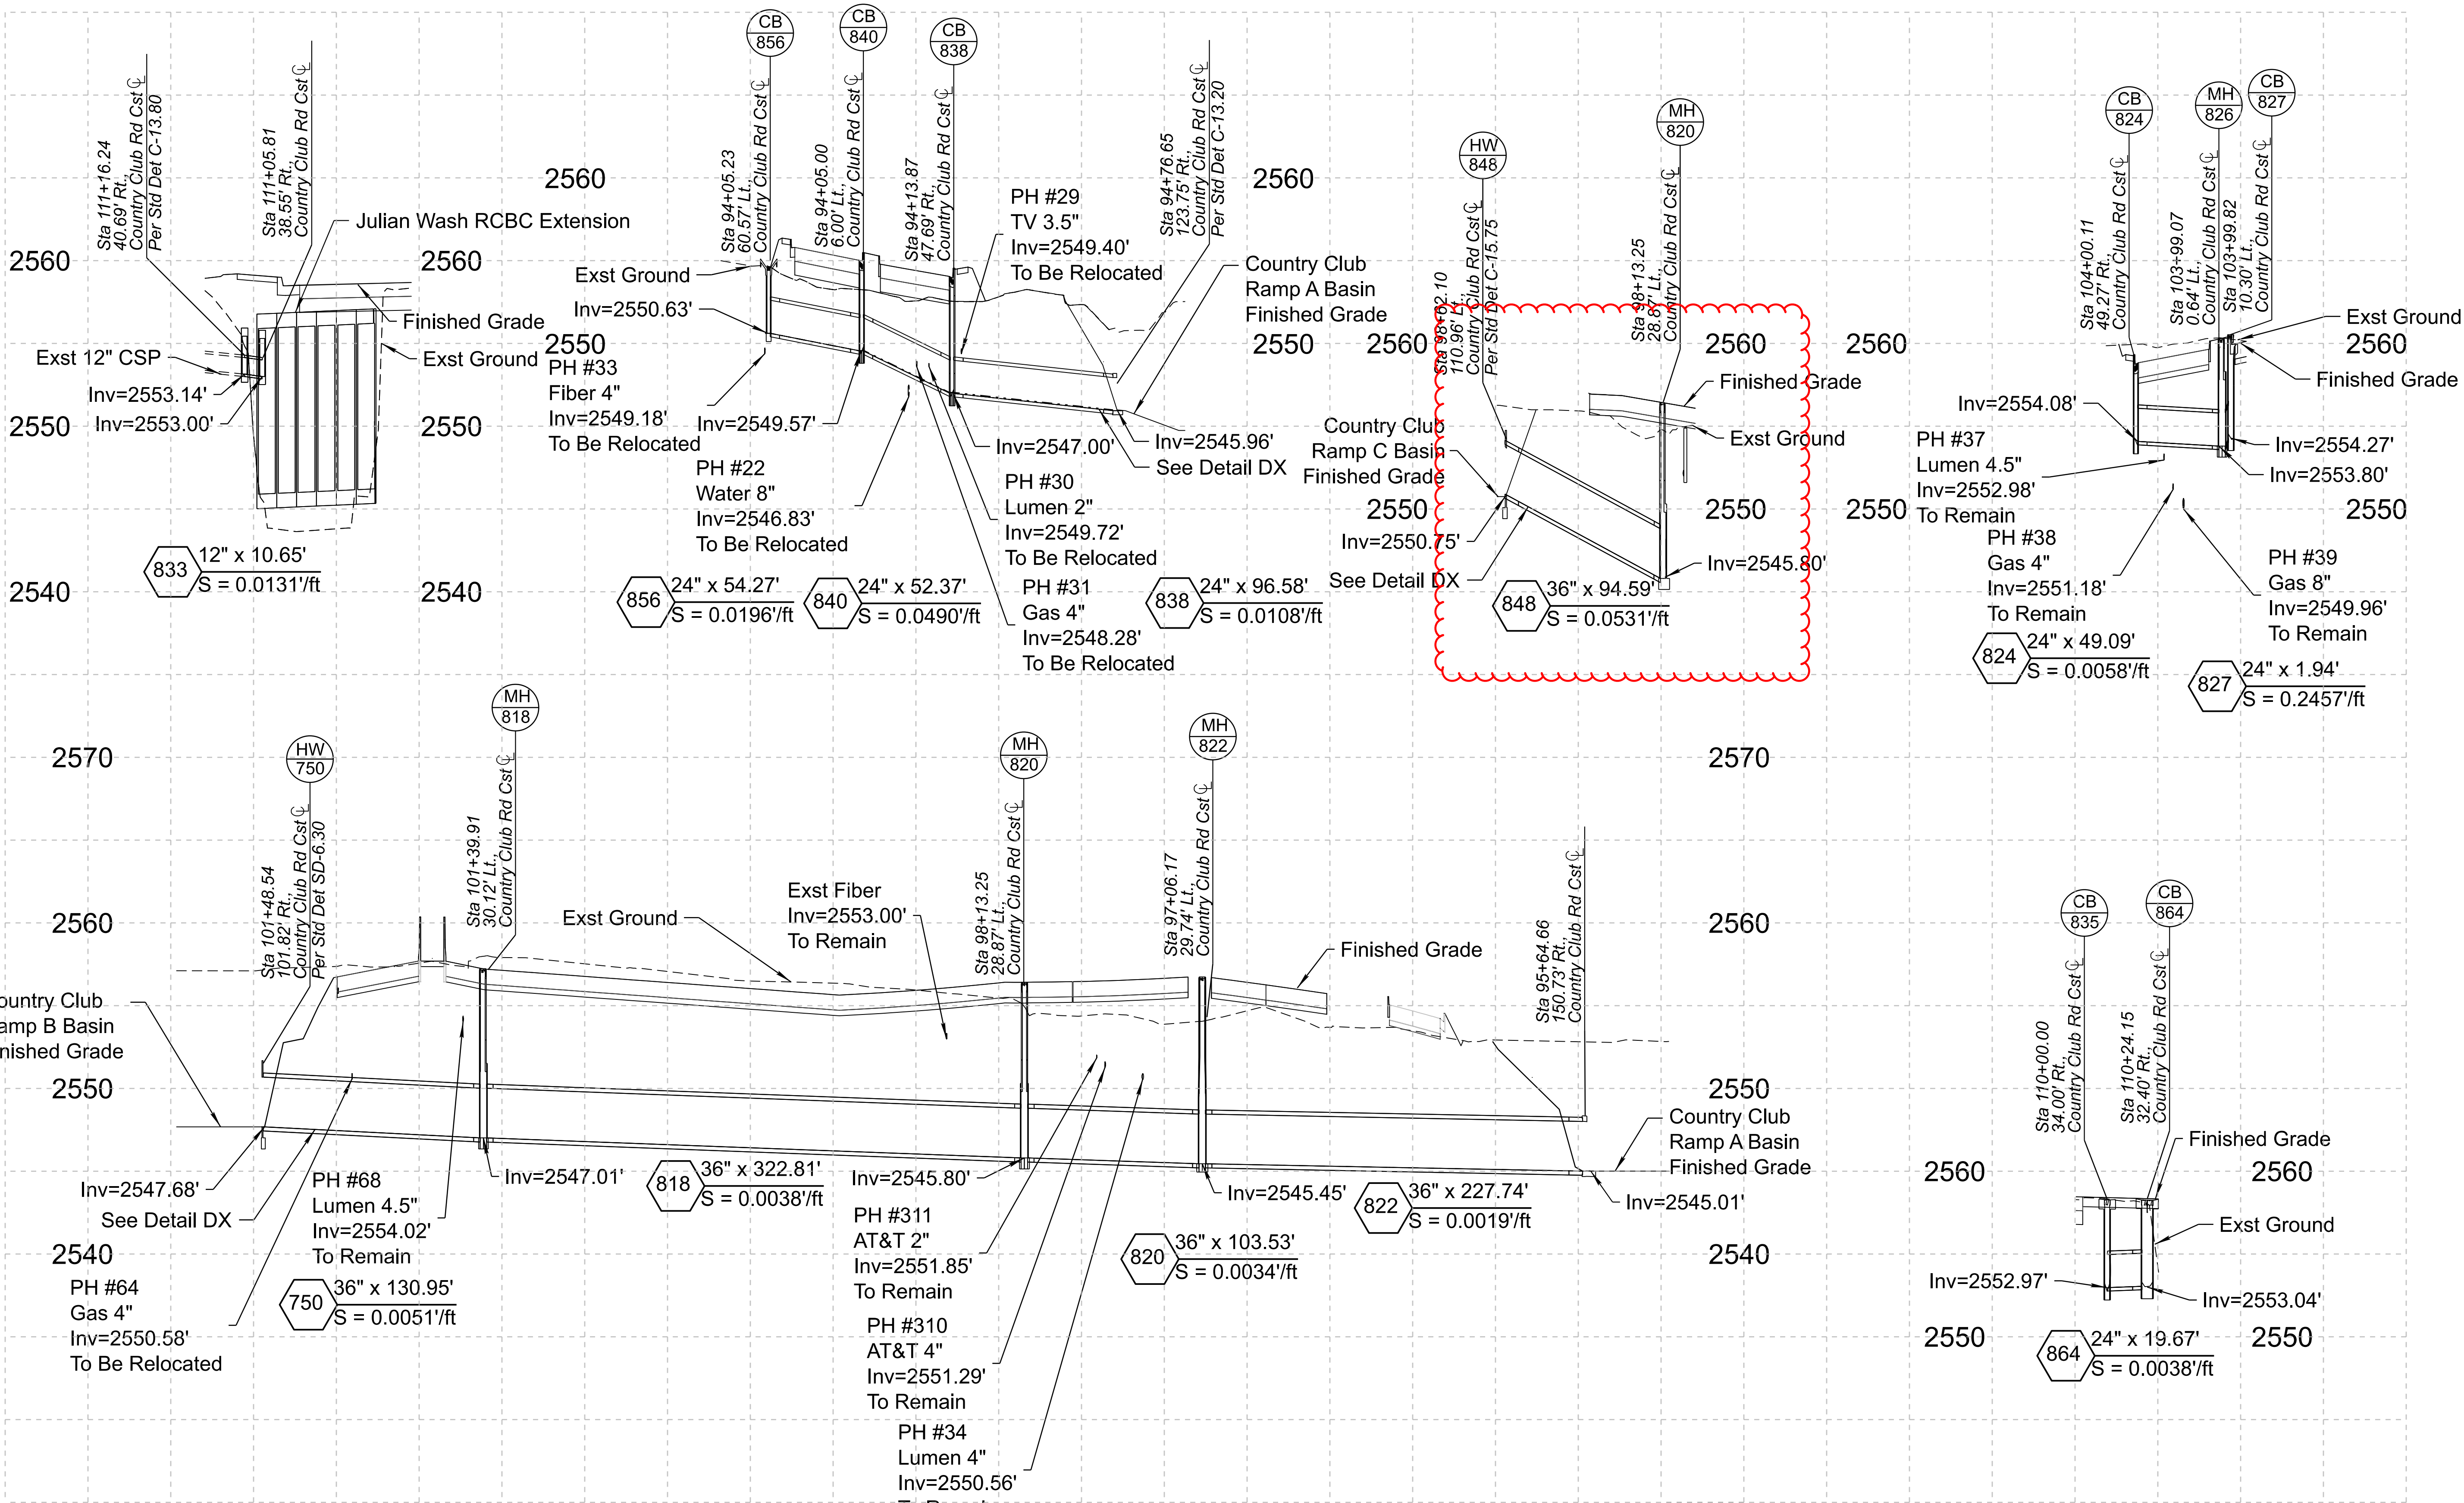

DESIGN	NAME	DATE	ARIZONA DEPARTMENT OF TRANSPORTATION INFRASTRUCTURE DELIVERY AND OPERATIONS DIVISION ROADWAY DESIGN SECTION	ROUTE I-10	F.H.W.A. Arizona Division	STATE ARIZ.	PROJECT NO. 010 PM 262	FEDERAL ID NO. 010-E(232)S	SHEET NO.	TOTAL SHEETS	RECORD DRAWING
DRAWN	L. BREINING	8/25	SUNDT	AZTEC	DRAINAGE PROFILE SHEET	LOCATION I-10 COUNTRY CLUB RD AND KINO PKWY TIS	TRACS NO. F0548 01C	ADOT	DWG NO. D-02.22	OF	