


	NO.	DESCRIPTION OF REVISIONS	BY	DATE	NO.	DESCRIPTION OF REVISIONS	BY	DATE	NO.	DESCRIPTION OF REVISIONS	BY	DATE
		x.										
		xxx										
0		RFC RELEASE		TW.08/18/25								



Registered Professional Engineer (Civil)
 CERTIFICATE NO.
 65939
 TIMOTHY
 MAHON
 Date Signed _____
 ARIZONA, U.S.A.

	NAME	DATE
DESIGN	J. FLINT	9/25
DRAWN	L. BREINING	9/25
CHECKED	T. MAHON	9/25

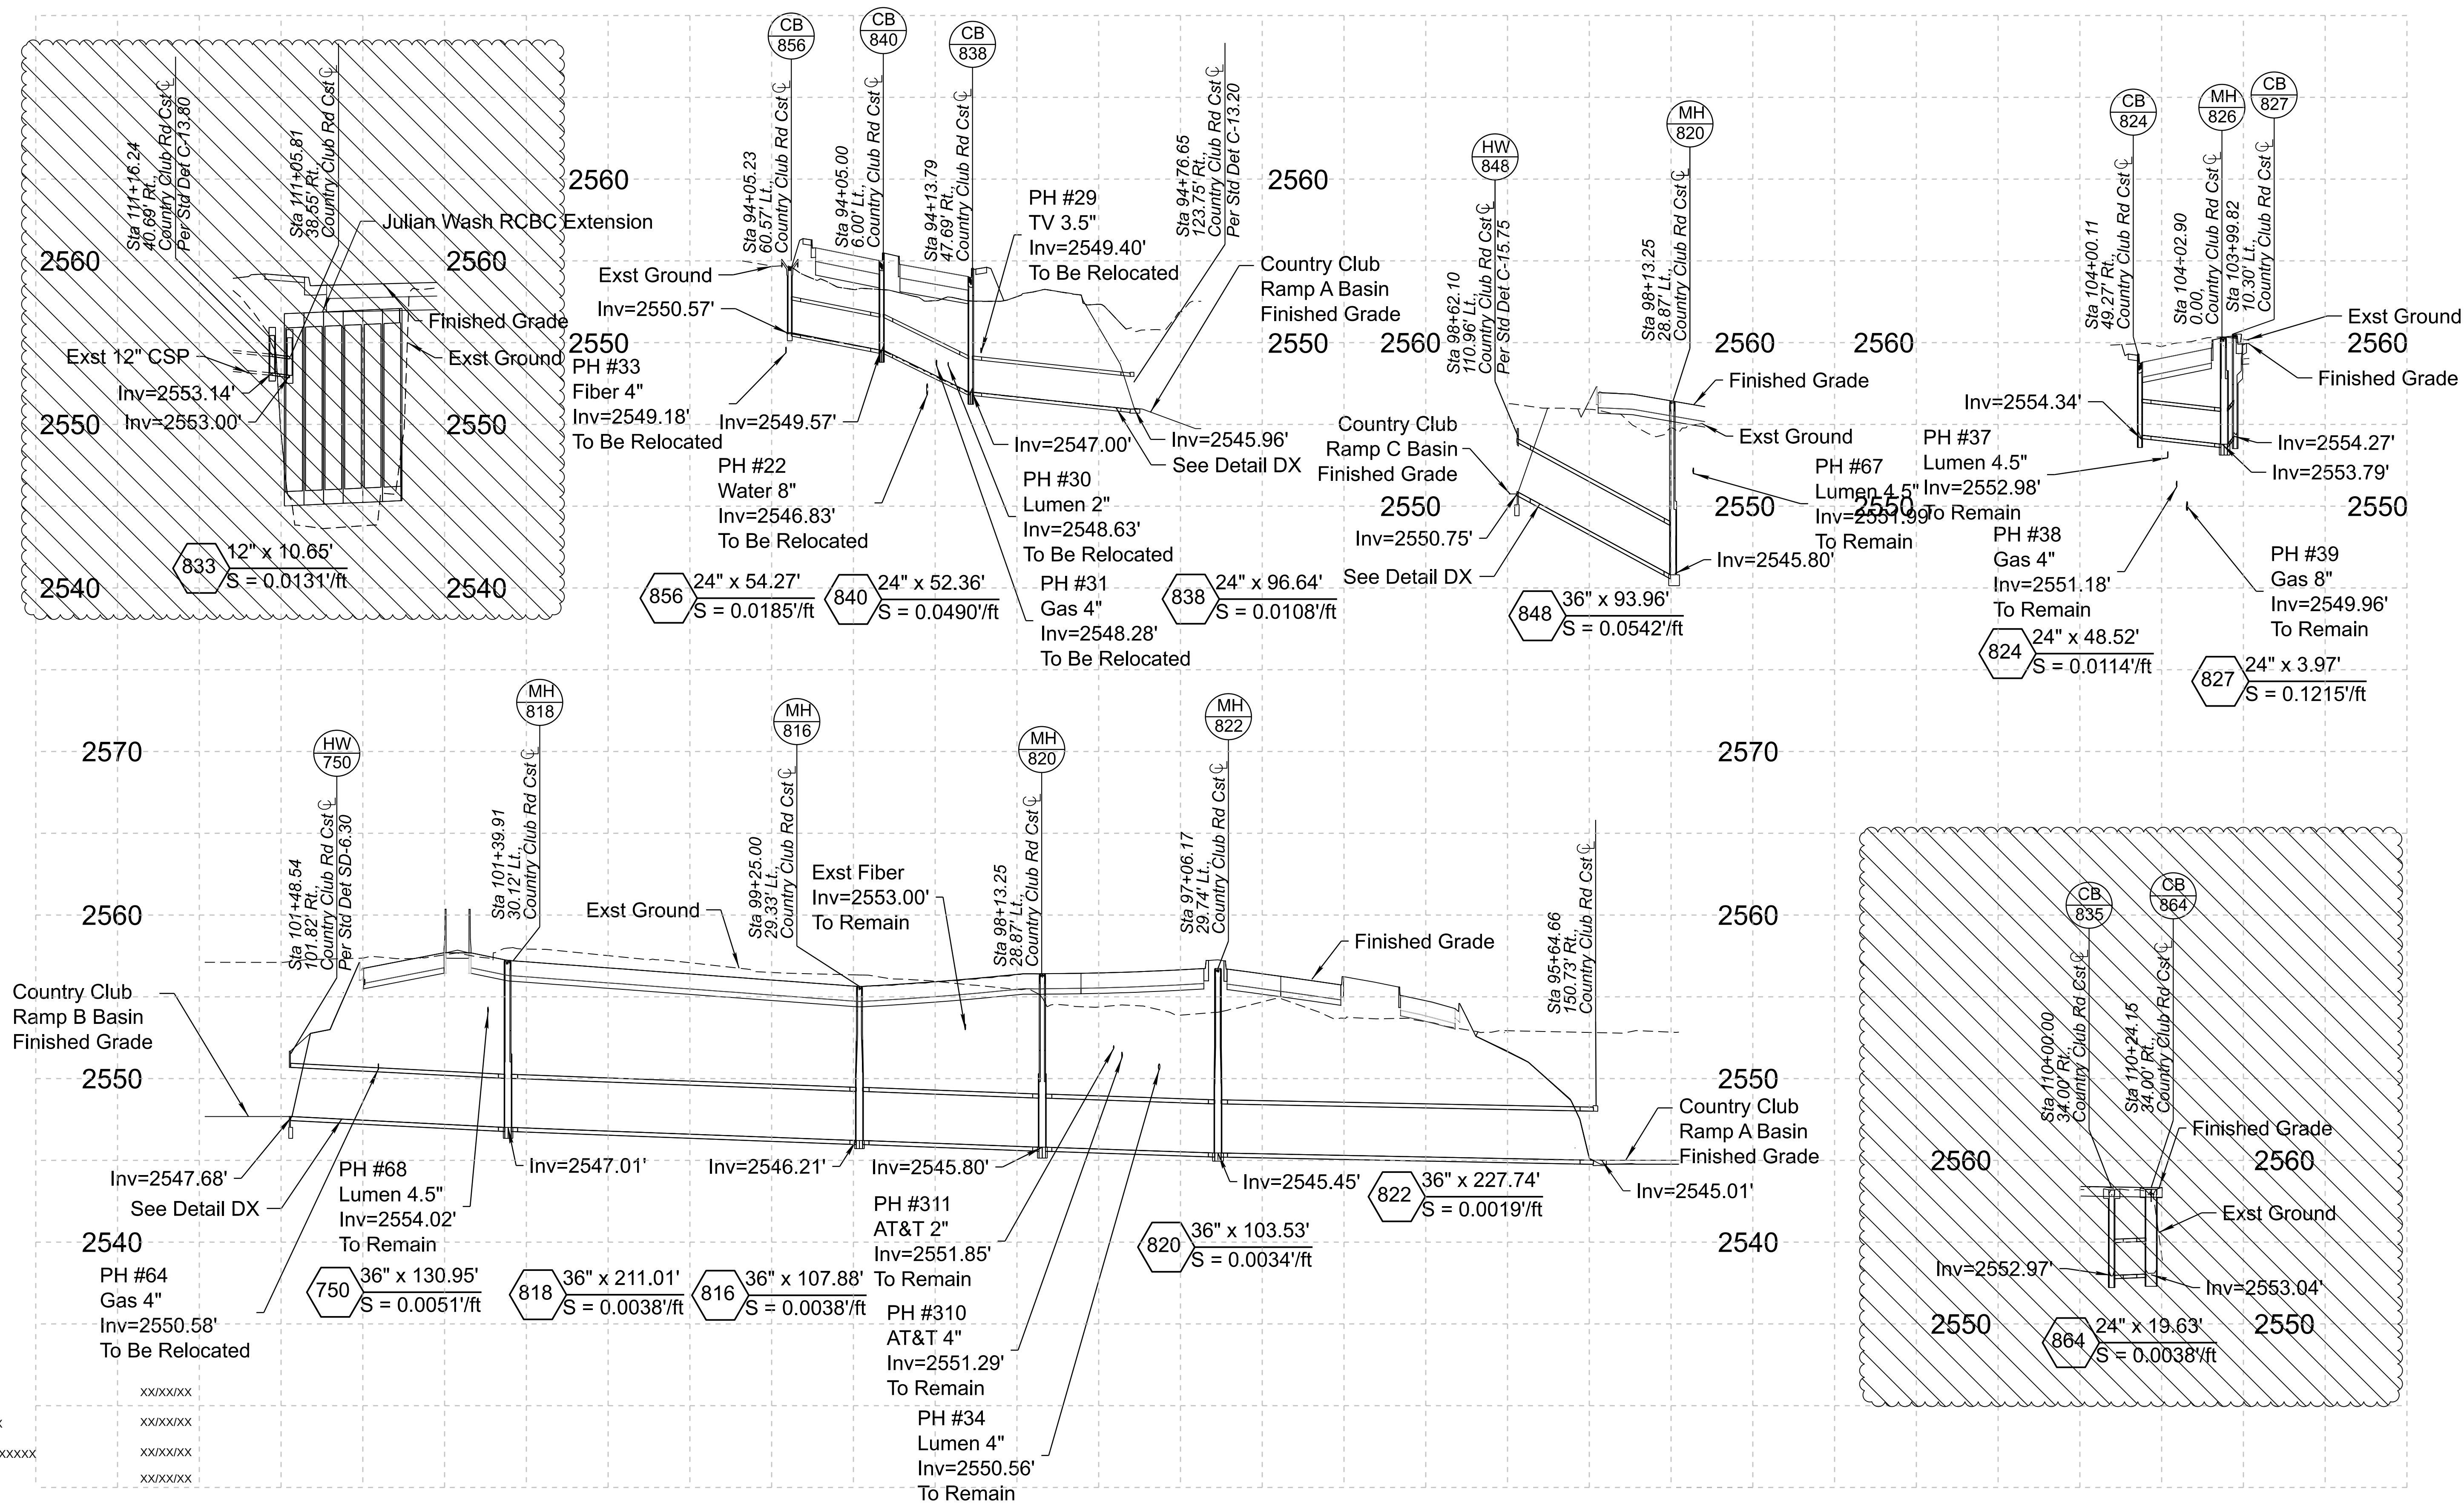




ARIZONA DEPARTMENT OF TRANSPORTATION
INFRASTRUCTURE DELIVERY AND OPERATIONS DIVISION
ROADWAY DESIGN SECTION

DRAINAGE PROFILE SHEET

ROUTE I-10	F.H.W.A. Arizona Division	STATE ARIZ.	PROJECT NO. 010 PM 262	FEDERAL ID NO. 010-E(232)S	SHEET NO.	TOTAL SHEETS	RECORD DRAWING
MILEPOST	LOCATION I-10 COUNTRY CLUB RD AND KINO PKWY TIS						DWG NO. D-02.22
STRUCTURE NO.	TRACS NO. F0548 01C					___ OF ___	

NO.	DESCRIPTION OF REVISIONS	MADE BY	DATE
R00	RFC RELEASE	TM	08/18/25

SURVEY NO.	FINISHED PLANS	REVISIONS	LOCATION	DATE

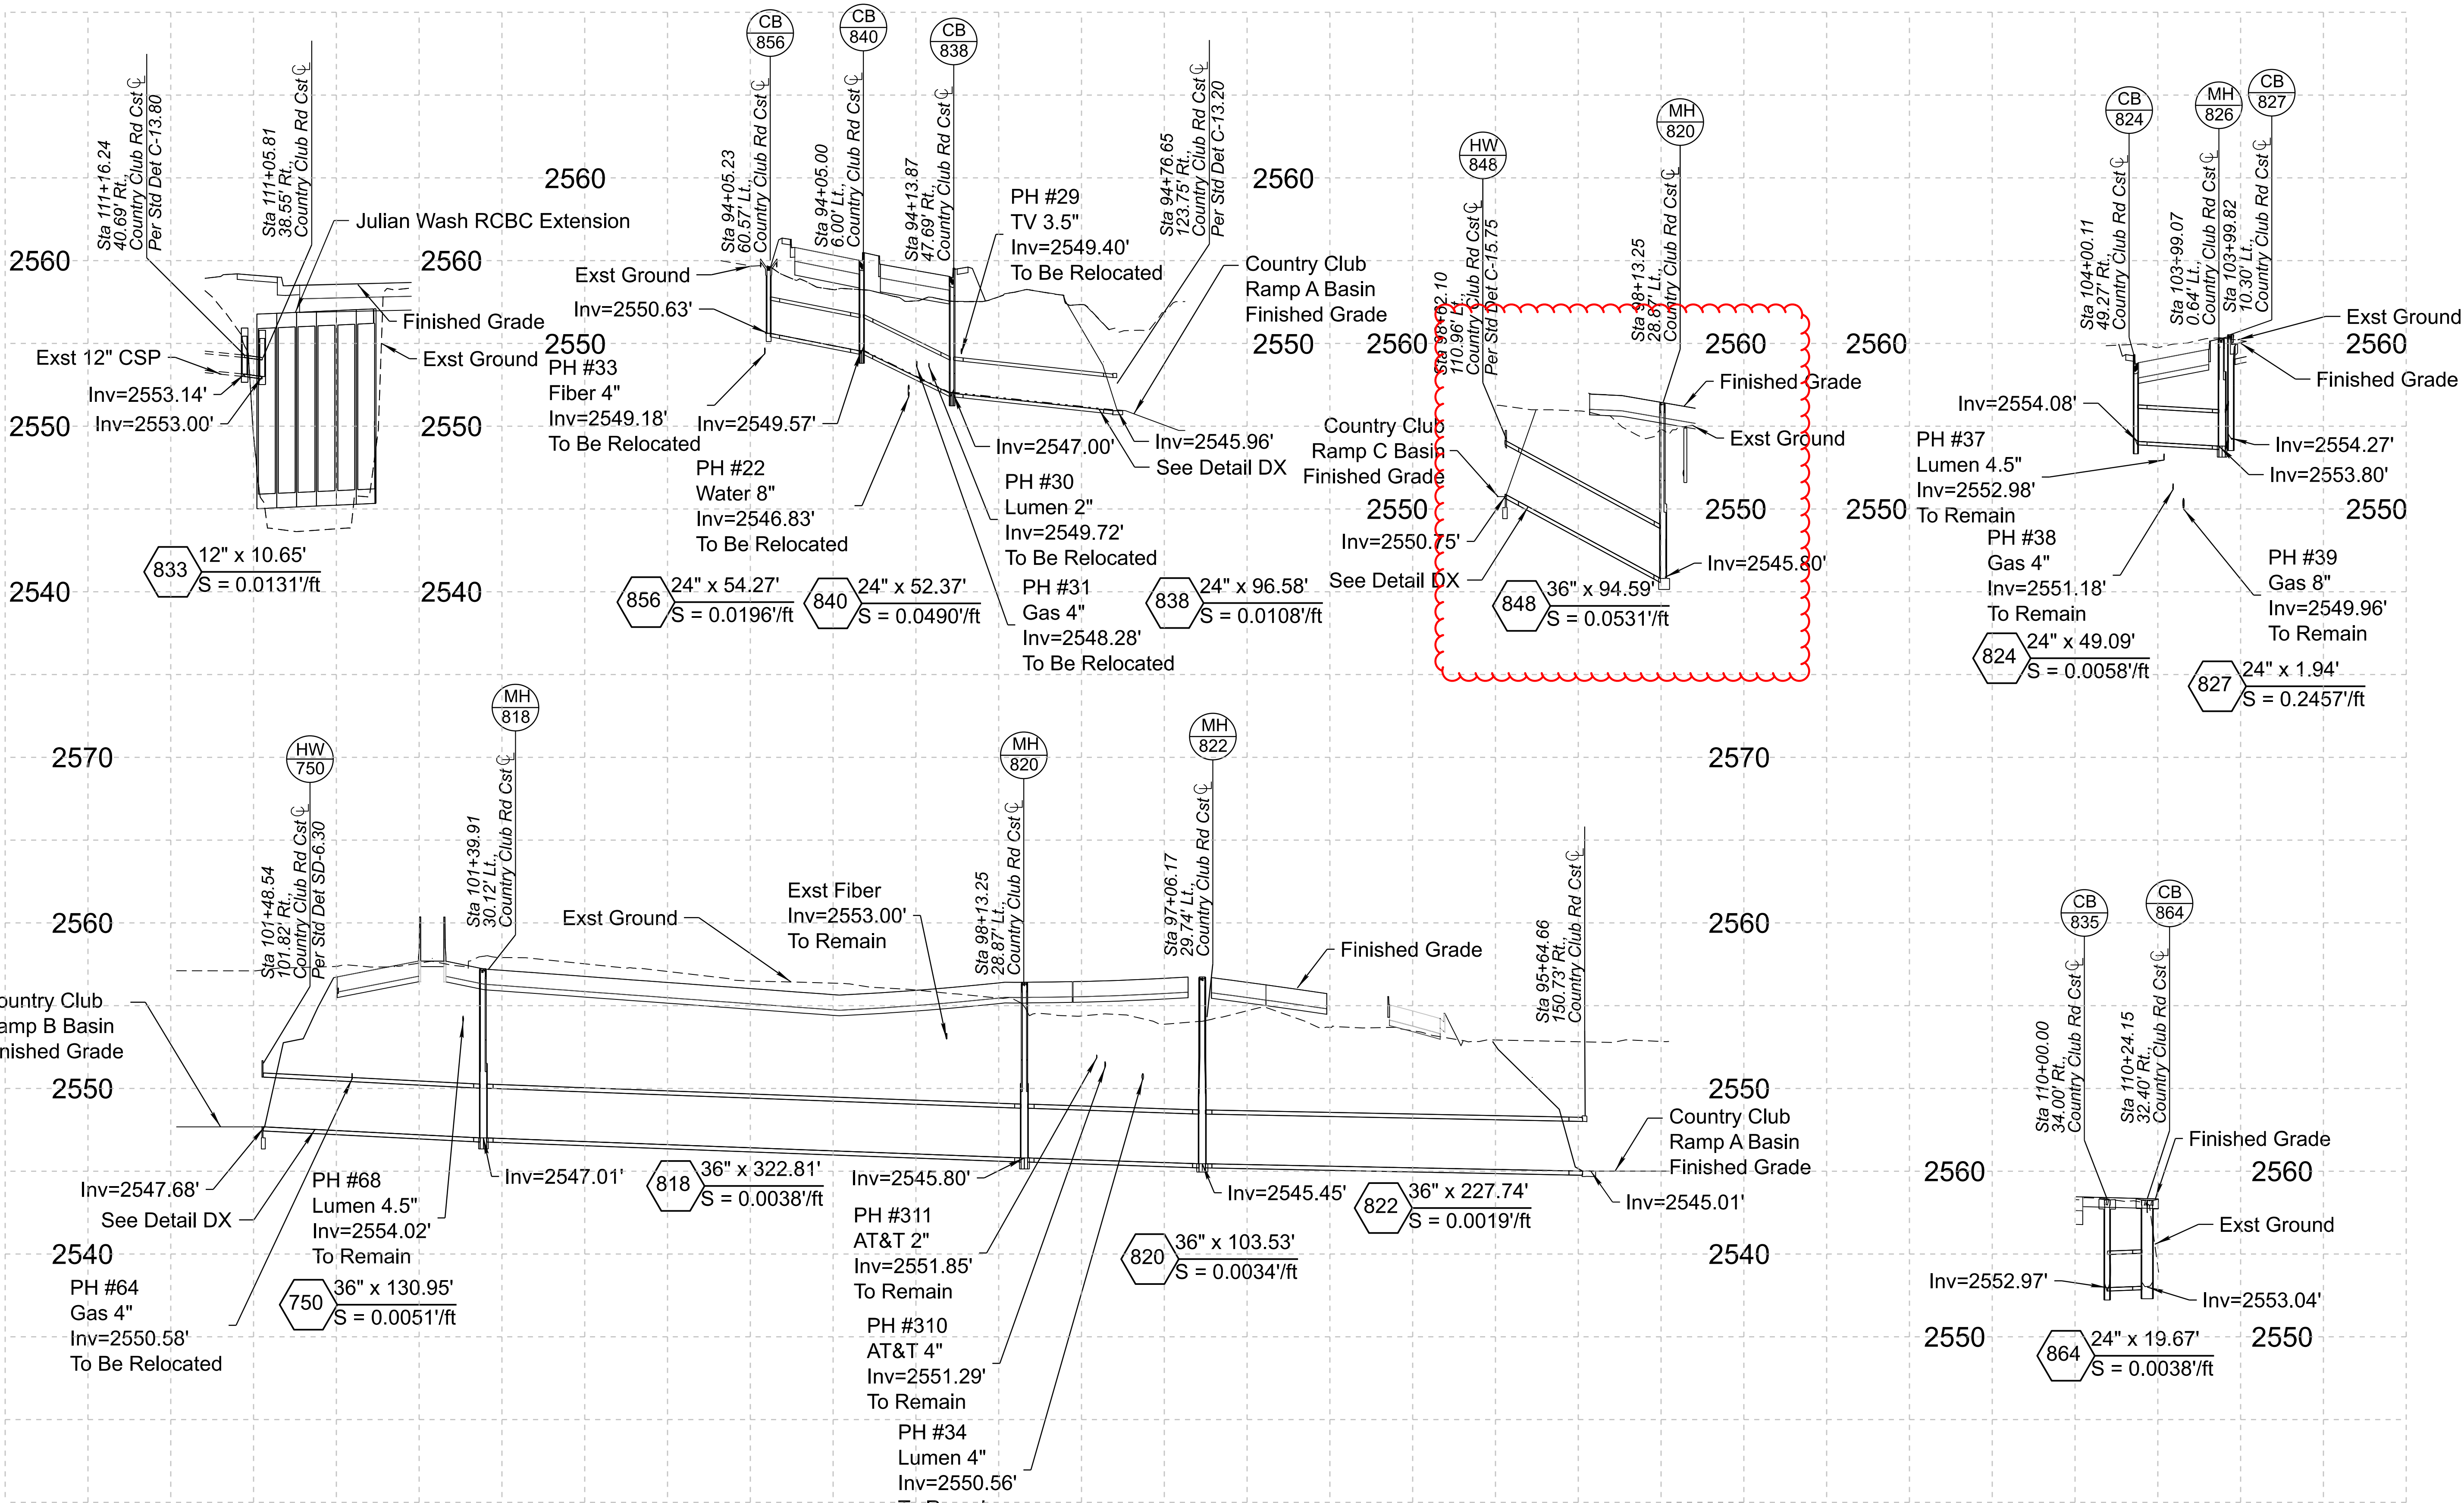

DESIGN	NAME	DATE	ARIZONA DEPARTMENT OF TRANSPORTATION INFRASTRUCTURE DELIVERY AND OPERATIONS DIVISION ROADWAY DESIGN SECTION	ROUTE I-10	F.H.W.A. Arizona Division	STATE ARIZ.	PROJECT NO. 010 PM 262	FEDERAL ID NO. 010-E(232)S	SHEET NO.	TOTAL SHEETS	RECORD DRAWING
DRAWN	L. BREINING	8/25	SUNDT	AZTEC	DRAINAGE PROFILE SHEET	LOCATION I-10 COUNTRY CLUB RD AND KINO PKWY TIS	TRACS NO. F0548 01C	ADOT	DWG NO. D-02.22	OF	
CHECKED	T. MAHON	8/25	SUNDT	AZTEC	DRAINAGE PROFILE SHEET	LOCATION I-10 COUNTRY CLUB RD AND KINO PKWY TIS	TRACS NO. F0548 01C	ADOT	DWG NO. D-02.22	OF	