


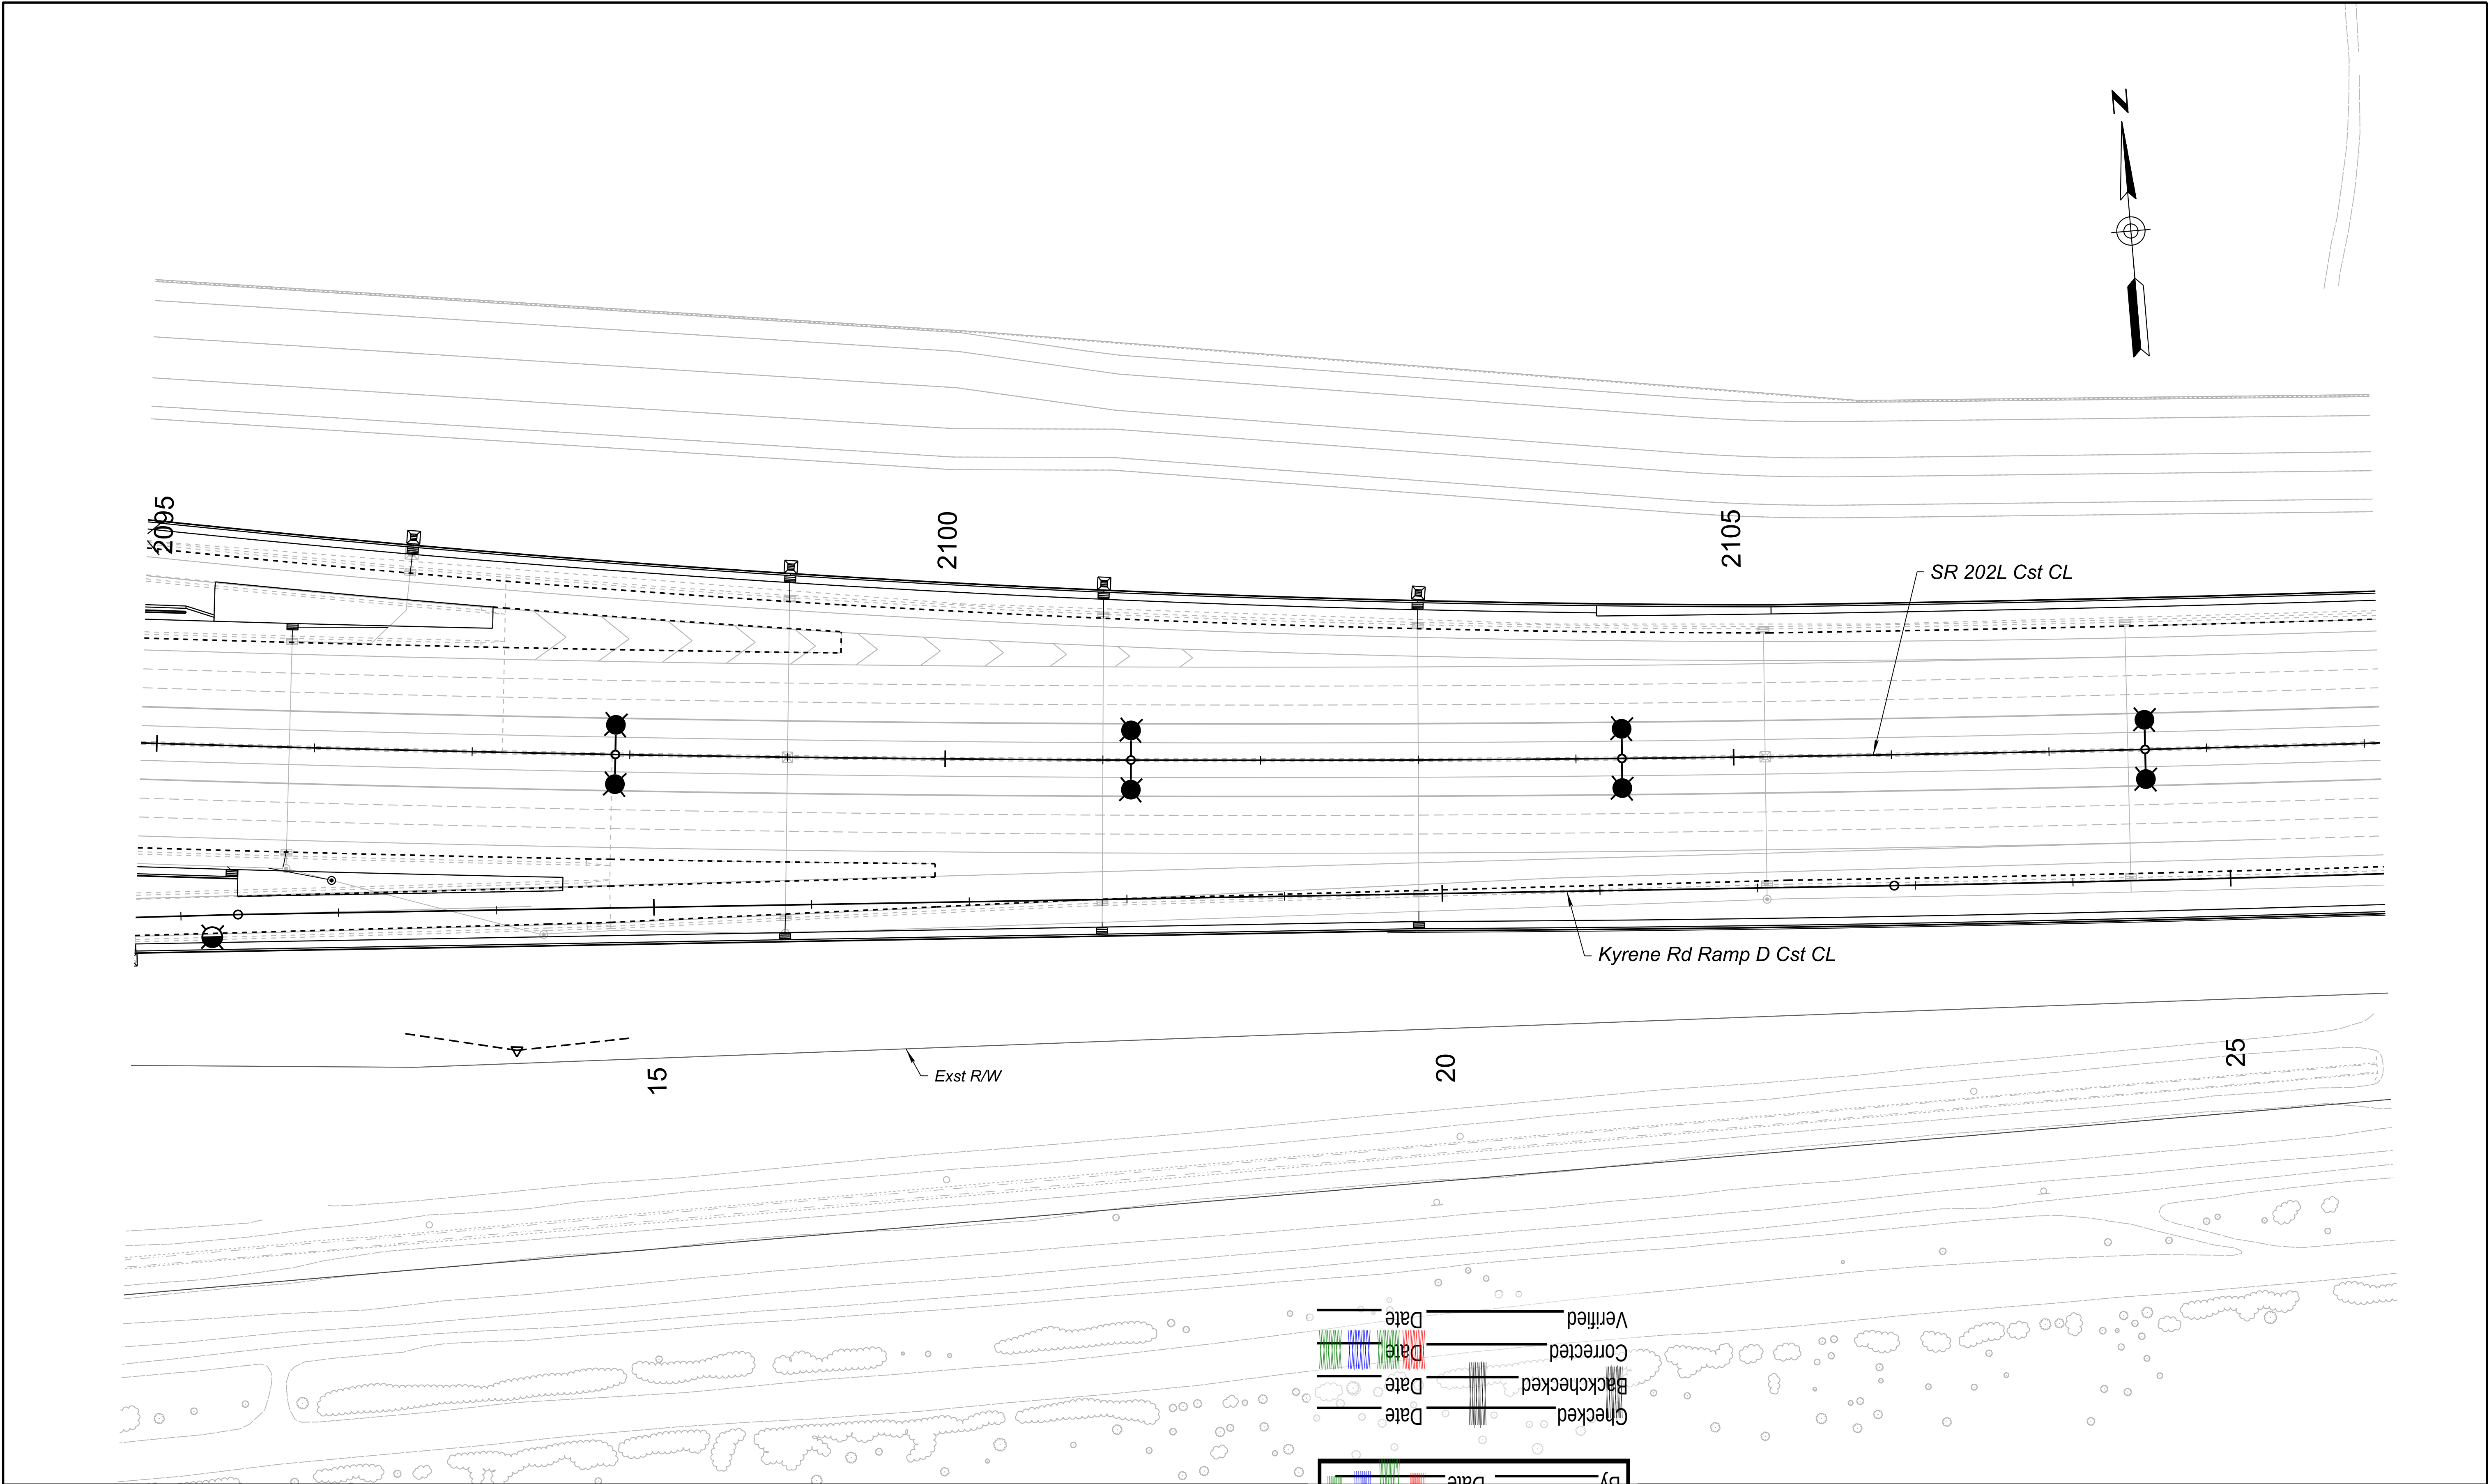

PRELIMINARY STAGE III Review NOT FOR CONSTRUCTION OR RECORDING	DESIGN	NAME	DATE	By _____ Date _____ Checked _____ Date _____ Backchecked _____ Date _____ Corrected _____ Date _____ Verified _____ Date _____	ROUTE	F.H.W.A. Arizona Division	STATE	PROJECT NO.	FEDERAL ID NO.	SHEET NO.	TOTAL SHEETS	RECORD DRAWING
	DRAWN				MILEPOST	SR 202L	ARIZ.					
	CHECKED				STRUCTURE NO.		LOCATION	SR 202L SANTAN FREEWAY - I-10 TO SR 101L				
	501 N 44th St, Suite 300 Phoenix, AZ 85008-4505 Tel (602) 454-0402 www.typpsa.us		TRACS NO.		F0847 01D		DWG No. D-02.10					
											OF	