


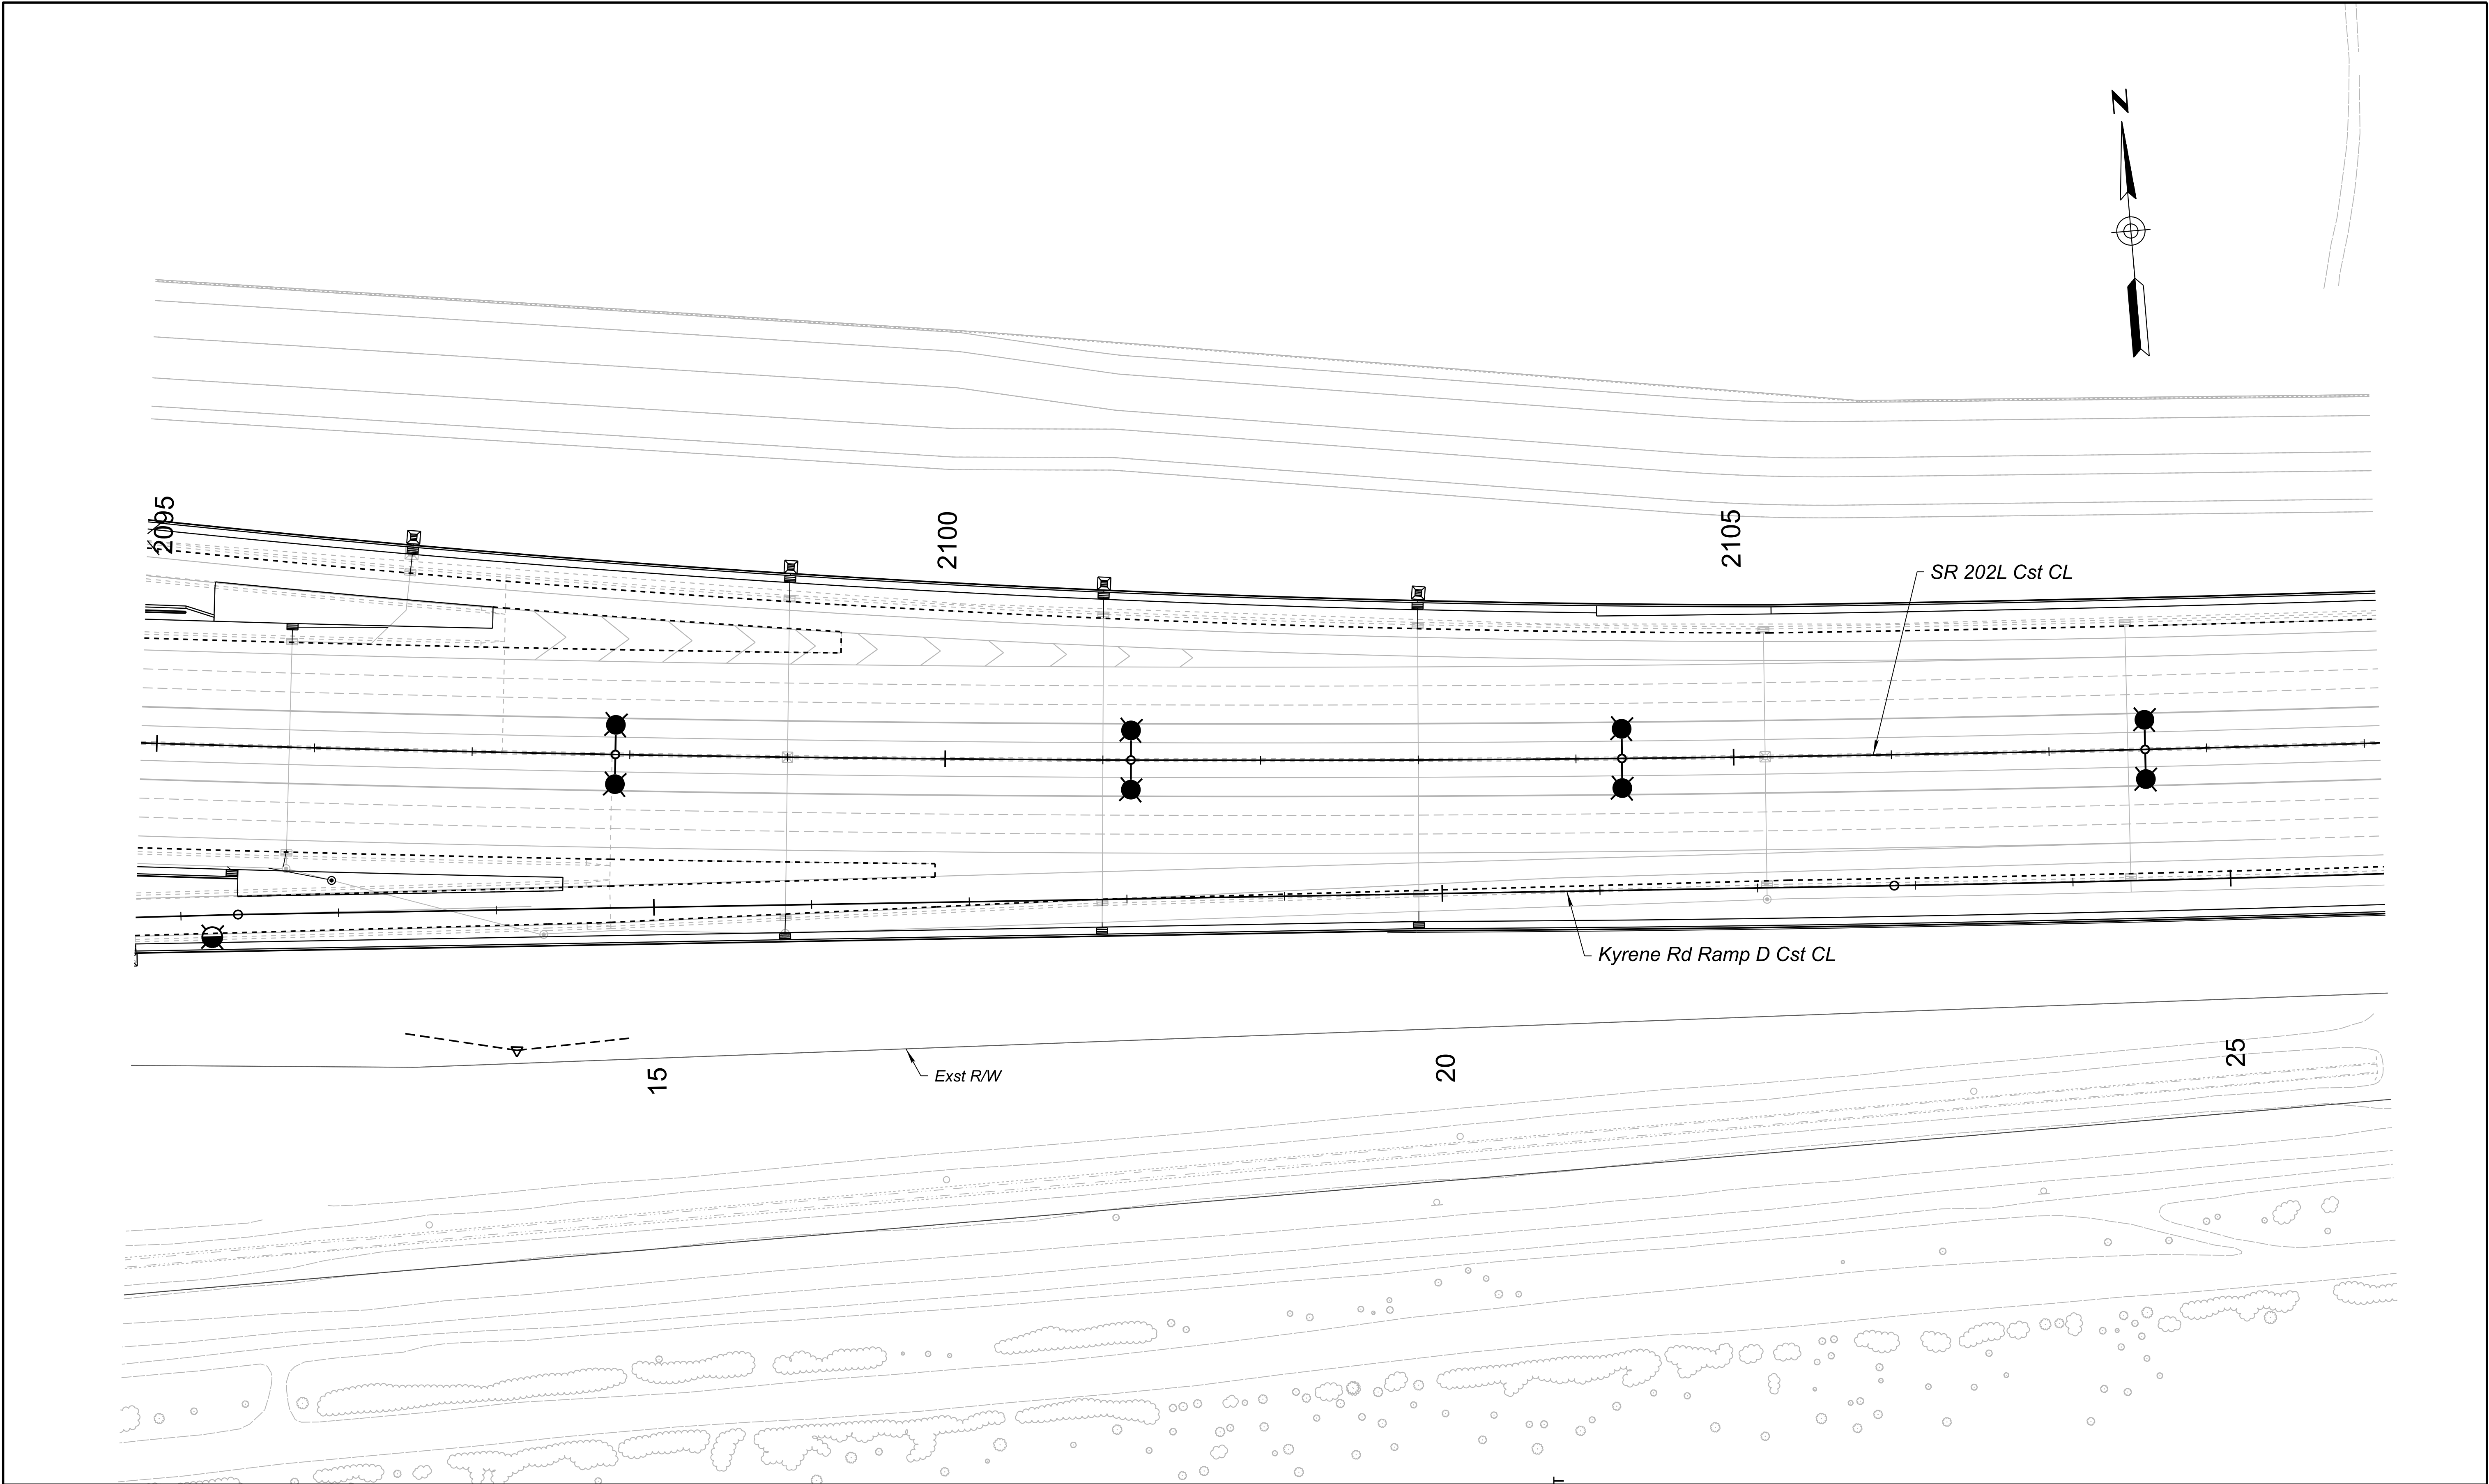

|                                                                                                                |                                                                                                                                                                                              |                                                          |      |                                                                                                                                                                                                     |       |                           |                                                                      |             |                |           |              |                |
|----------------------------------------------------------------------------------------------------------------|----------------------------------------------------------------------------------------------------------------------------------------------------------------------------------------------|----------------------------------------------------------|------|-----------------------------------------------------------------------------------------------------------------------------------------------------------------------------------------------------|-------|---------------------------|----------------------------------------------------------------------|-------------|----------------|-----------|--------------|----------------|
| <div>PRELIMINARY<br/><b>STAGE III</b><br/><br/>Review<br/><br/>NOT FOR<br/>CONSTRUCTION<br/>OR RECORDING</div> | DESIGN                                                                                                                                                                                       | NAME                                                     | DATE | <div>ARIZONA DEPARTMENT OF TRANSPORTATION<br/>PROJECT DELIVERY AND OPERATIONS DIVISION<br/><b>DRAINAGE DESIGN SECTION</b><br/><br/>SR 202L<br/>DRAINAGE PLAN SHEET<br/>STA 2095+00 TO 2109+00</div> | ROUTE | F.H.W.A. Arizona Division | STATE<br>ARIZ.                                                       | PROJECT NO. | FEDERAL ID NO. | SHEET NO. | TOTAL SHEETS | RECORD DRAWING |
|                                                                                                                | DRAWN                                                                                                                                                                                        |                                                          |      |                                                                                                                                                                                                     |       |                           |                                                                      |             |                |           |              |                |
|                                                                                                                | CHECKED                                                                                                                                                                                      |                                                          |      |                                                                                                                                                                                                     |       | MILEPOST                  | LOCATION SR 202L SANTAN FREEWAY - I-10 TO SR 101L<br>DWG No. D-02.10 |             |                |           |              |                |
|                                                                                                                | <div> 501 N 44th St, Suite 300<br/>Phoenix, AZ 85008-4505<br/>Tel (602) 454-0402<br/>www.typsa.us</div> | SR 202L<br>DRAINAGE PLAN SHEET<br>STA 2095+00 TO 2109+00 |      |                                                                                                                                                                                                     |       | STRUCTURE NO.             |                                                                      |             |                |           |              |                |
|                                                                                                                |                                                                                                                                                                                              |                                                          |      |                                                                                                                                                                                                     |       |                           |                                                                      |             |                |           |              |                |