


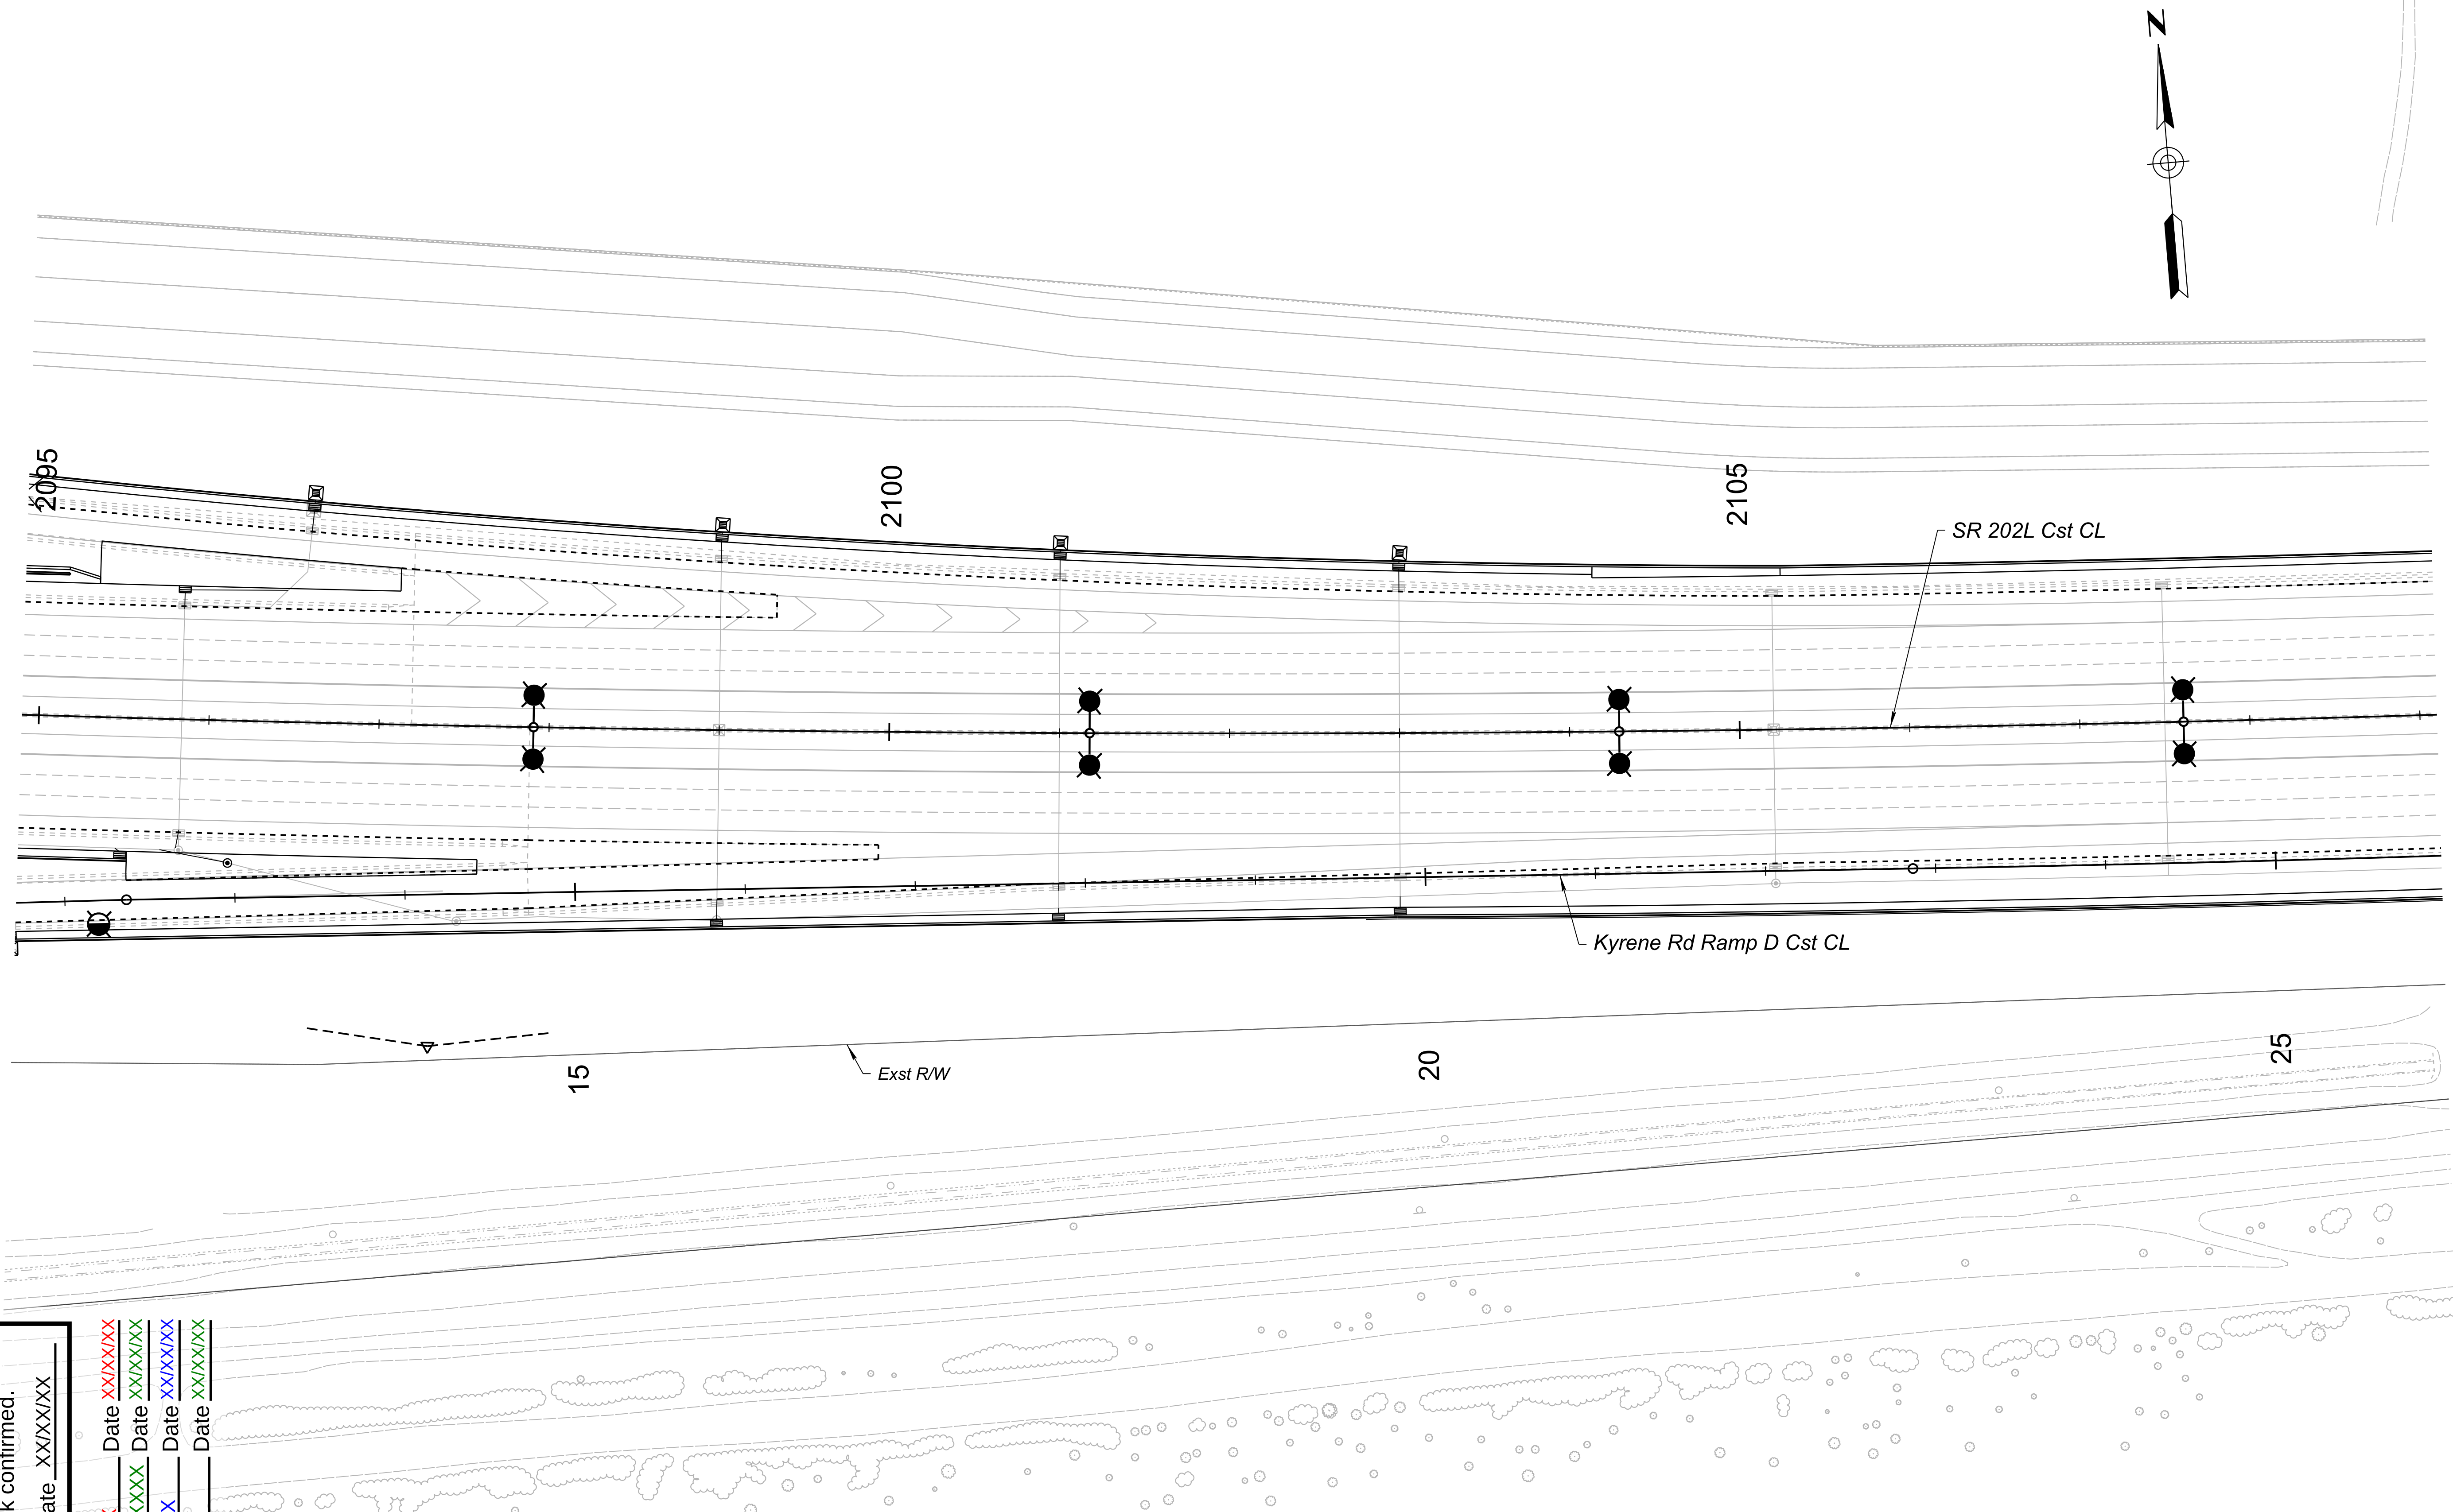

No.	XXXX	Date	XXXXXX
CHECK PRINT			
Dgn. checked against calcs. and calc. check confirmed.			
By	X.XXXXXXXXXX	Date	XX/XX/XX

Checked X.XXXXXX	Date XXXXXX
Backchecked X.XXXXXX	Date XXXXXX
Corrected X.XXXXXX	Date XXXXXX
Verified X.XXXXXX	Date XXXXXX

		PRELIMINARY STAGE III Review NOT FOR CONSTRUCTION OR RECORDING	DESIGN DRAWN CHECKED	NAME	DATE	ARIZONA DEPARTMENT OF TRANSPORTATION PROJECT DELIVERY AND OPERATIONS DIVISION DRAINAGE DESIGN SECTION	ROUTE SR 202L	F.H.W.A. Arizona Division	STATE ARIZ.	PROJECT NO.	FEDERAL ID NO.	SHEET NO.	TOTAL SHEETS	RECORD DRAWING	
			TYPSA		501 N 44th St, Suite 300 Phoenix, AZ 85008-4505 Tel (602) 454-0402 www.typosa.us	SR 202L DRAINAGE PLAN SHEET STA 2095+00 TO 2109+00	MILEPOST	LOCATION SR 202L SANTAN FREEWAY - I-10 TO SR 101L							DWG No. D-02.10
							STRUCTURE NO.	TRACS NO. F0847 01D						___ OF ___	

1/26/26 10:50 AM AZDOT 2024\AZFWY1704-FD02-SR202 - I-10 to SR101\CADD\Sheets\050_D-02.10_d0847.drn.dgn