


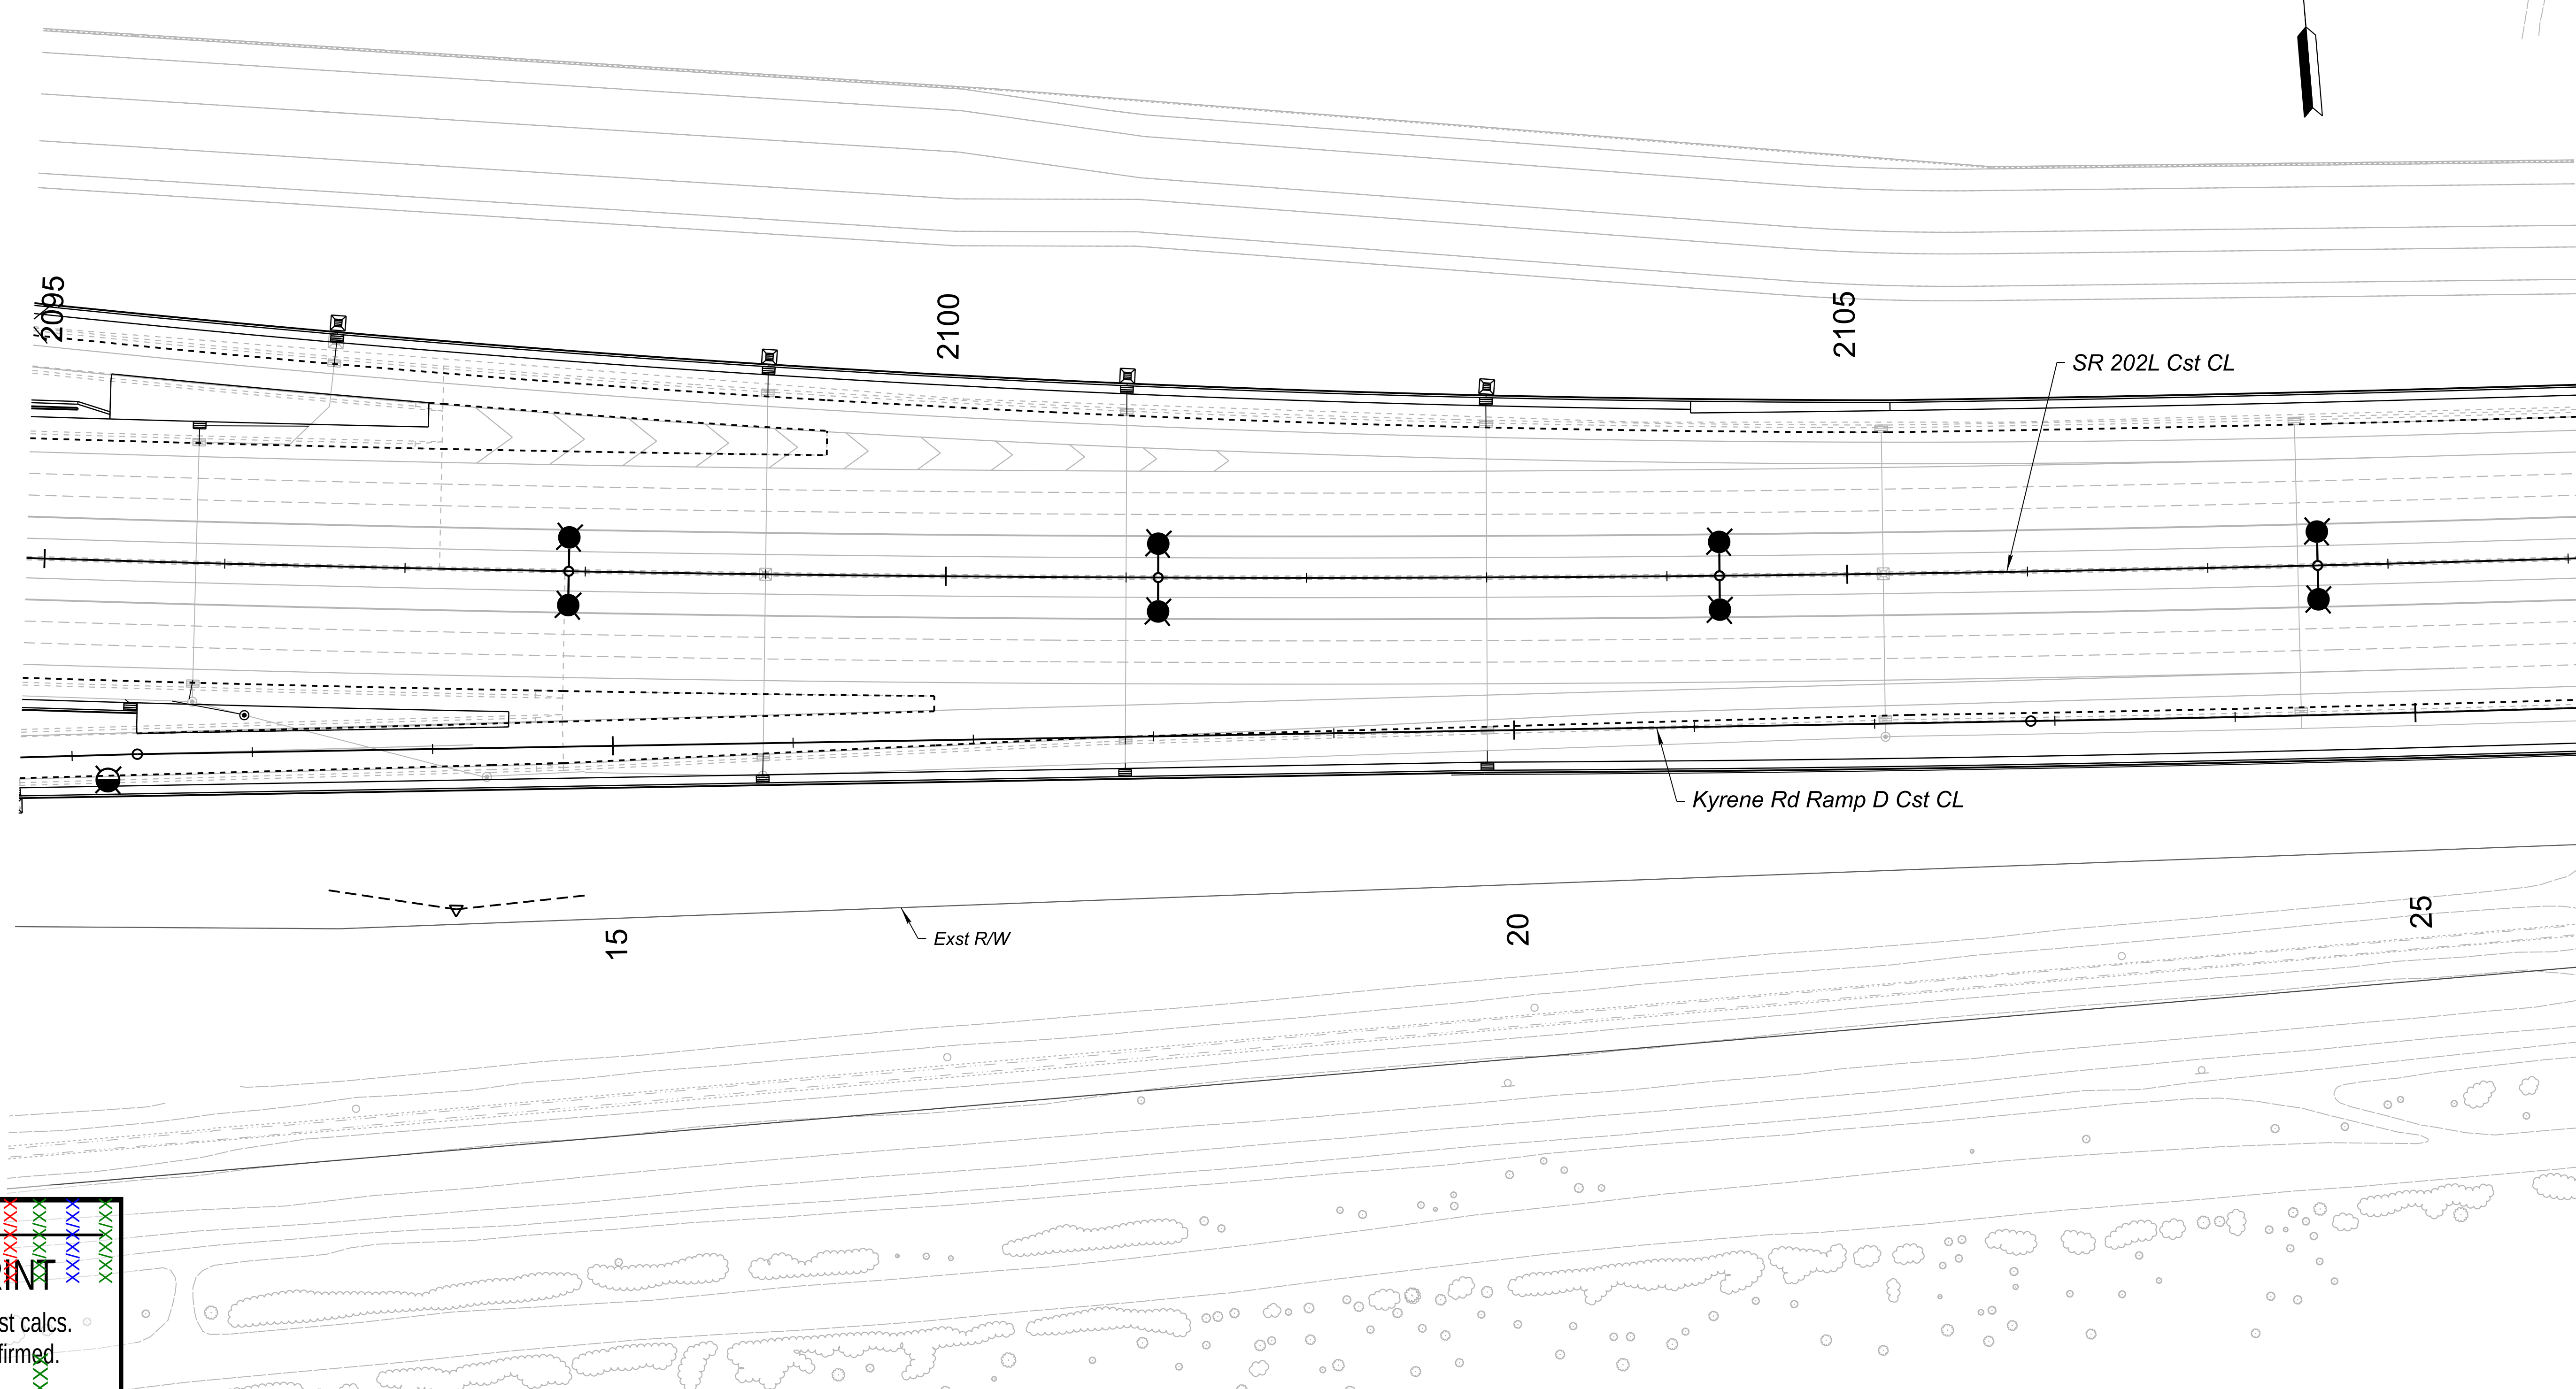

	Checked	Backchecked	Corrected	Verified	Date
Checked	X	X	X	X	Date
Backchecked	X	X	X	X	Date
Corrected	X	X	X	X	Date
Verified	X	X	X	X	Date

PRELIMINARY STAGE III Review NOT FOR CONSTRUCTION OR RECORDING		NAME	DATE	ARIZONA DEPARTMENT OF TRANSPORTATION PROJECT DELIVERY AND OPERATIONS DIVISION DRAINAGE DESIGN SECTION	ROUTE	F.H.W.A. Arizona Division	STATE	PROJECT NO.	FEDERAL ID NO.	SHEET NO.	TOTAL SHEETS	RECORD DRAWING
	DESIGN				SR 202L		ARIZ.					
	DRAWN				MILEPOST	LOCATION SR 202L SANTAN FREEWAY - I-10 TO SR 101L DWG No. D-02.10						
	CHECKED				STRUCTURE NO.	TRACS NO. F0847 01D ____ OF ____						
	 501 N 44th St, Suite 300 Phoenix, AZ 85008-4505 Tel (602) 454-0402 www.typsas.us	SR 202L DRAINAGE PLAN SHEET STA 2095+00 TO 2109+00										