
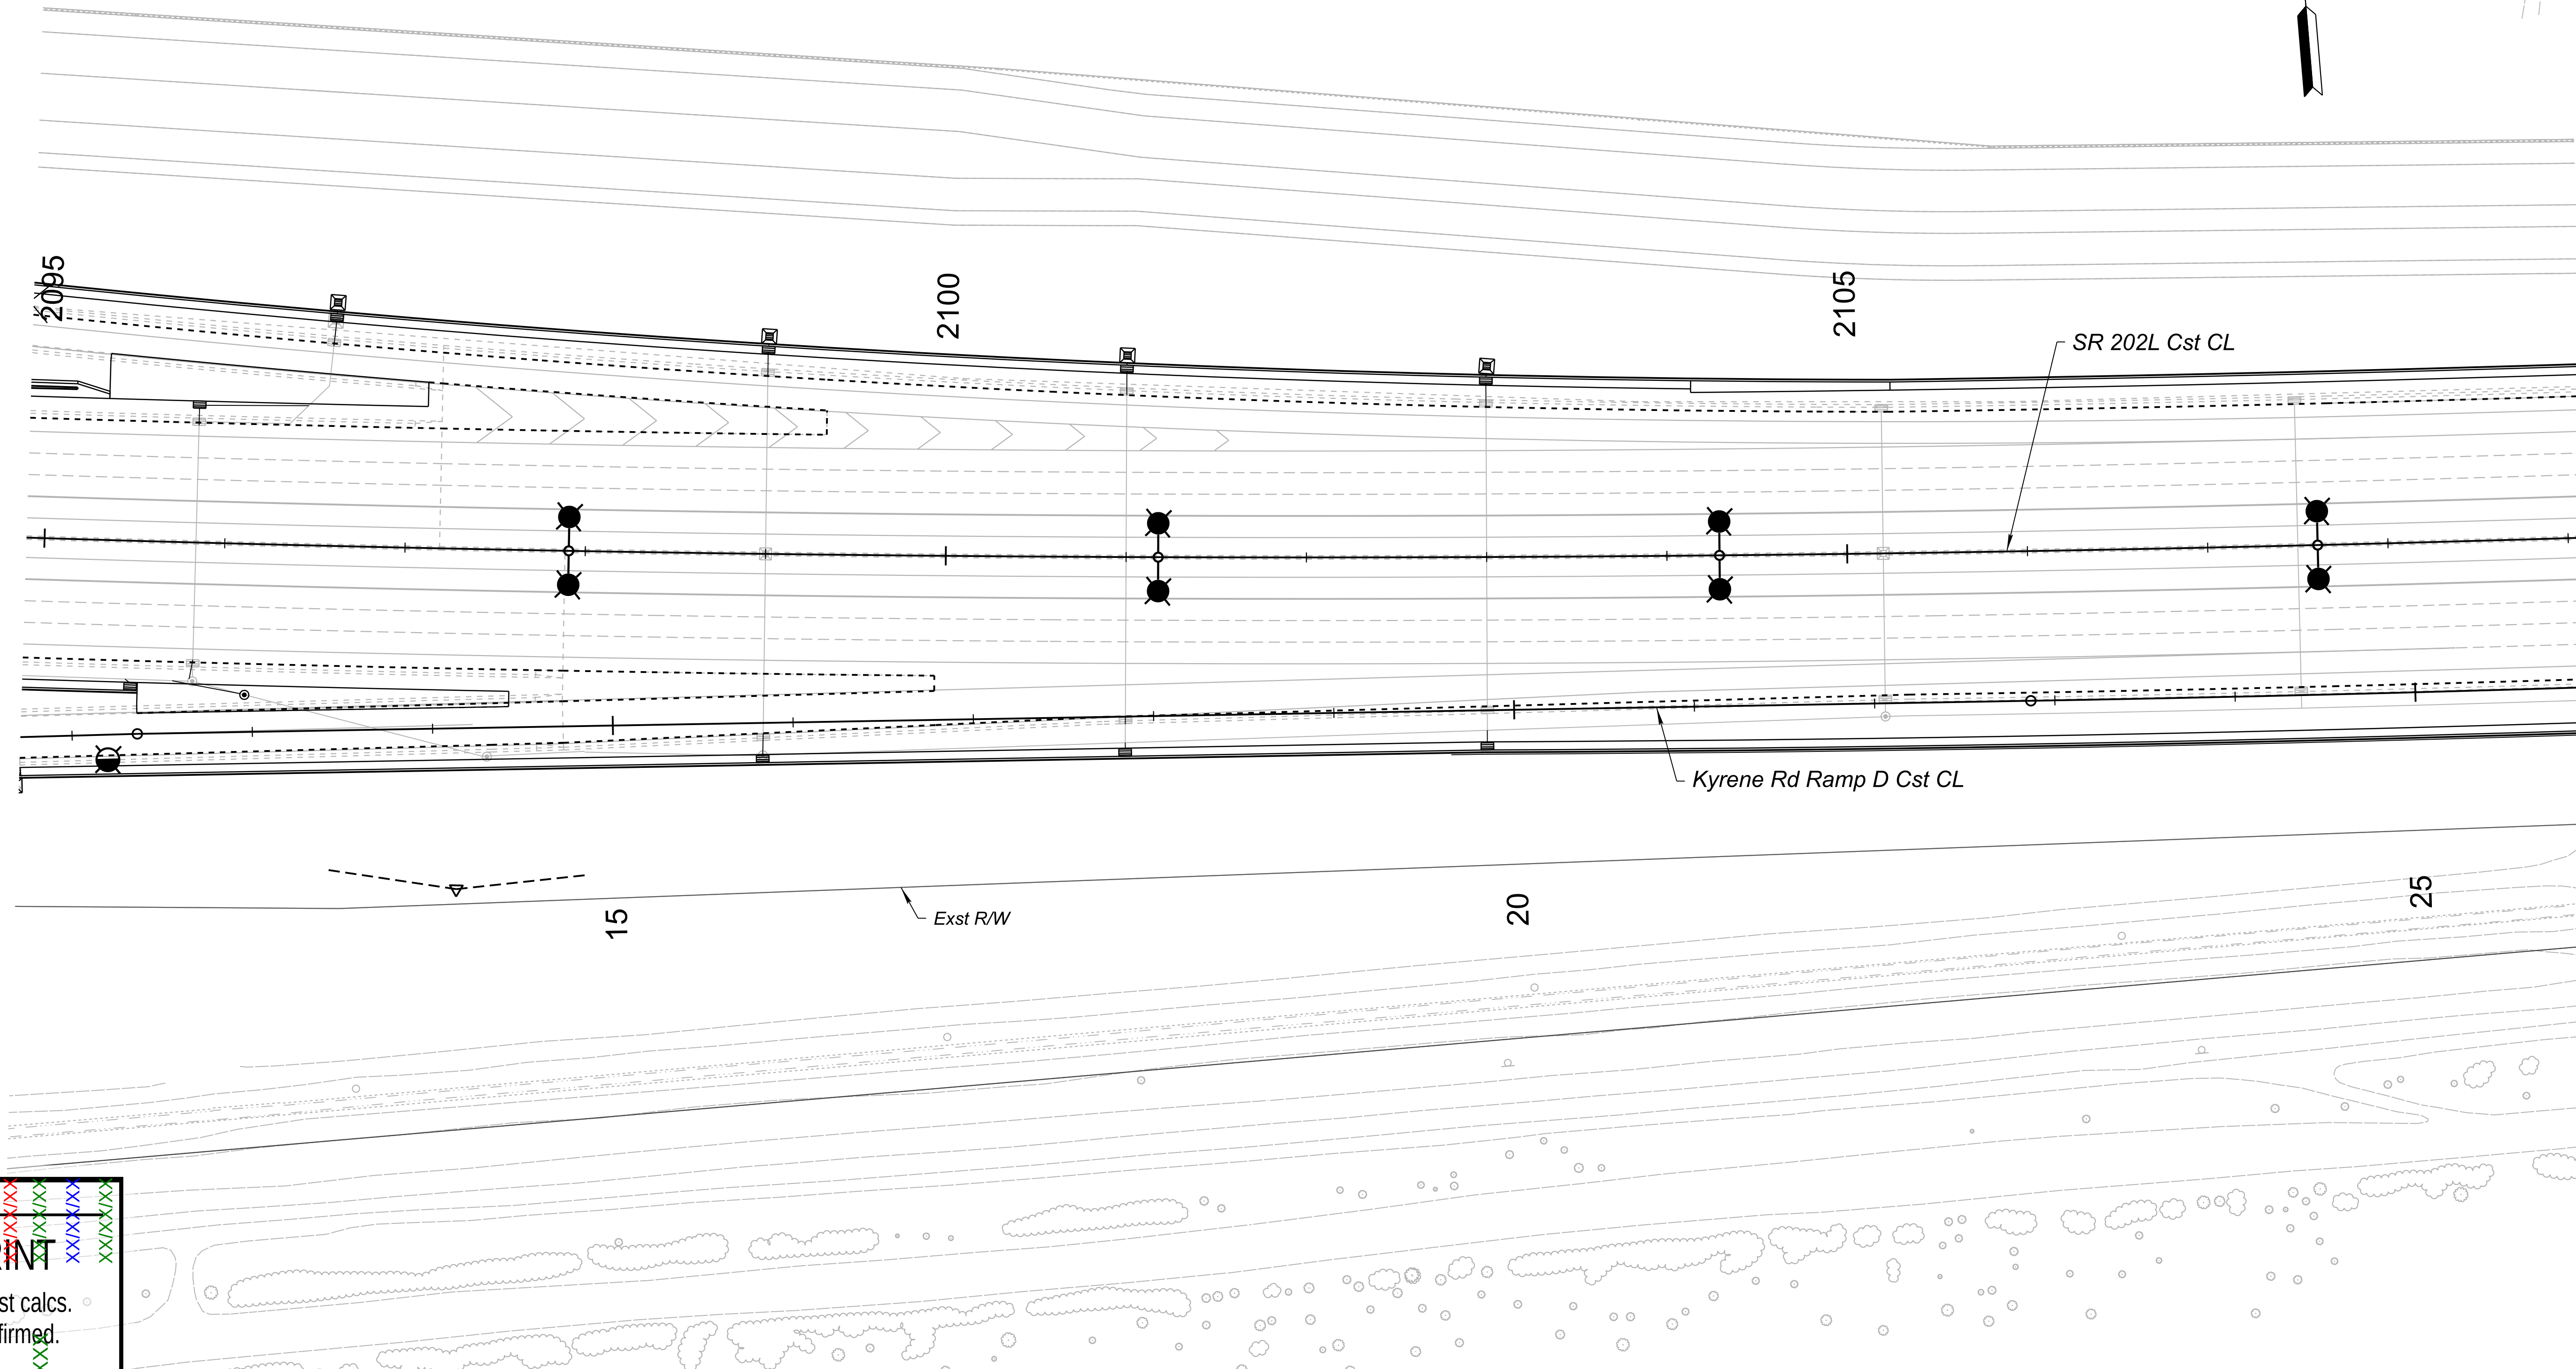


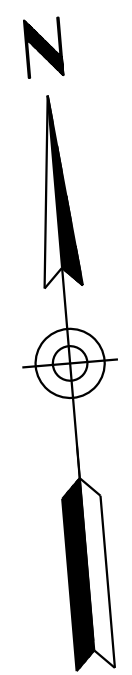

No. _____ Date _____

XXXXXXXX

CHECK PRINT

Dgn. checked against calcs.
and calc. check confirmed.

By _____ Date _____

Checked _____ Date _____

 
Backchecked _____ Date _____

Corrected _____ Date _____

Verified _____ Date _____

Jake Flint

2/11/2026 3:00:52 PM AZDOT 2024\AZFWY1704-FD02-SR202 - I-10 to SR101\CADD\Sheets\050_D-02.10_d0847dm.dgn

PRELIMINARY STAGE III Review NOT FOR CONSTRUCTION OR RECORDING	NAME		DATE	ARIZONA DEPARTMENT OF TRANSPORTATION PROJECT DELIVERY AND OPERATIONS DIVISION DRAINAGE DESIGN SECTION	ROUTE	F.H.W.A. Arizona Division	STATE ARIZ.	PROJECT NO.	FEDERAL ID NO.	SHEET NO.	TOTAL SHEETS	RECORD DRAWING
	DESIGN				SR 202L							
	DRAWN											
	CHECKED											
	 501 N 44th St, Suite 300 Phoenix, AZ 85008-4505 Tel (602) 454-0402 www.typpsa.us					MILEPOST	SR 202L SANTAN FREEWAY - I-10 TO SR 101L					
					STRUCTURE NO.	DWG No. D-02.10						
						TRACS NO. F0847 01D		___ OF ___				