
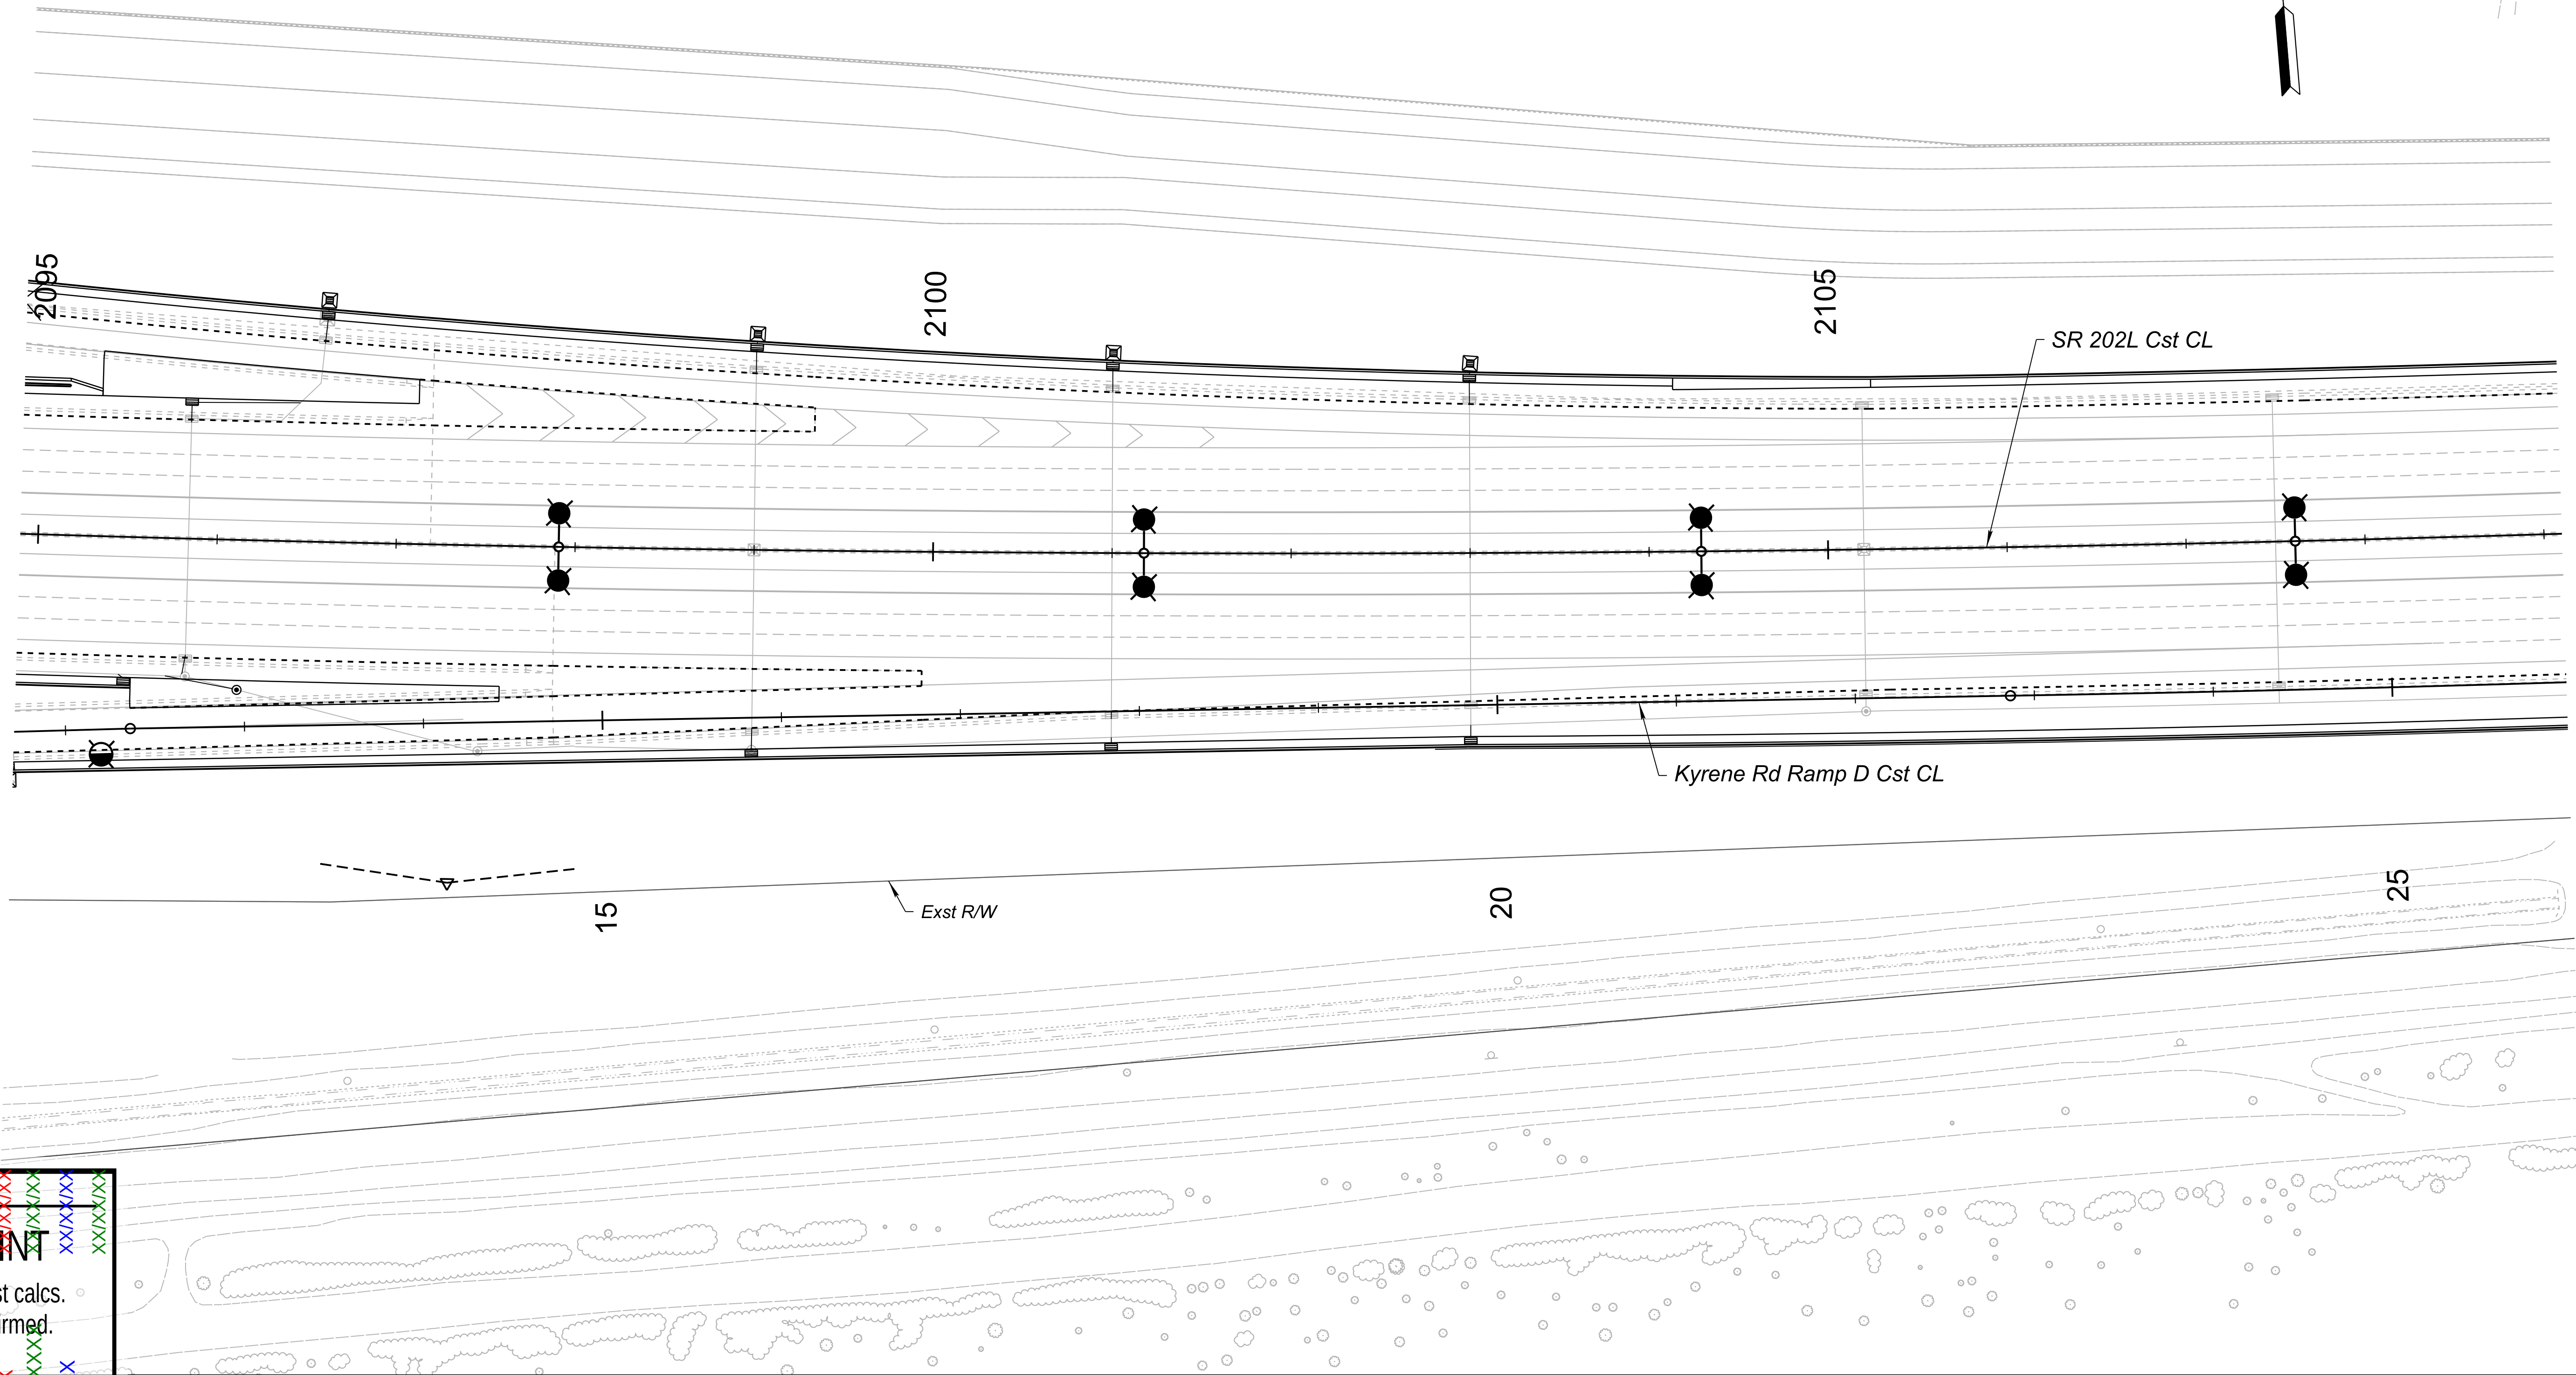


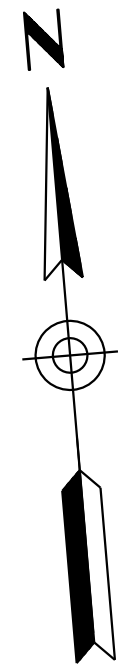

|                                                        |       |      |       |
|--------------------------------------------------------|-------|------|-------|
| No.                                                    | _____ | Date | _____ |
| <b>CHECK PRINT</b>                                     |       |      |       |
| Dgn. checked against calcs. and calc. check confirmed. |       |      |       |
| By                                                     | _____ | Date | _____ |

|             |       |      |       |
|-------------|-------|------|-------|
| Checked     | _____ | Date | _____ |
| Backchecked | _____ | Date | _____ |
| Corrected   | _____ | Date | _____ |
| Verified    | _____ | Date | _____ |

|                                                                                              |                                                                                                 |                                                                                           |                     |                                                                                                                    |         |                           |                |                                                          |                |                                                   |              |                |
|----------------------------------------------------------------------------------------------|-------------------------------------------------------------------------------------------------|-------------------------------------------------------------------------------------------|---------------------|--------------------------------------------------------------------------------------------------------------------|---------|---------------------------|----------------|----------------------------------------------------------|----------------|---------------------------------------------------|--------------|----------------|
| PRELIMINARY<br><b>STAGE III</b><br><br>Review<br><br>NOT FOR<br>CONSTRUCTION<br>OR RECORDING | NAME                                                                                            |                                                                                           | DATE                | ARIZONA DEPARTMENT OF TRANSPORTATION<br>PROJECT DELIVERY AND OPERATIONS DIVISION<br><b>DRAINAGE DESIGN SECTION</b> | ROUTE   | F.H.W.A. Arizona Division | STATE<br>ARIZ. | PROJECT NO.                                              | FEDERAL ID NO. | SHEET NO.                                         | TOTAL SHEETS | RECORD DRAWING |
|                                                                                              | DESIGN                                                                                          |                                                                                           |                     |                                                                                                                    | SR 202L |                           |                |                                                          |                |                                                   |              |                |
|                                                                                              | DRAWN                                                                                           |                                                                                           |                     |                                                                                                                    |         |                           |                |                                                          |                |                                                   |              |                |
|                                                                                              | CHECKED                                                                                         |                                                                                           |                     |                                                                                                                    |         |                           |                |                                                          |                |                                                   |              |                |
|                                                                                              | <br>TYPESA | 501 N 44th St, Suite 300<br>Phoenix, AZ 85008-4505<br>Tel (602) 454-0402<br>www.typsas.us |                     |                                                                                                                    |         |                           |                | SR 202L<br>DRAINAGE PLAN SHEET<br>STA 2095+00 TO 2109+00 | MILEPOST       | LOCATION SR 202L SANTAN FREEWAY - I-10 TO SR 101L |              |                |
|                                                                                              |                                                                                                 | STRUCTURE NO.                                                                             | TRACS NO. F0847 01D |                                                                                                                    |         |                           |                |                                                          |                | ___ OF ___                                        |              |                |
|                                                                                              |                                                                                                 |                                                                                           |                     |                                                                                                                    |         |                           |                |                                                          |                |                                                   |              |                |