


NO.	DESCRIPTION OF REVISIONS	MADE BY	DATE
R00	RFC RELEASE	TM	08/18/25

SURVEY NO.	FINISHED PLANS	REVISIONS	LOCATION	DATE

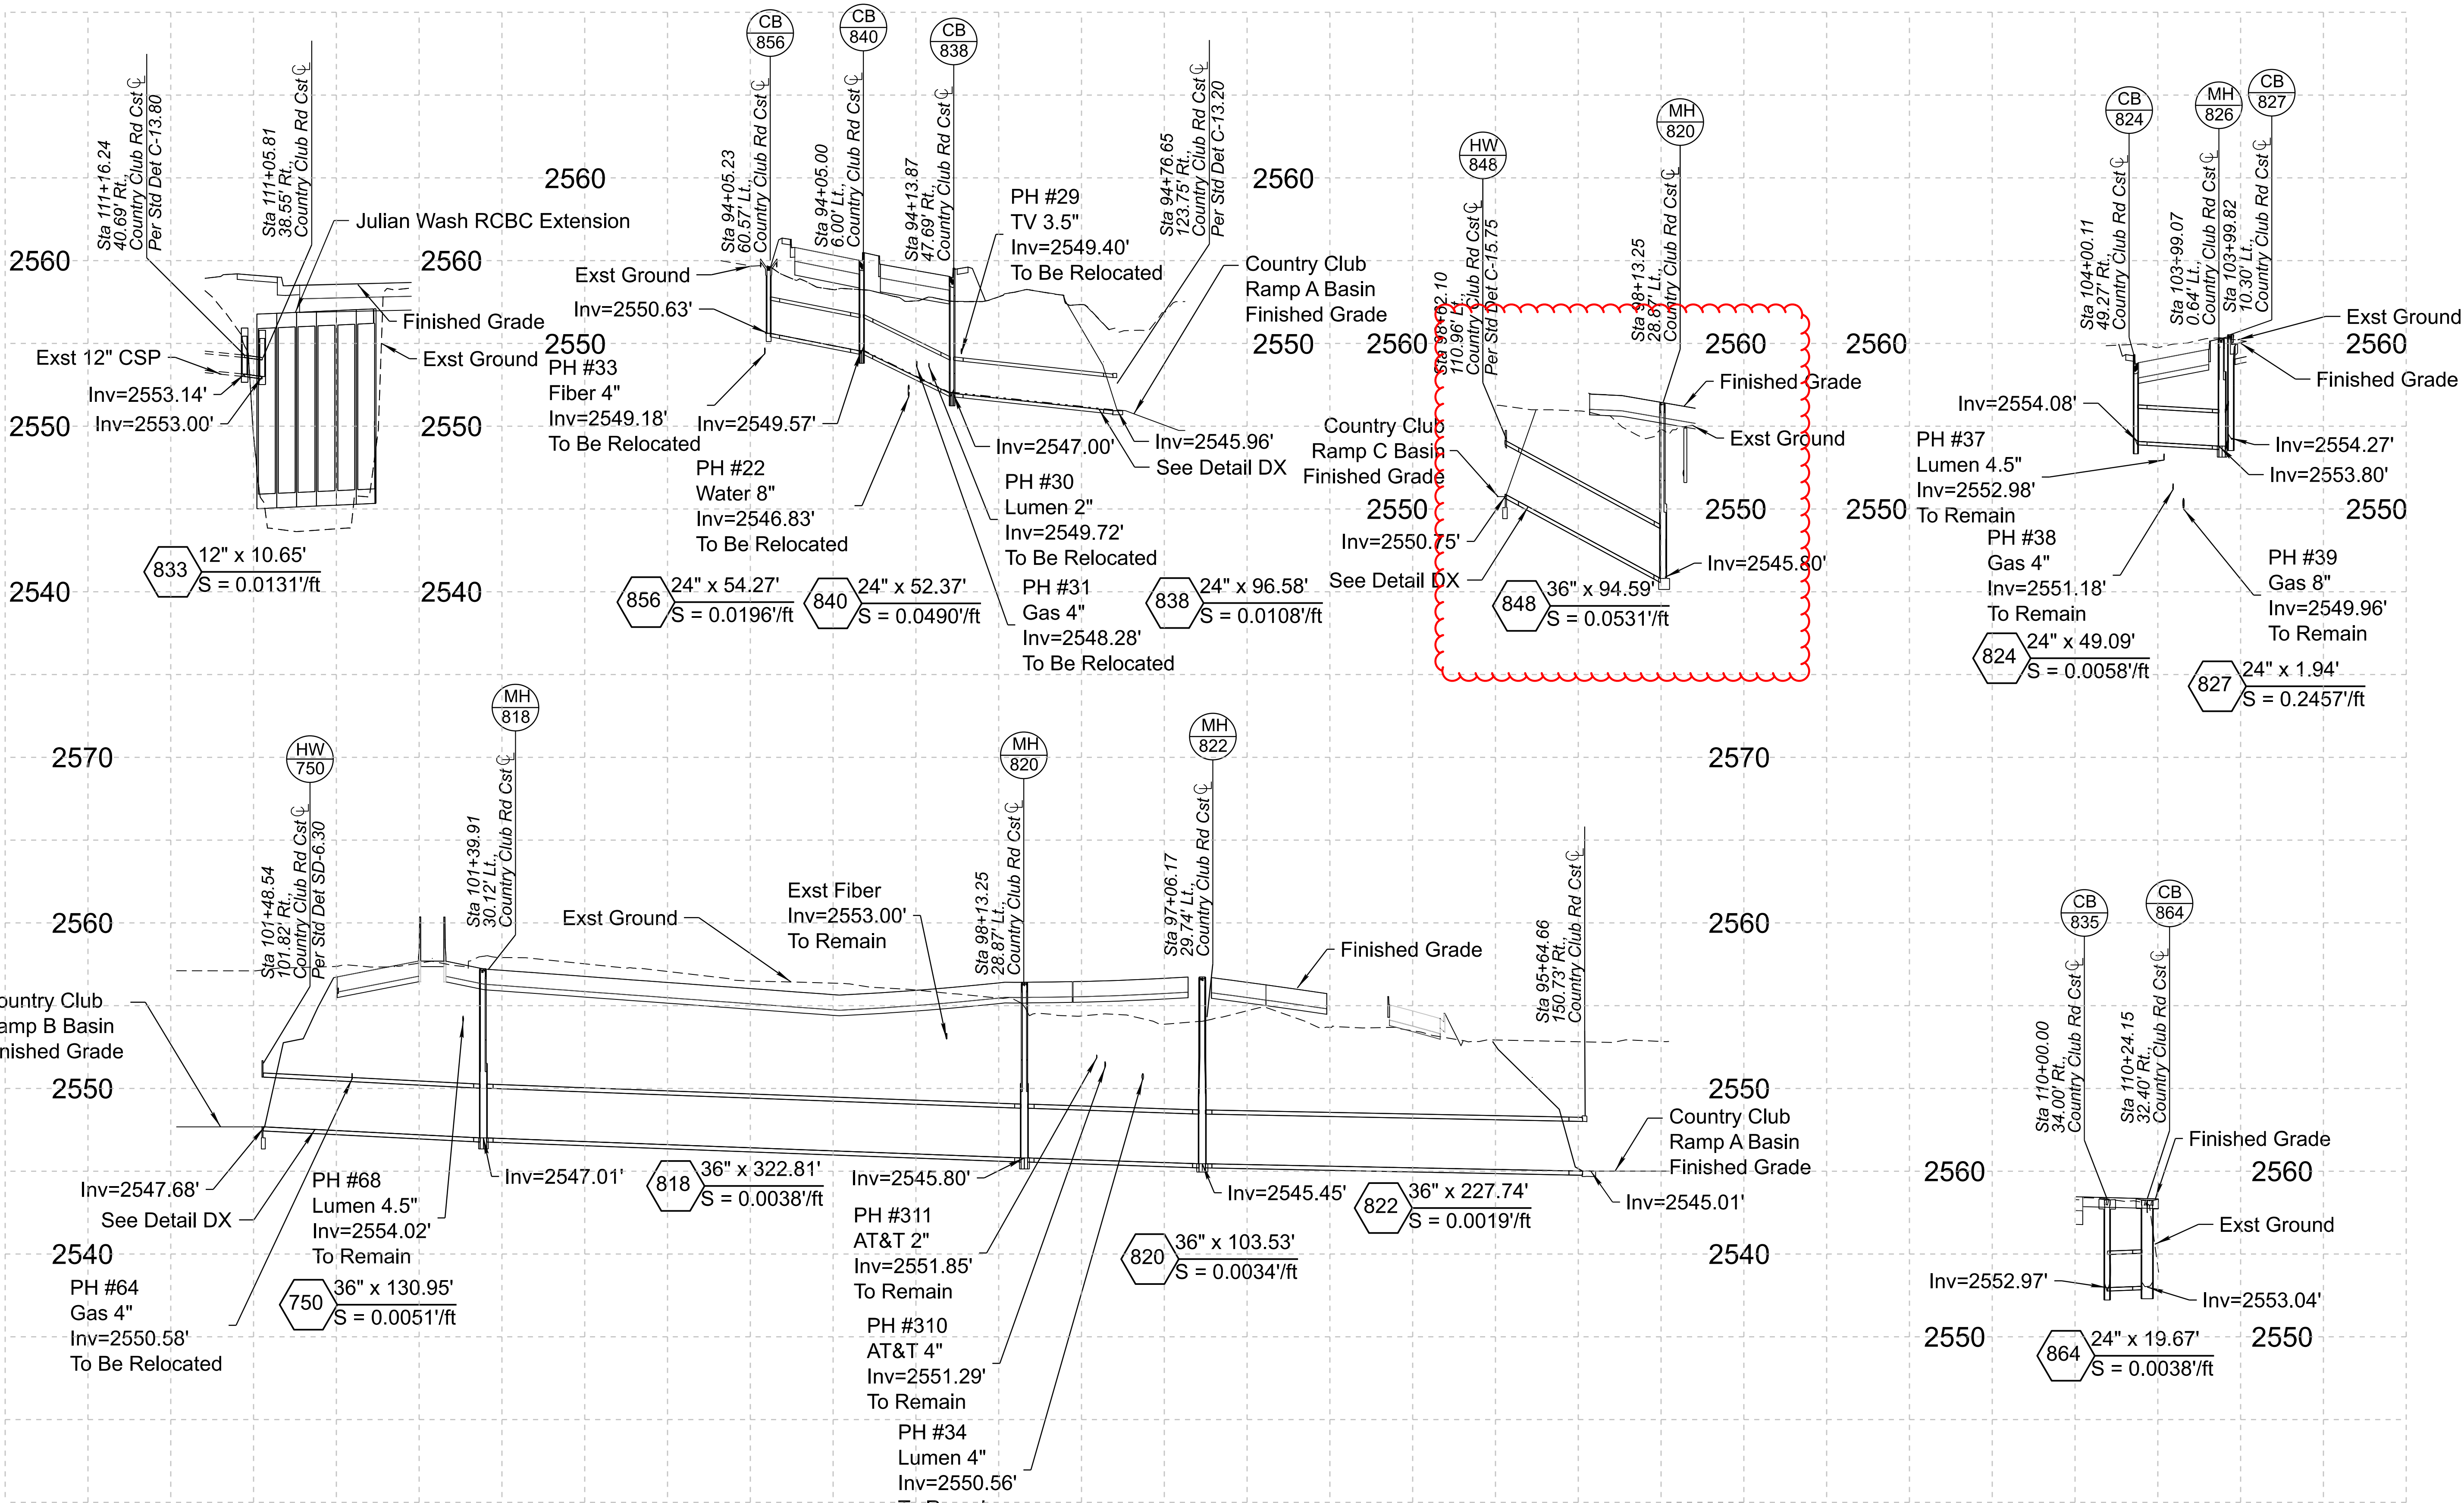

						DRAINAGE PROFILE SHEET	ROUTE	F.H.W.A. Arizona Division	STATE	PROJECT NO.	FEDERAL ID NO.	SHEET NO.	TOTAL SHEETS	RECORD DRAWING
							I-10			010 PM 262	010-E(232)S			
							MILEPOST			LOCATION I-10 COUNTRY CLUB RD AND KINO PKWY TIS				DWG NO. D-02.22
							STRUCTURE NO.			TRACS NO. F0548 01C				___ OF ___