


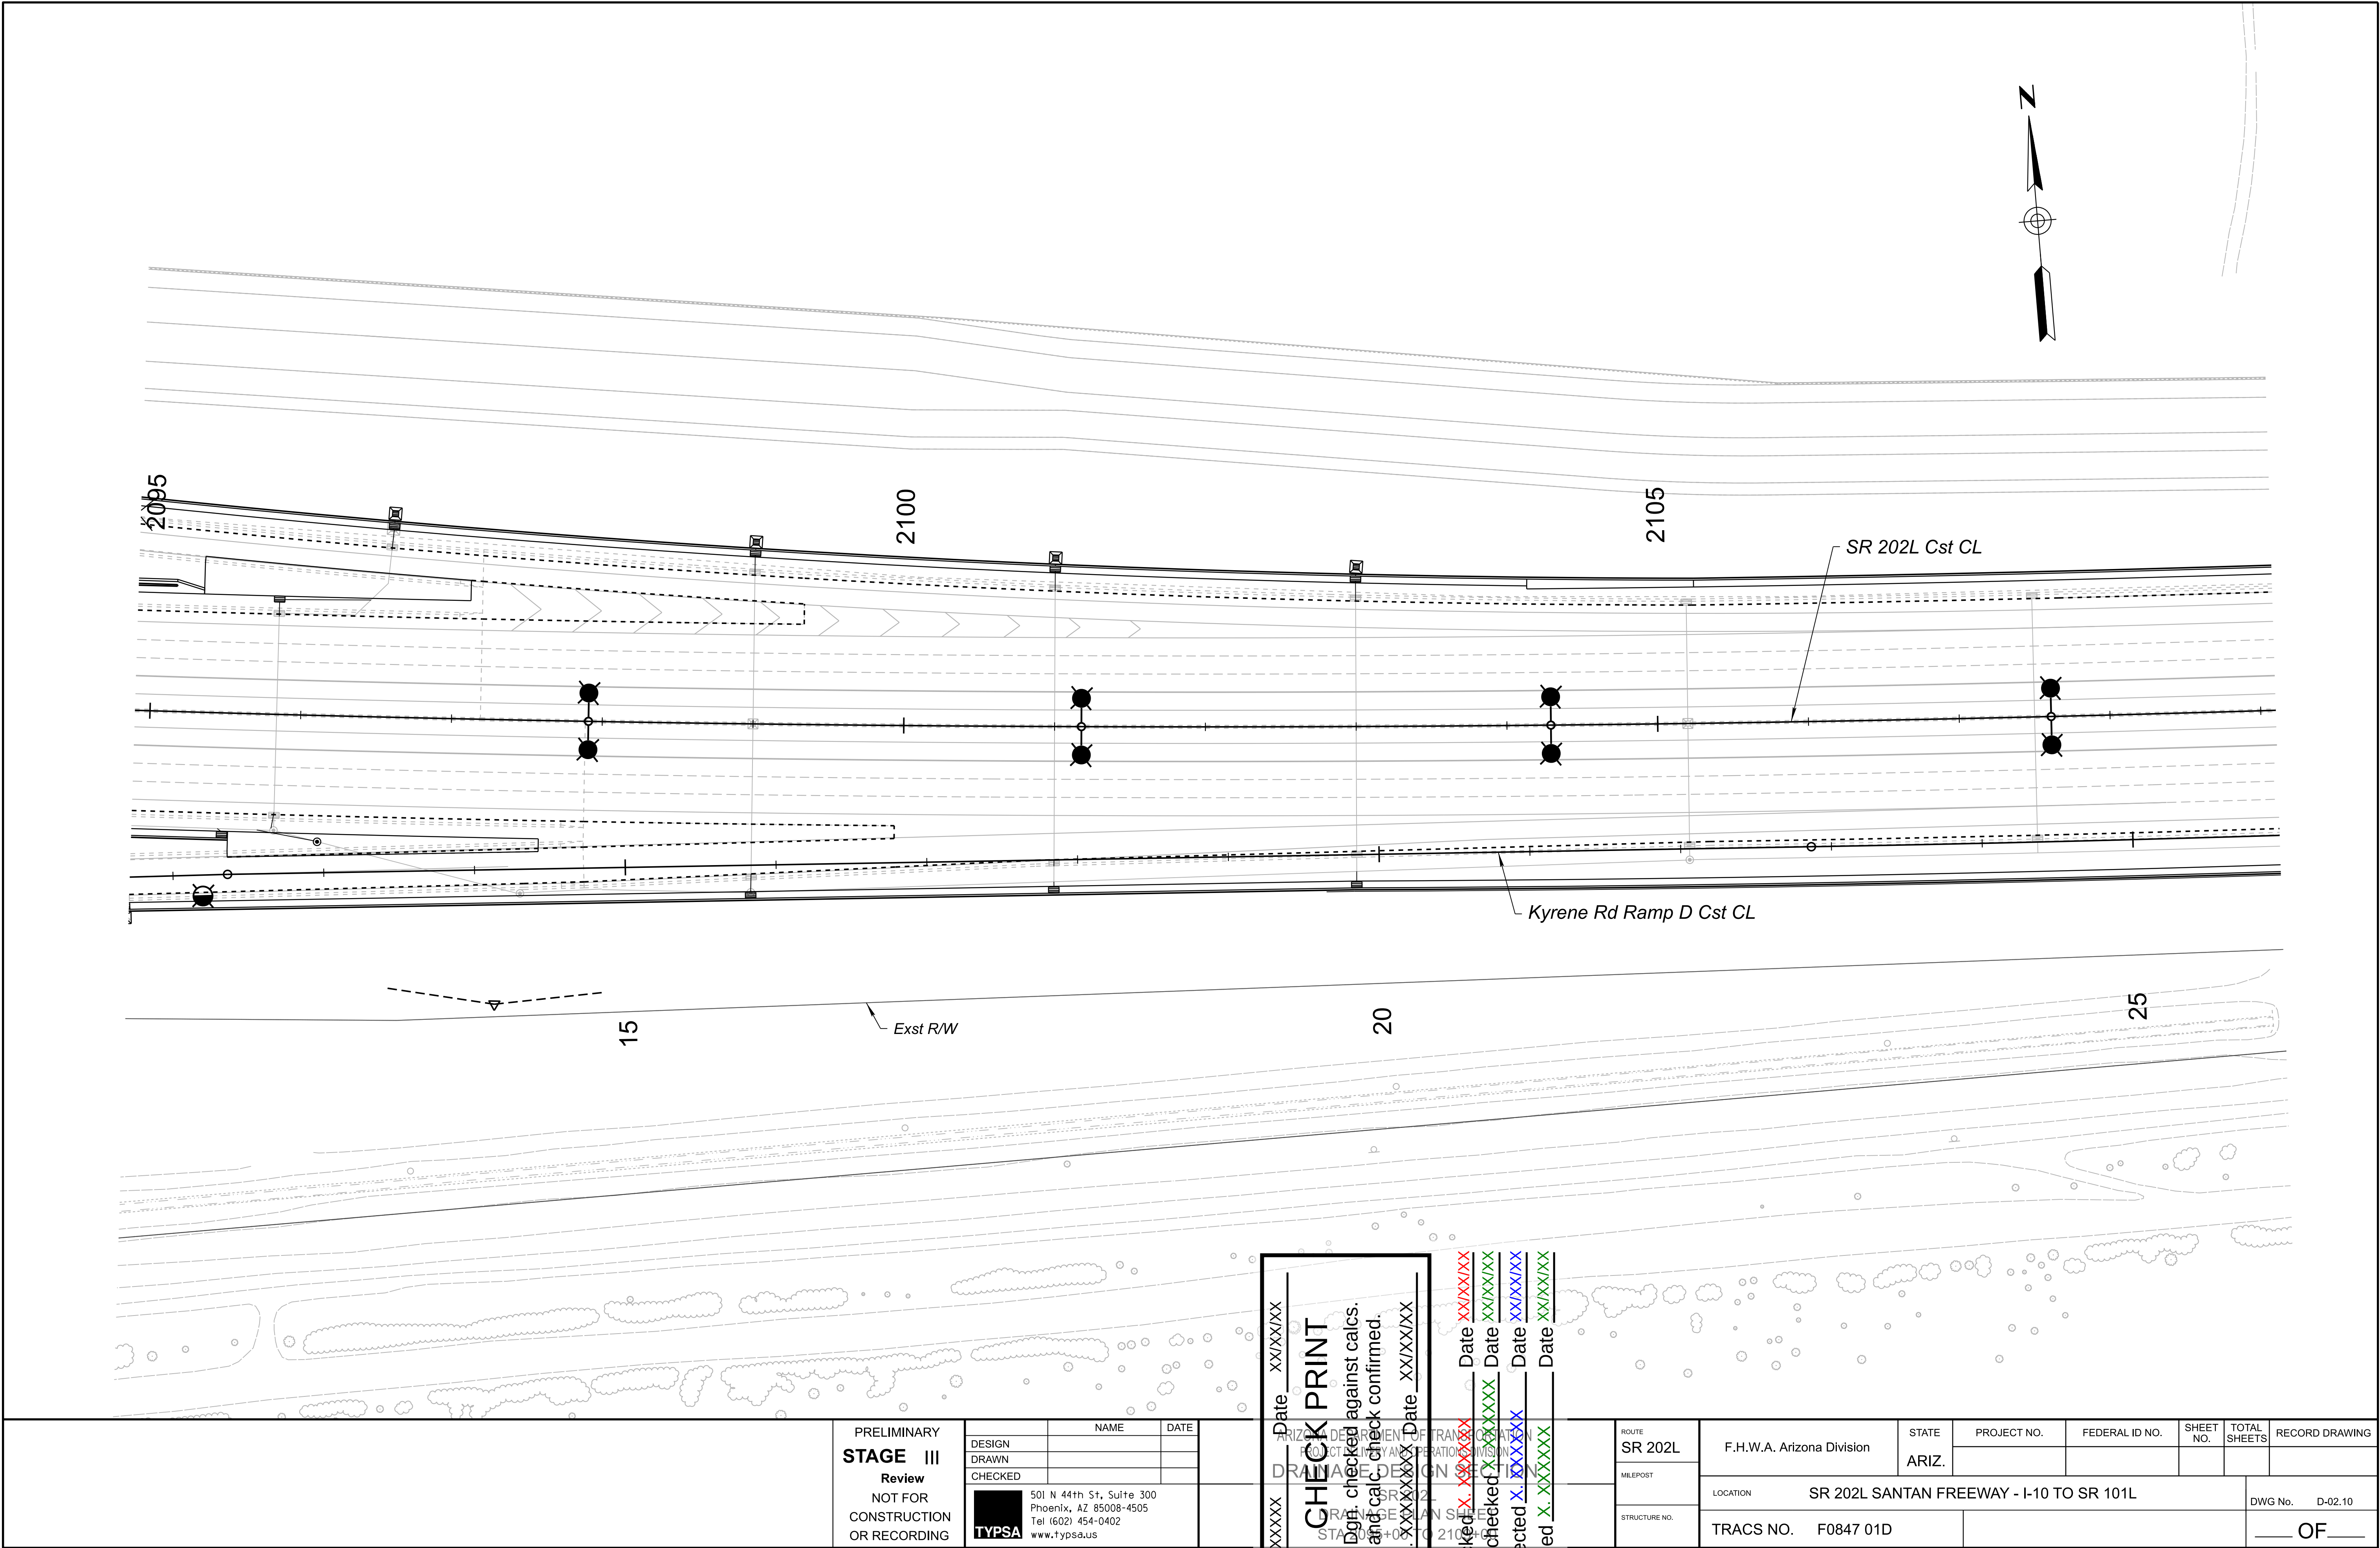

|                                                                                                                                                                                           |             |                                                                          |                |                                                                                                         |                |           |              |                 |
|-------------------------------------------------------------------------------------------------------------------------------------------------------------------------------------------|-------------|--------------------------------------------------------------------------|----------------|---------------------------------------------------------------------------------------------------------|----------------|-----------|--------------|-----------------|
| <div>PRELIMINARY<br/><b>STAGE III</b><br/>Review<br/>NOT FOR<br/>CONSTRUCTION<br/>OR RECORDING</div>                                                                                      | DESIGN      | NAME                                                                     | DATE           | <div>501 N 44th St, Suite 300<br/>Phoenix, AZ 85008-4505<br/>Tel (602) 454-0402<br/>www.typpsa.us</div> |                |           |              |                 |
|                                                                                                                                                                                           | DRAWN       |                                                                          |                |                                                                                                         |                |           |              |                 |
|                                                                                                                                                                                           | CHECKED     |                                                                          |                |                                                                                                         |                |           |              |                 |
|                                                                                                                                                                                           | TYPESA      |                                                                          |                |                                                                                                         |                |           |              |                 |
| <div>ARIZONA DEPARTMENT OF TRANSPORTATION<br/>PROJECT TECHNICAL OPERATIONS DIVISION<br/>DRAINAGE DESIGN<br/>SR 202L SANTAN FREEWAY - I-10 TO SR 101L<br/>STATION 2095+00 TO 2105+00</div> |             |                                                                          |                |                                                                                                         |                |           |              |                 |
| No. XXXXX                                                                                                                                                                                 | Date XXXXXX | CHECK PRINT<br>Dgn. checked against calcs.<br>and calc. check confirmed. |                |                                                                                                         |                |           |              |                 |
| By: XXXXXX                                                                                                                                                                                | Date XXXXXX |                                                                          |                |                                                                                                         |                |           |              |                 |
| Checked <del>X</del> XXXXX                                                                                                                                                                | Date XXXXXX |                                                                          |                |                                                                                                         |                |           |              |                 |
| Backchecked <del>X</del> XXXXX                                                                                                                                                            | Date XXXXXX |                                                                          |                |                                                                                                         |                |           |              |                 |
| Corrected <del>X</del> XXXXX                                                                                                                                                              | Date XXXXXX |                                                                          |                |                                                                                                         |                |           |              |                 |
| Verified <del>X</del> XXXXX                                                                                                                                                               | Date XXXXXX |                                                                          |                |                                                                                                         |                |           |              |                 |
| ROUTE<br>SR 202L                                                                                                                                                                          |             | F.H.W.A. Arizona Division                                                | STATE<br>ARIZ. | PROJECT NO.                                                                                             | FEDERAL ID NO. | SHEET NO. | TOTAL SHEETS | RECORD DRAWING  |
| MILEPOST                                                                                                                                                                                  |             | LOCATION<br>SR 202L SANTAN FREEWAY - I-10 TO SR 101L                     |                |                                                                                                         |                |           |              | DWG No. D-02.10 |
| STRUCTURE NO.                                                                                                                                                                             |             | TRACS NO. F0847 01D                                                      |                |                                                                                                         |                |           |              | OF              |