


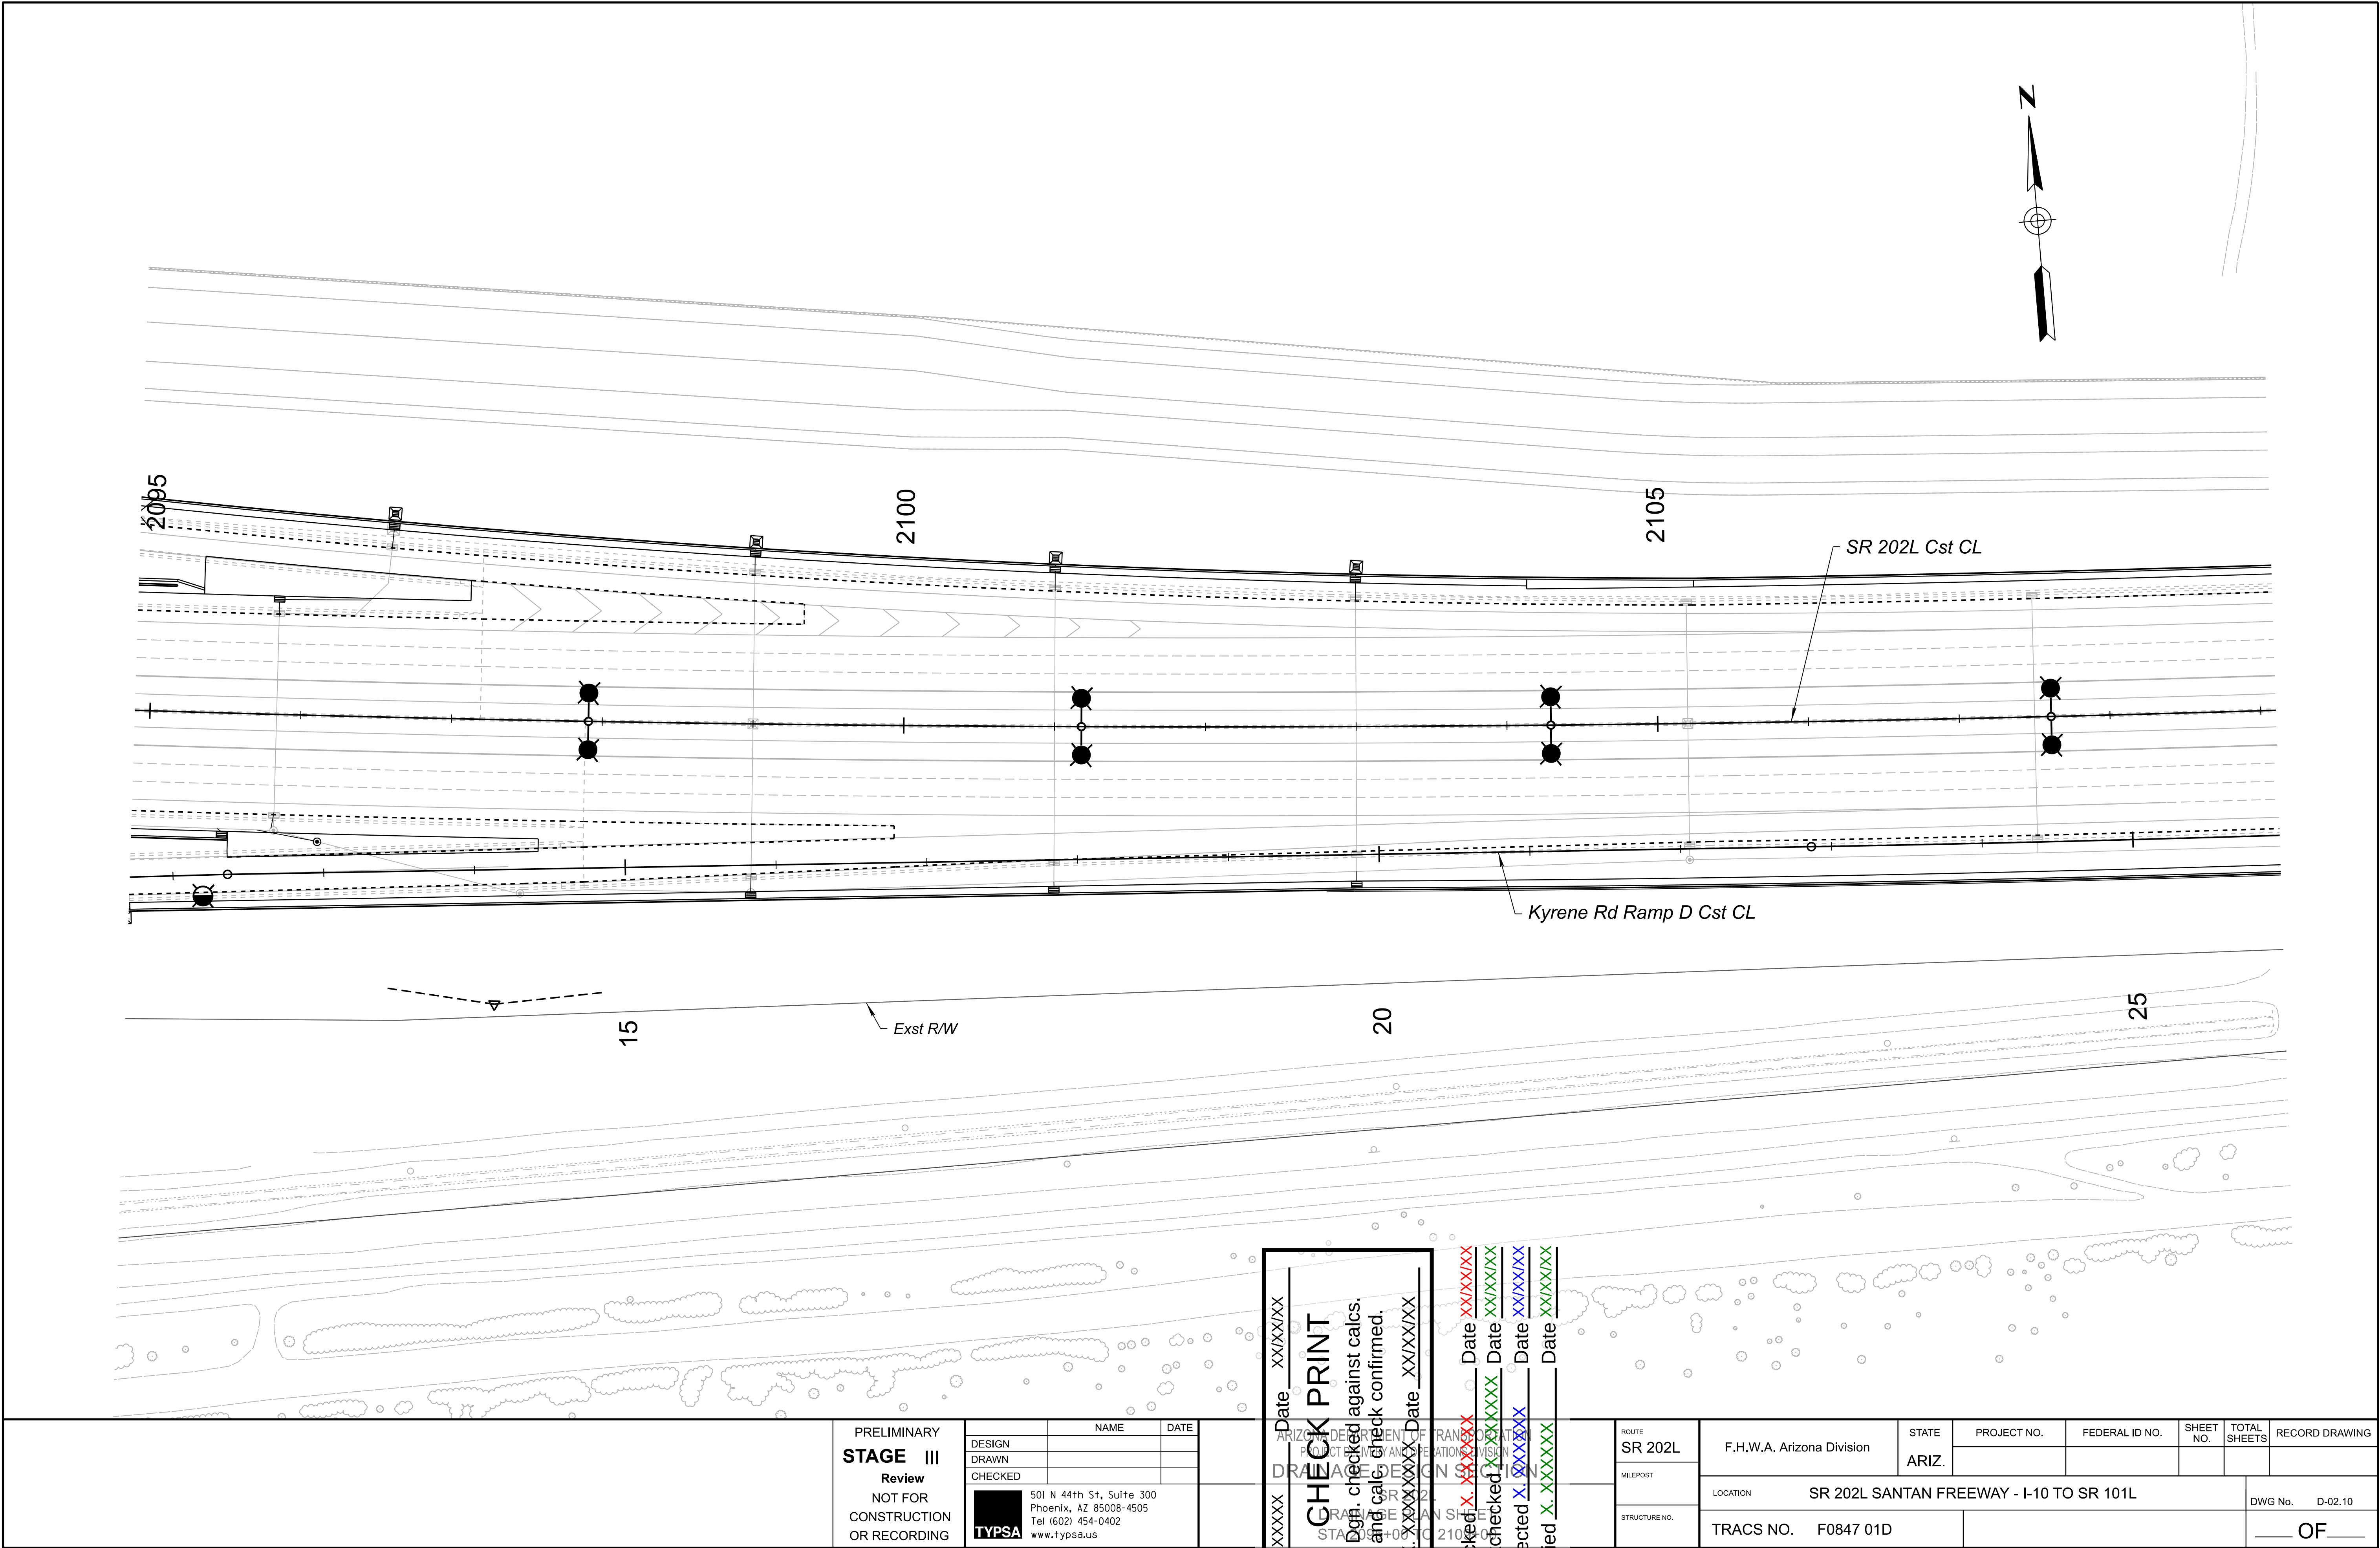

PRELIMINARY
STAGE III
Review
NOT FOR
CONSTRUCTION
OR RECORDING

DESIGN	NAME	DATE
DRAWN		
CHECKED		
TYPESA	501 N 44th St, Suite 300 Phoenix, AZ 85008-4505 Tel (602) 454-0402 www.typsas.us	

No.	XXXXX	Date	XXXXXX	
CHECK PRINT				
Dgn. checked against calcs. and calc. check confirmed.				
By	X	XXXXXX	Date	XX/XX/XX

Checked	X	XXXXXX	Date	XX/XX/XX
Backchecked	X	XXXXXX	Date	XX/XX/XX
Corrected	X	XXXXXX	Date	XX/XX/XX
Verified	X	XXXXXX	Date	XX/XX/XX

ROUTE SR 202L	F.H.W.A. Arizona Division	STATE ARIZ.	PROJECT NO.	FEDERAL ID NO.	SHEET NO.	TOTAL SHEETS	RECORD DRAWING
MILEPOST	LOCATION SR 202L SANTAN FREEWAY - I-10 TO SR 101L						
STRUCTURE NO.	TRACS NO. F0847 01D						DWG No. D-02.10 ____ OF ____