


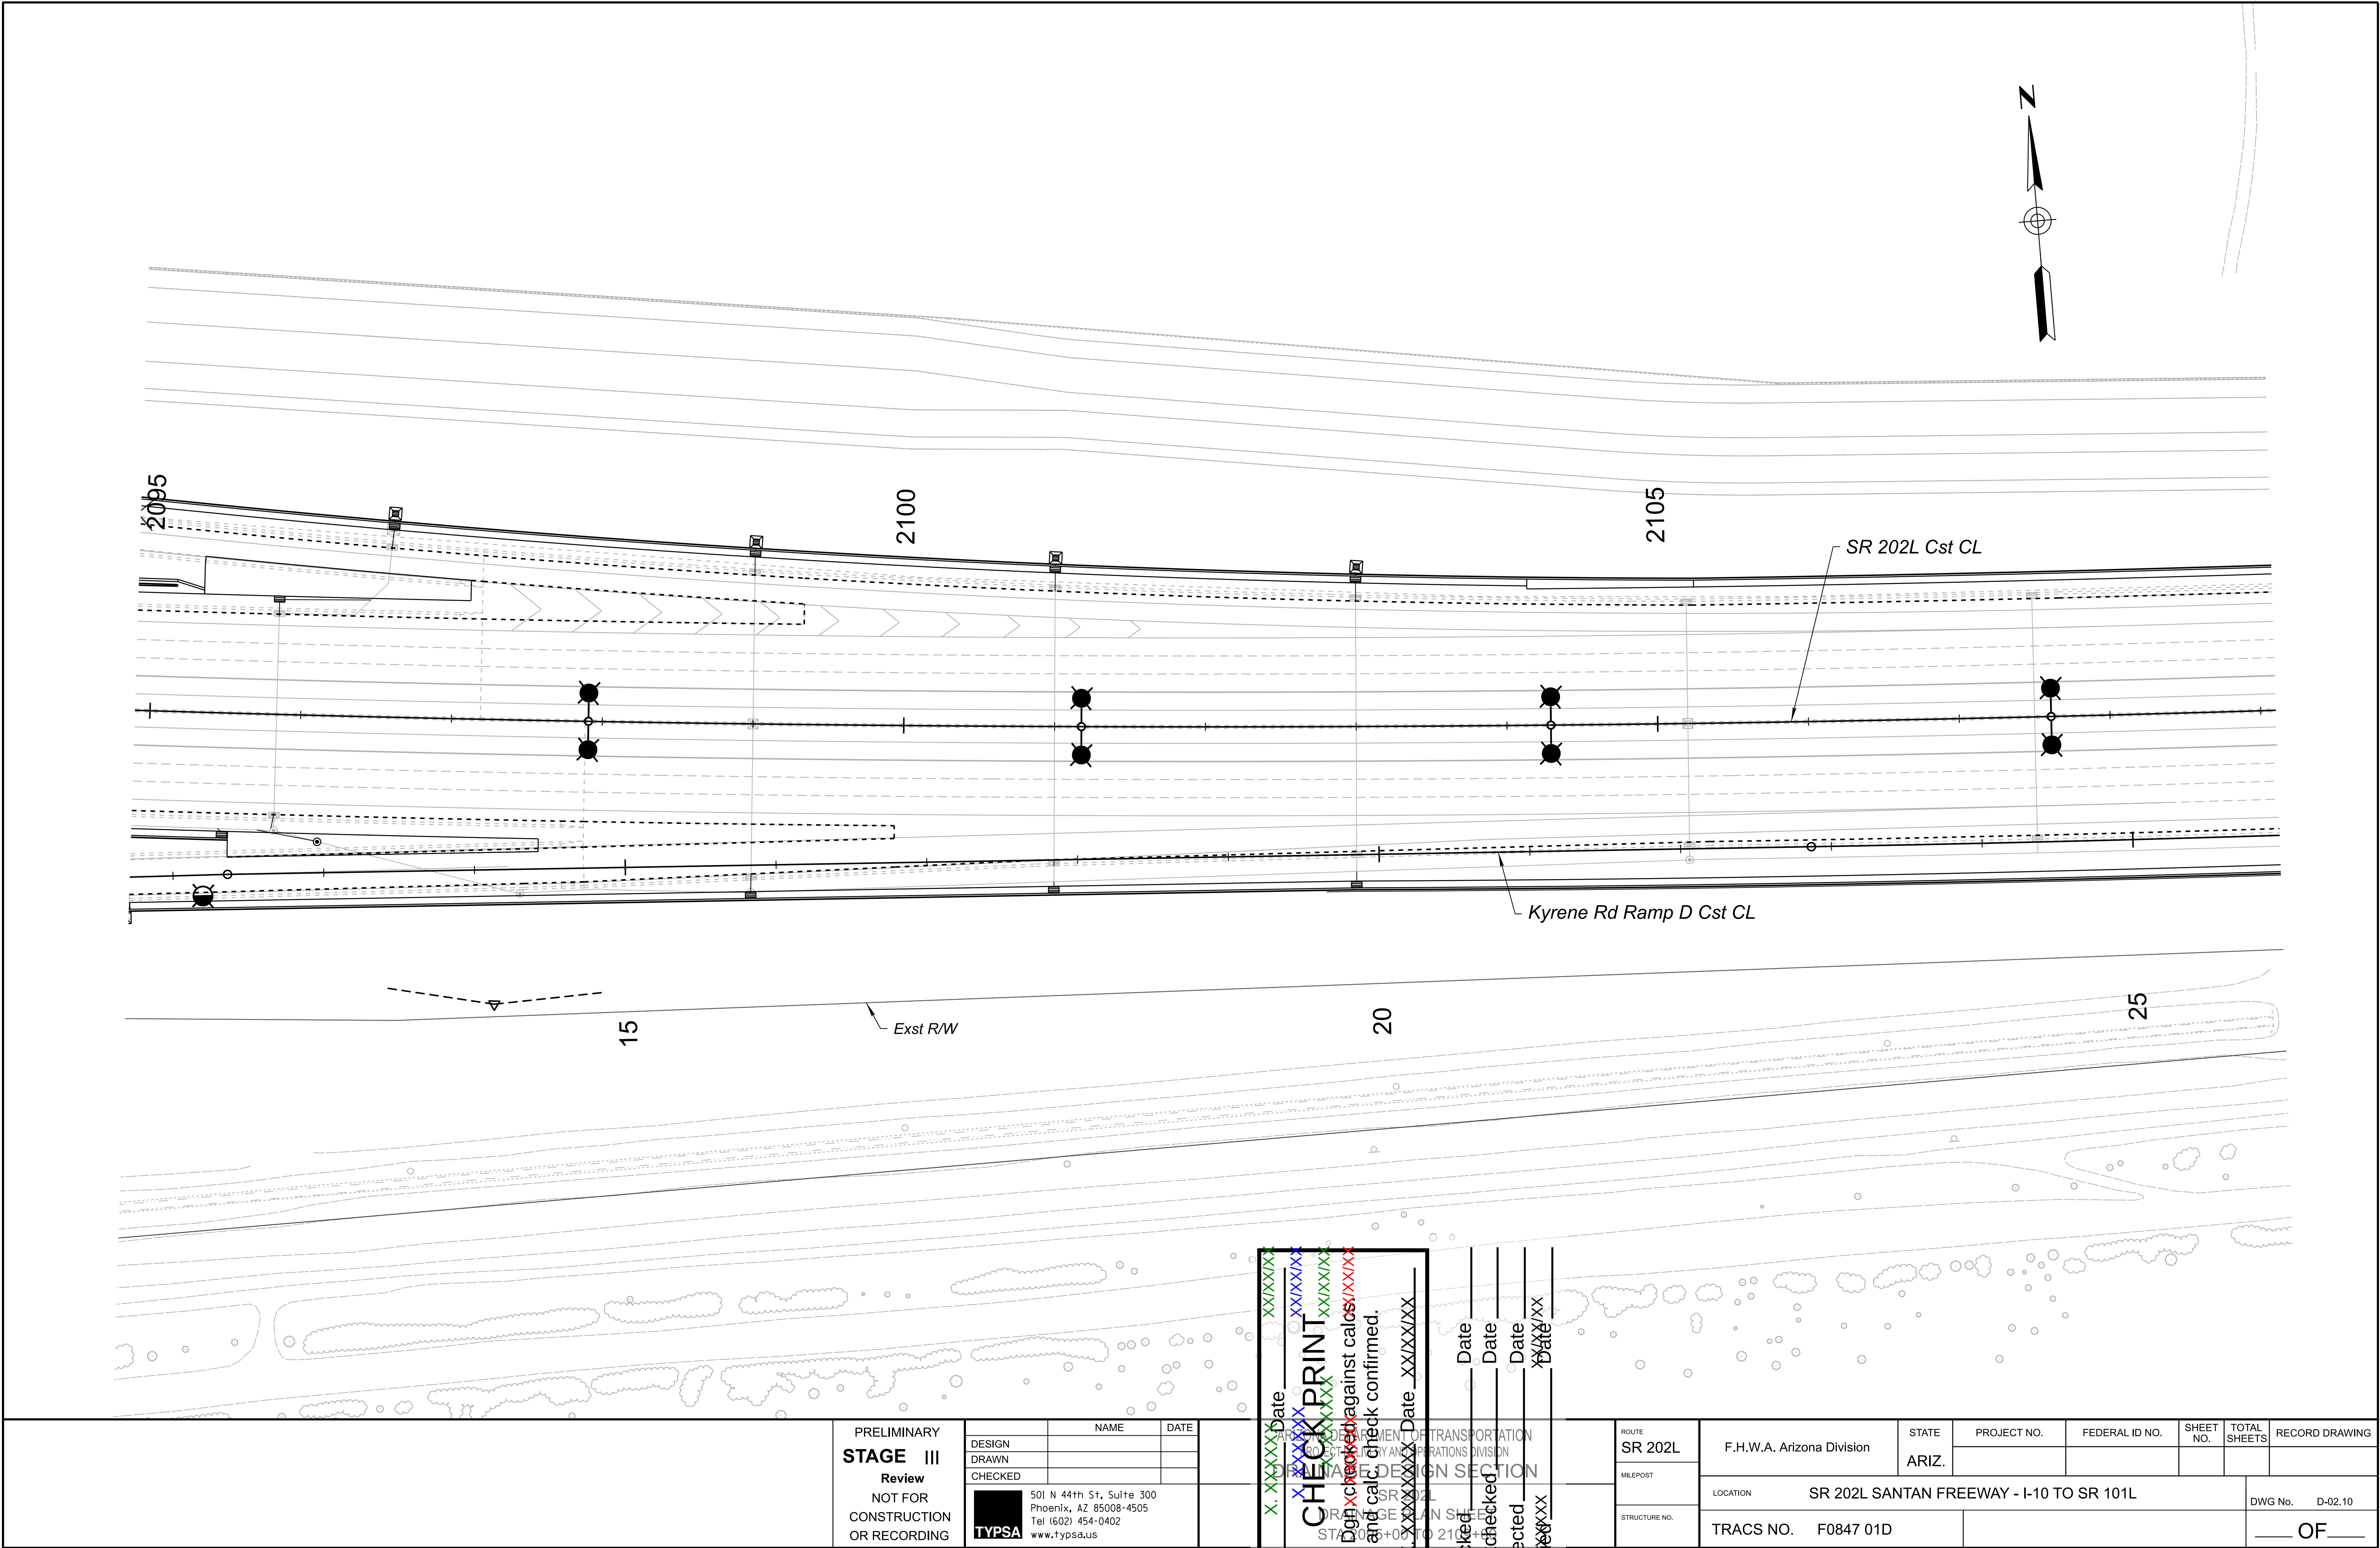

PRELIMINARY
STAGE III
Review
NOT FOR
CONSTRUCTION
OR RECORDING

DESIGN	NAME	DATE
DRAWN		
CHECKED		
	501 N 44th St, Suite 300 Phoenix, AZ 85008-4505 Tel (602) 454-0402 www.typsa.us	

No. _____ Date _____
CHECK PRINT
Do not check against calos and cal check confirmed.
By _____ Date _____

Checked _____ Date _____
Backchecked _____ Date _____
Corrected _____ Date _____
Verified _____ Date _____

ROUTE	F.H.W.A. Arizona Division	STATE	PROJECT NO.	FEDERAL ID NO.	SHEET NO.	TOTAL SHEETS	RECORD DRAWING
SR 202L		ARIZ.					
MILEPOST	SR 202L SANTAN FREEWAY - I-10 TO SR 101L						
STRUCTURE NO.	DWG No. D-02.10						
	TRACS NO. F0847 01D						OF