


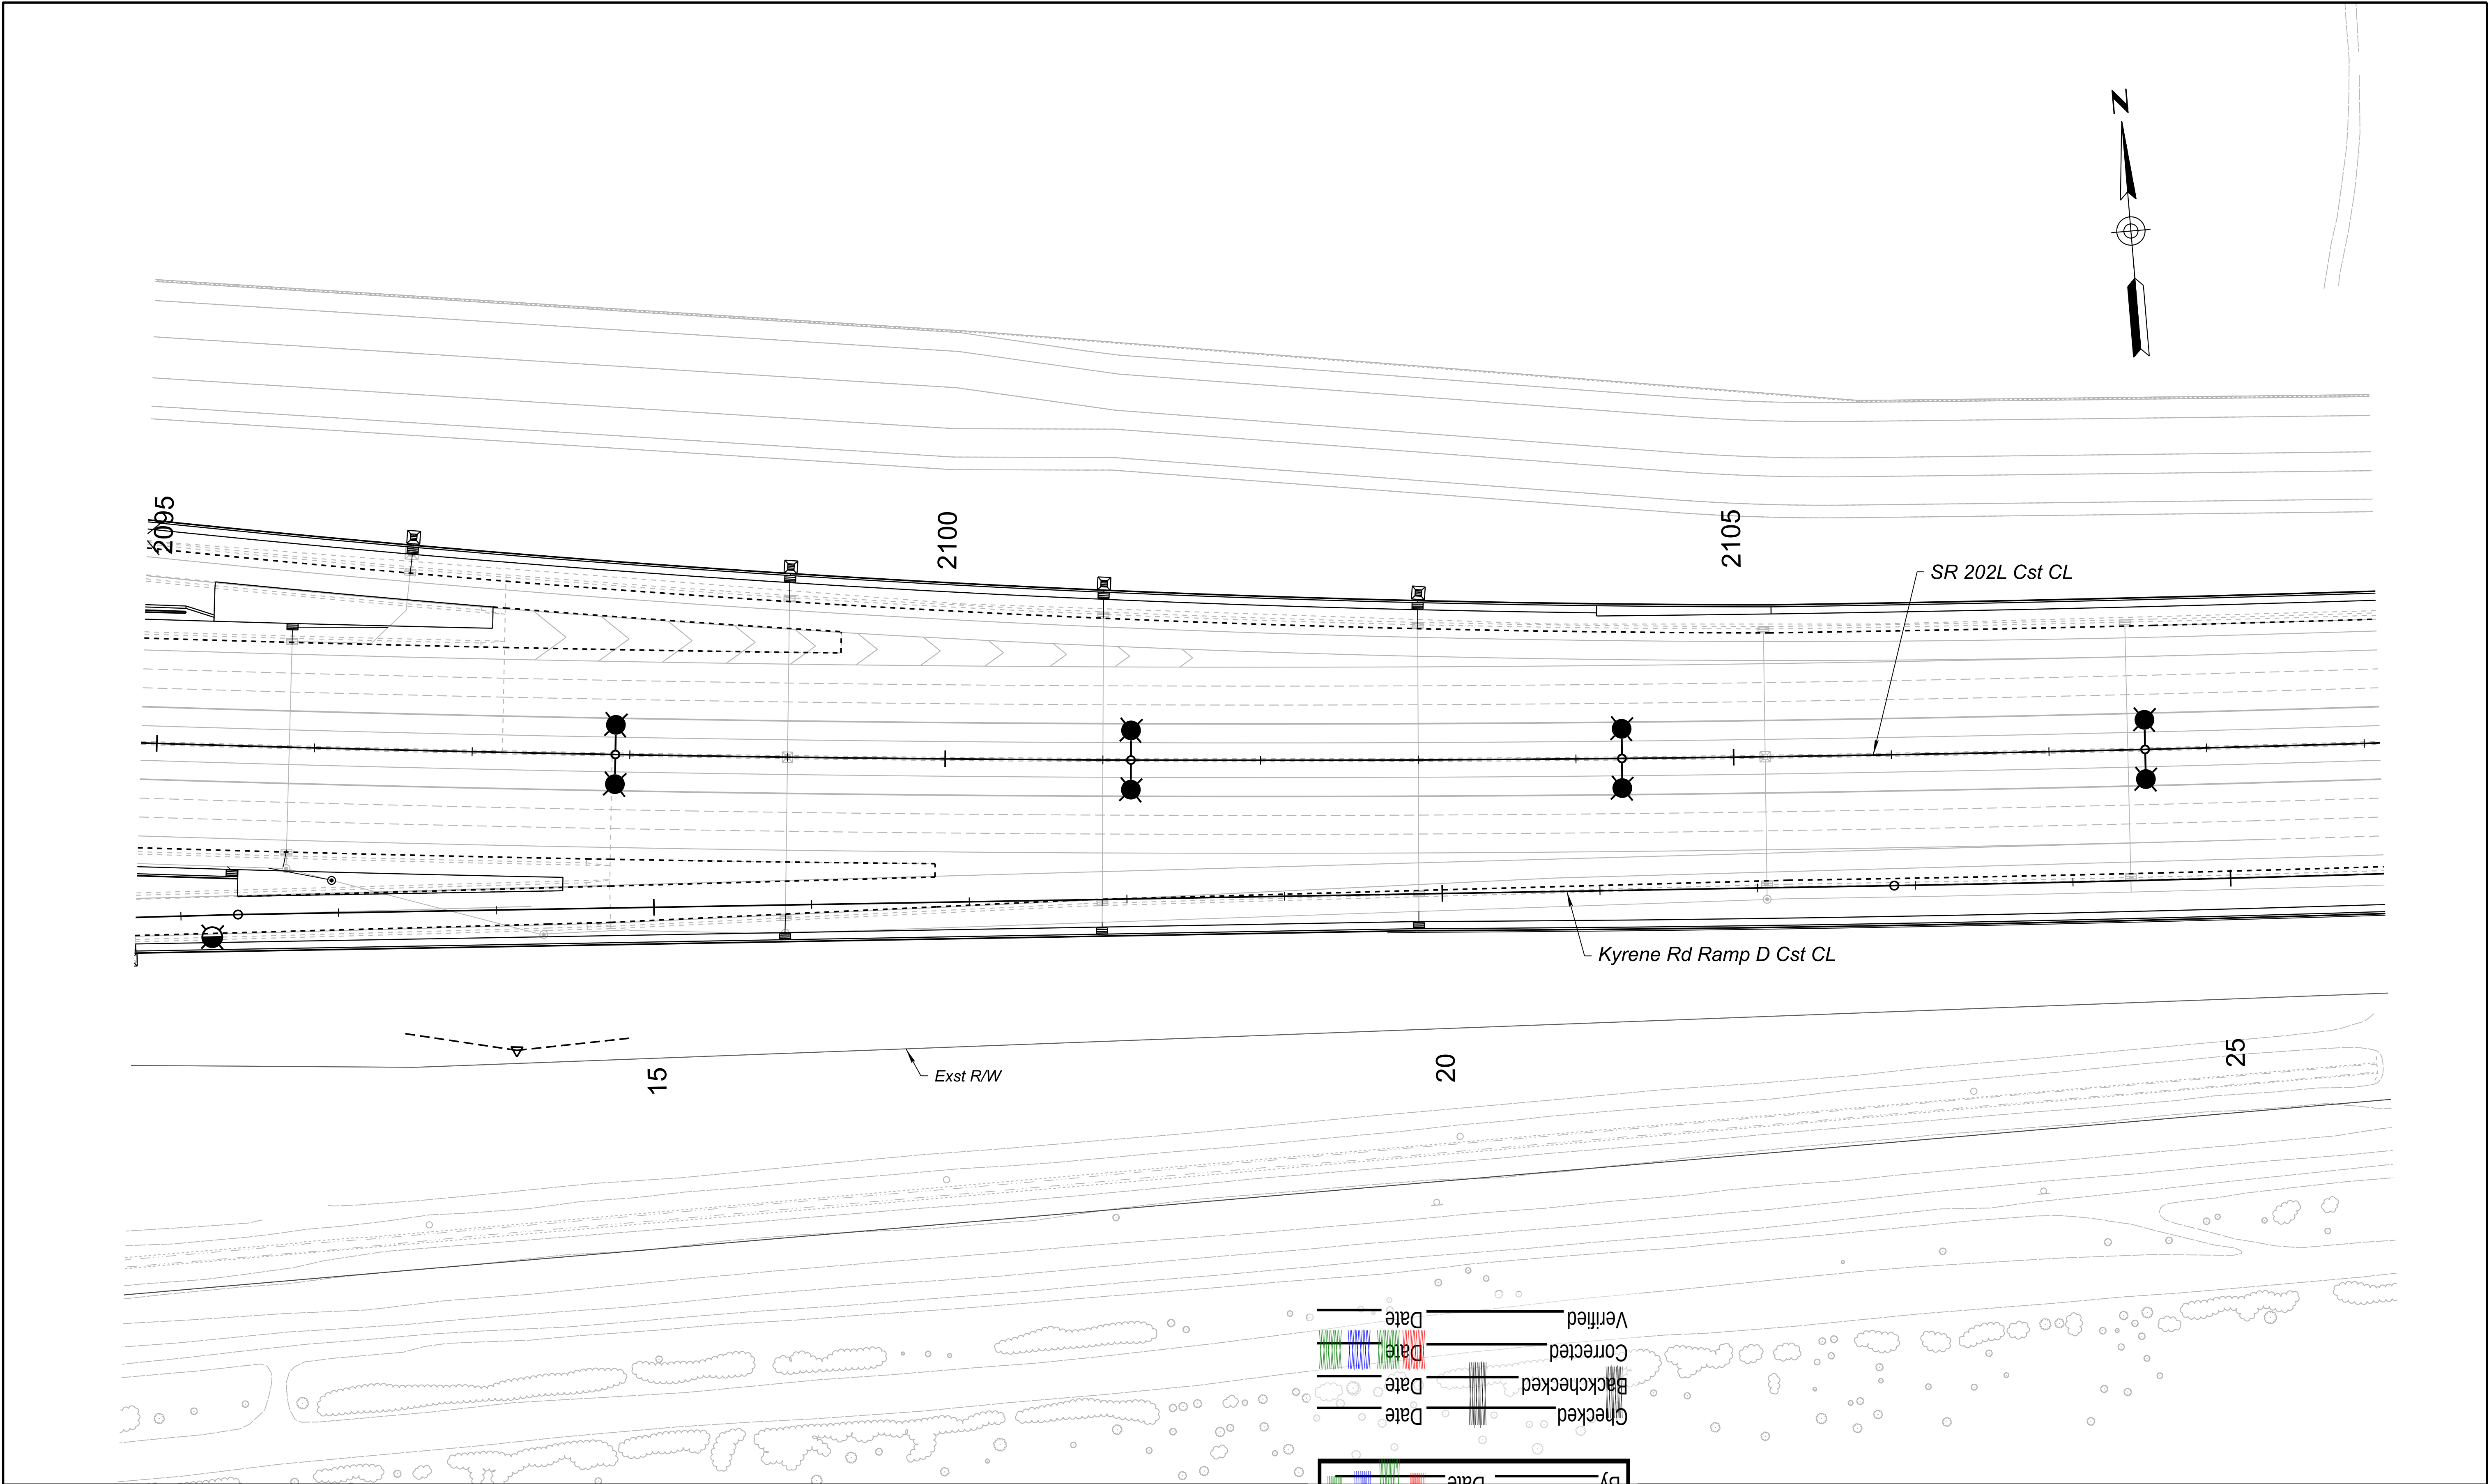

Checked	Date
Backchecked	Date
Corrected	Date
Verified	Date

PRELIMINARY STAGE III Review NOT FOR CONSTRUCTION OR RECORDING	DESIGN	NAME	DATE	By _____ Date _____ Dgn. checked against calcs and calc. check confirmed DRAINAGE DESIGN SECTION CHECK PRINT No. _____ Date _____	ROUTE	SR 202L	F.H.W.A. Arizona Division	STATE	ARIZ.	PROJECT NO.	FEDERAL ID NO.	SHEET NO.	TOTAL SHEETS	RECORD DRAWING
	DRAWN				MILEPOST		LOCATION	SR 202L SANTAN FREEWAY - I-10 TO SR 101L				DWG No.	D-02.10	
	CHECKED				STRUCTURE NO.		TRACS NO.	F0847 01D				OF		
	501 N 44th St, Suite 300 Phoenix, AZ 85008-4505 Tel (602) 454-0402 www.typpsa.us													