


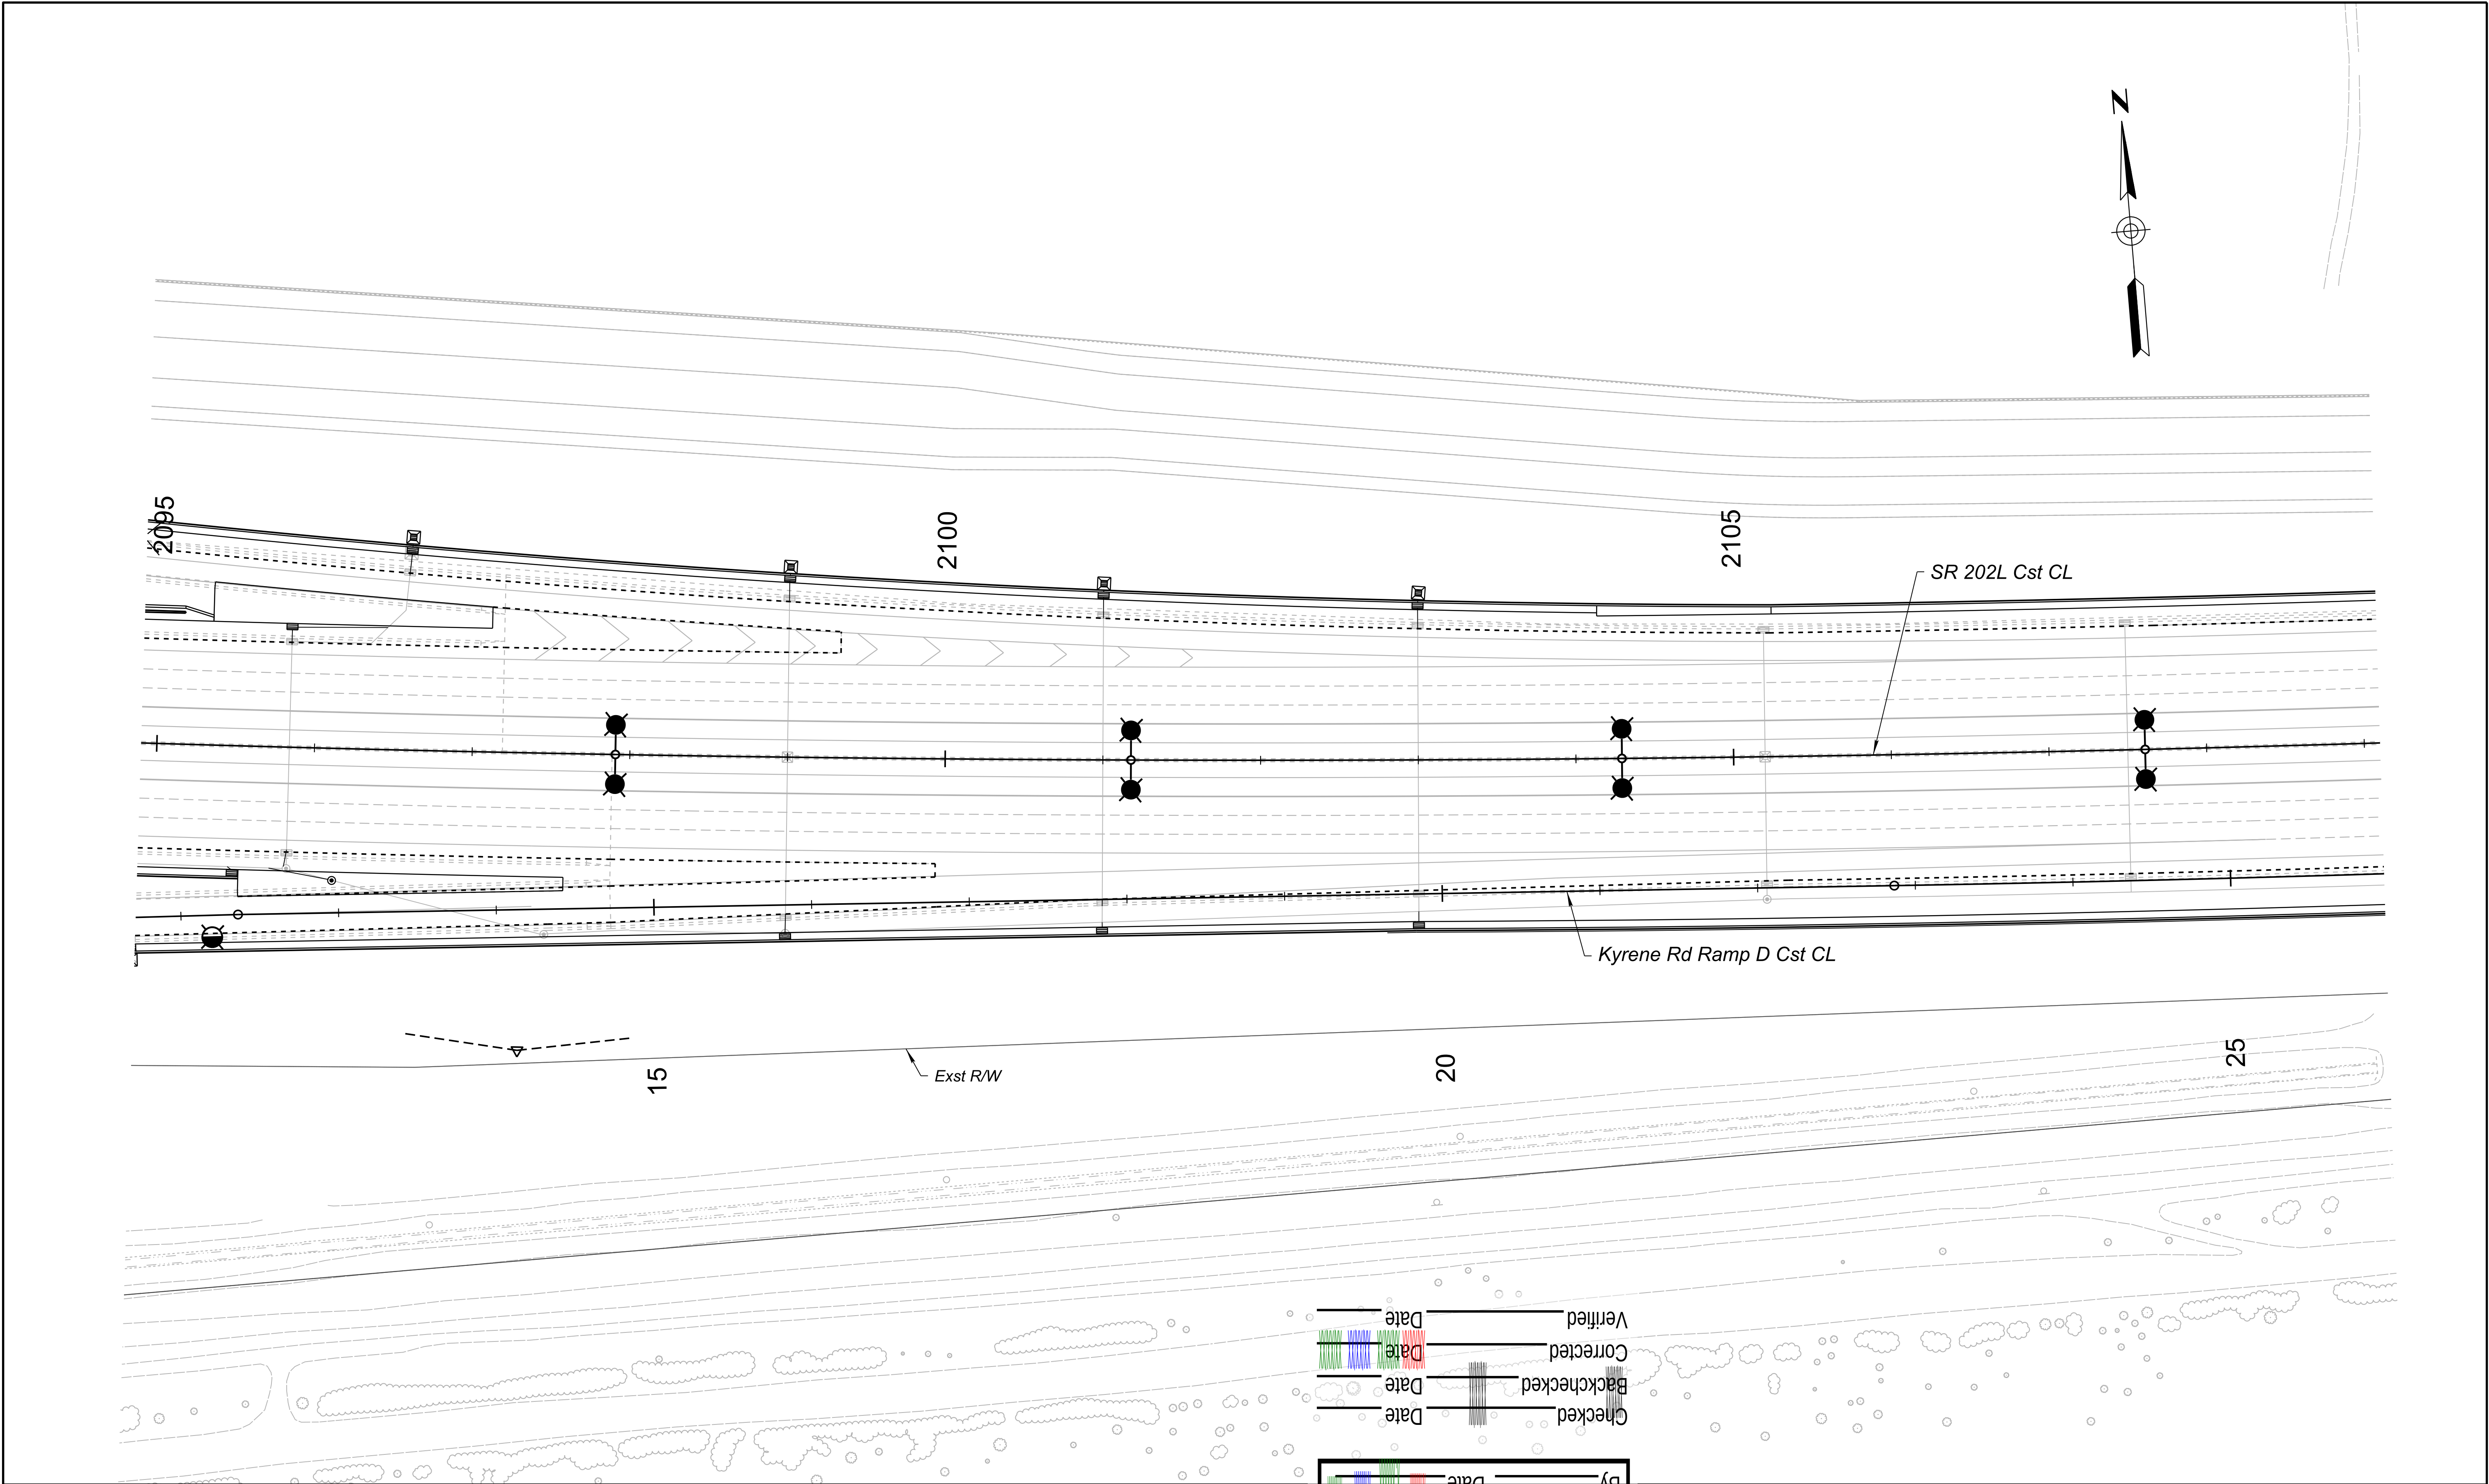

Checked	Date
Backchecked	Date
Corrected	Date
Verified	Date

PRELIMINARY STAGE III Review NOT FOR CONSTRUCTION OR RECORDING	DESIGN	NAME	DATE	ARIZONA DEPARTMENT OF TRANSPORTATION PROJECT DELIVERY AND OPERATIONS DIVISION DRAINAGE DESIGN SECTION SR 202L Dgn. checked against calcs and calc. check confirmed CHECK PRINT No. _____ Date _____	ROUTE	SR 202L	F.H.W.A. Arizona Division	STATE	ARIZ.	PROJECT NO.	FEDERAL ID NO.	SHEET NO.	TOTAL SHEETS	RECORD DRAWING
	DRAWN				MILEPOST		LOCATION	SR 202L SANTAN FREEWAY - I-10 TO SR 101L				DWG No.	D-02.10	
	CHECKED				STRUCTURE NO.		TRACS NO.	F0847 01D				OF		
	501 N 44th St, Suite 300 Phoenix, AZ 85008-4505 Tel (602) 454-0402 www.typpsa.us													