


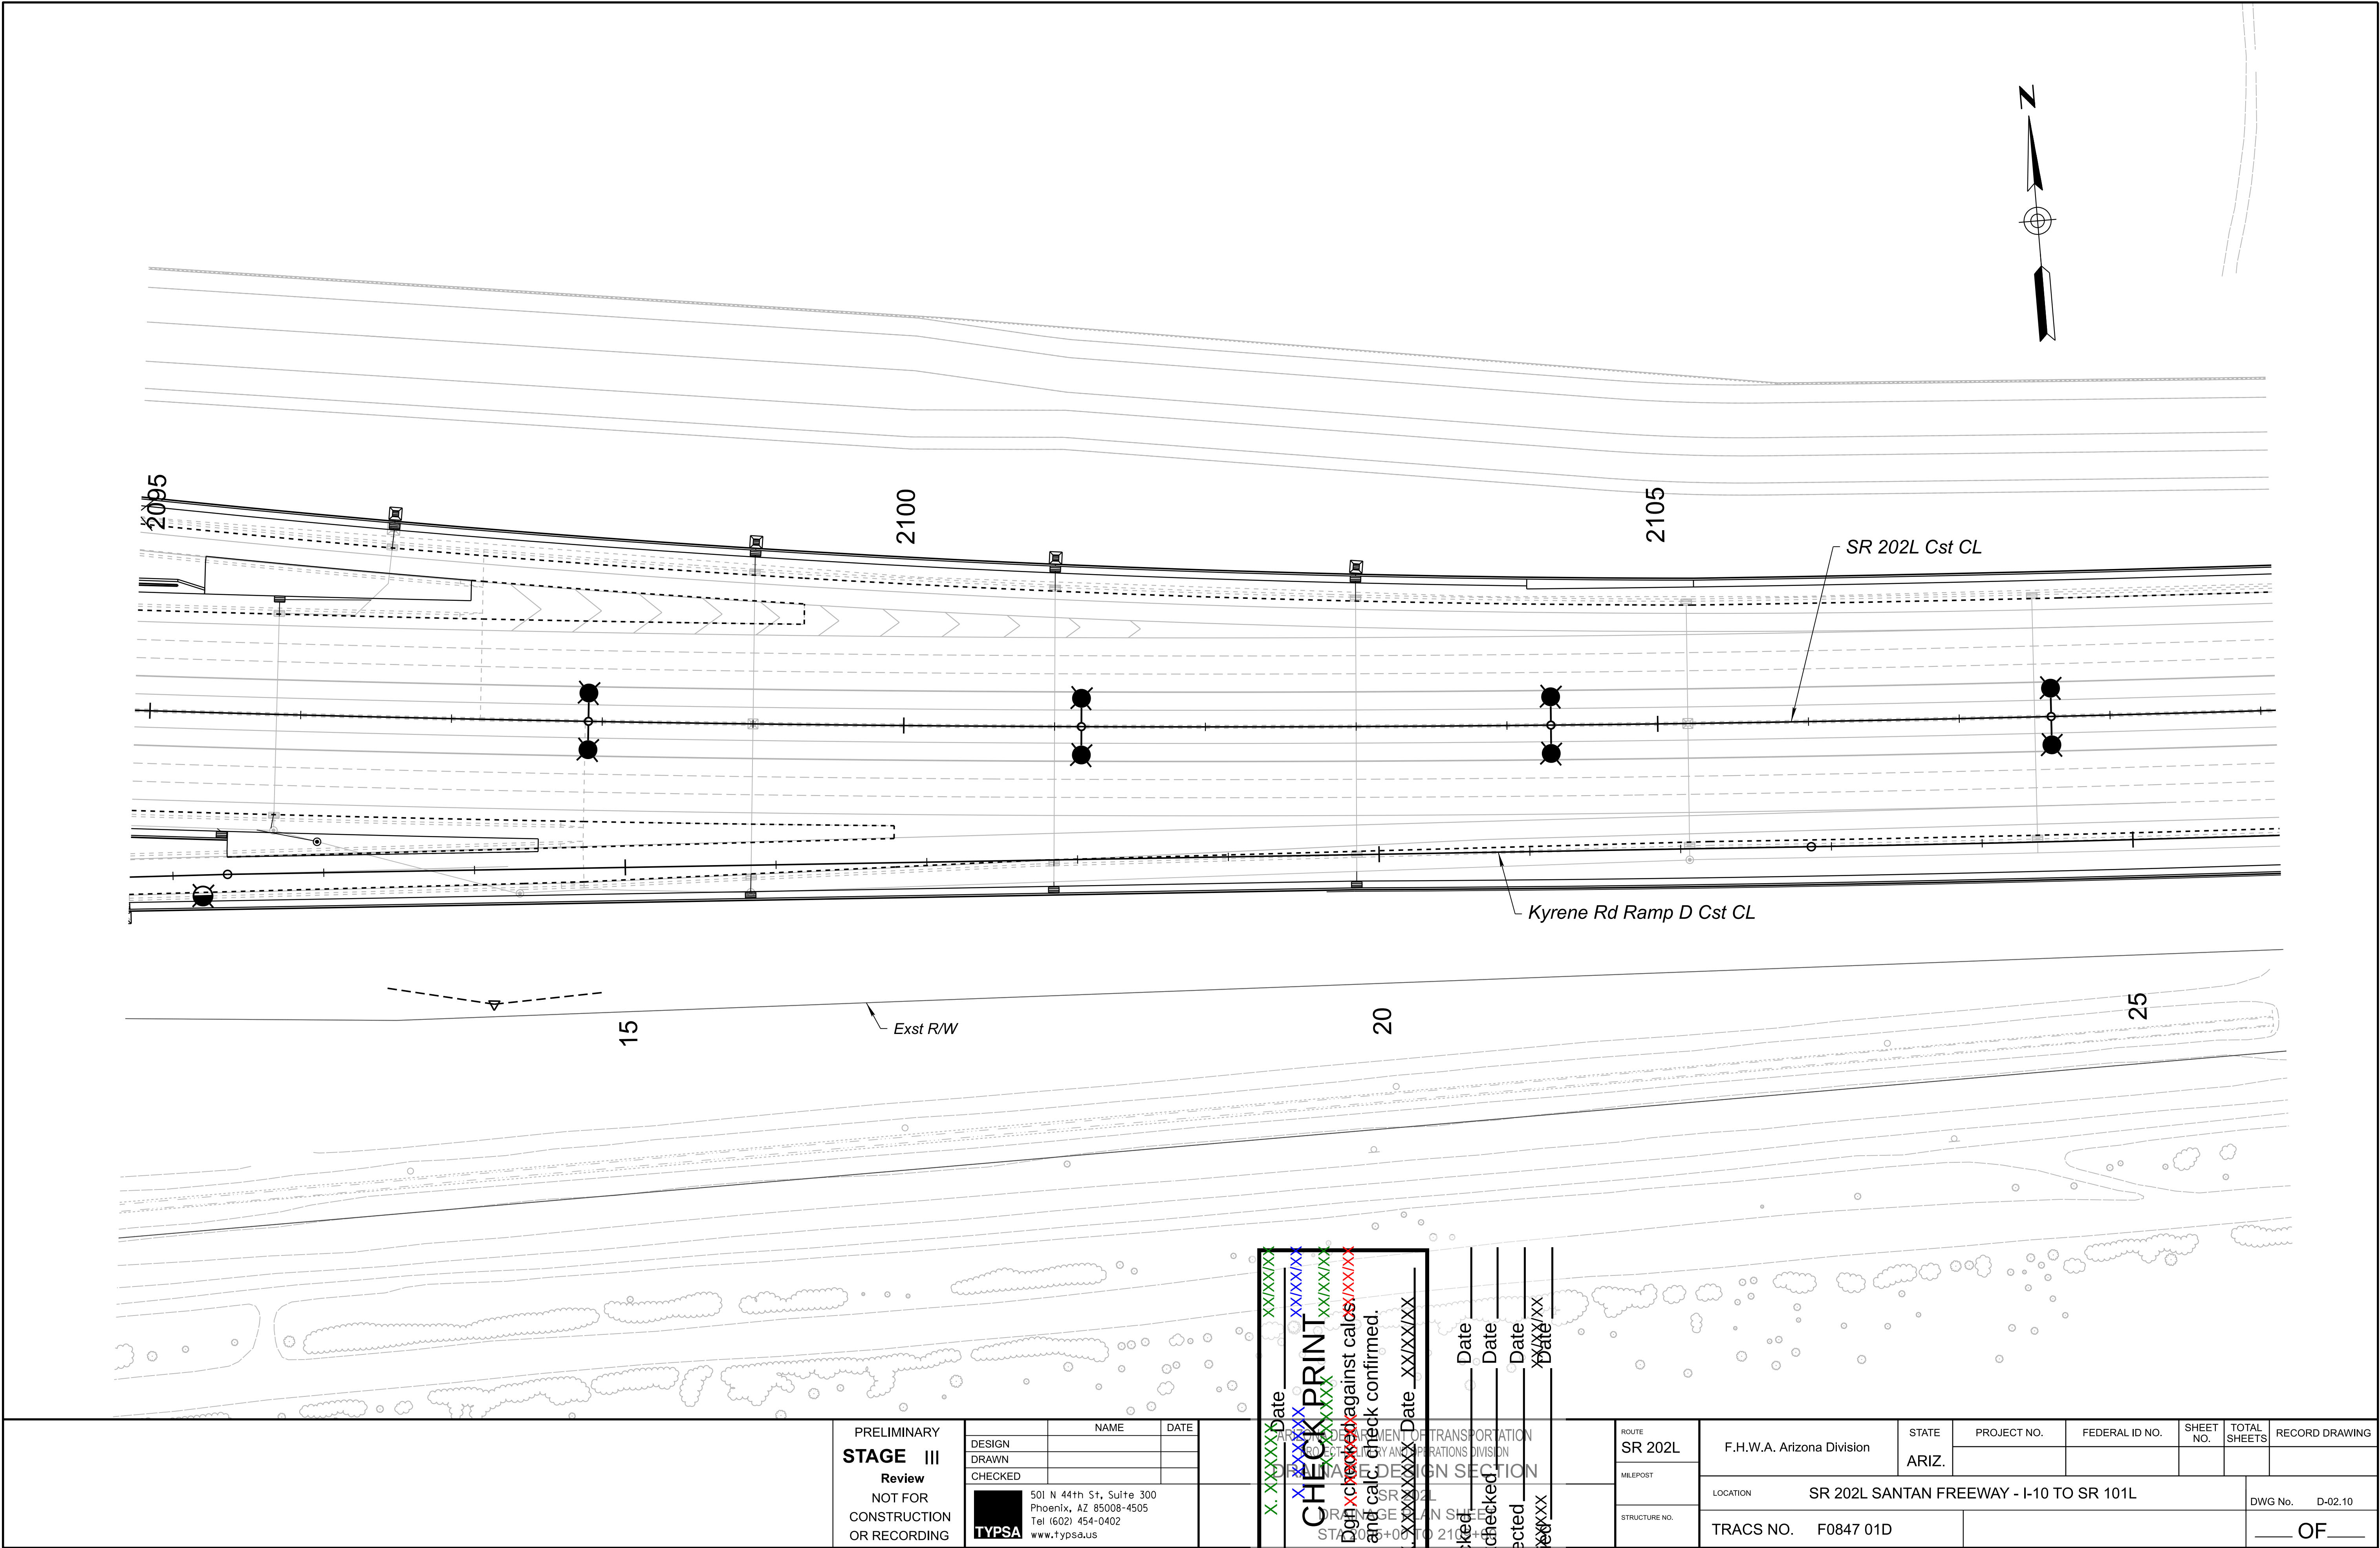

PRELIMINARY STAGE III Review NOT FOR CONSTRUCTION OR RECORDING	DESIGN	NAME	DATE	No. XXXXXX Date XXXXXX CHECK PRINT XXXXXX XXXXXX XXXXXX Do not check against calcs and calc check confirmed. By XXXXXX Date XXXXXX Checked XXXXXX Date XXXXXX Backchecked XXXXXX Date XXXXXX Corrected XXXXXX Date XXXXXX Verified XXXXXX Date XXXXXX	ROUTE	SR 202L	F.H.W.A. Arizona Division	STATE	ARIZ.	PROJECT NO.	FEDERAL ID NO.	SHEET NO.	TOTAL SHEETS	RECORD DRAWING
	DRAWN				MILEPOST		LOCATION	SR 202L SANTAN FREEWAY - I-10 TO SR 101L				DWG No. D-02.10		
	CHECKED				STRUCTURE NO.		TRACS NO.	F0847 01D				OF		
	501 N 44th St, Suite 300 Phoenix, AZ 85008-4505 Tel (602) 454-0402 www.typpsa.us													