


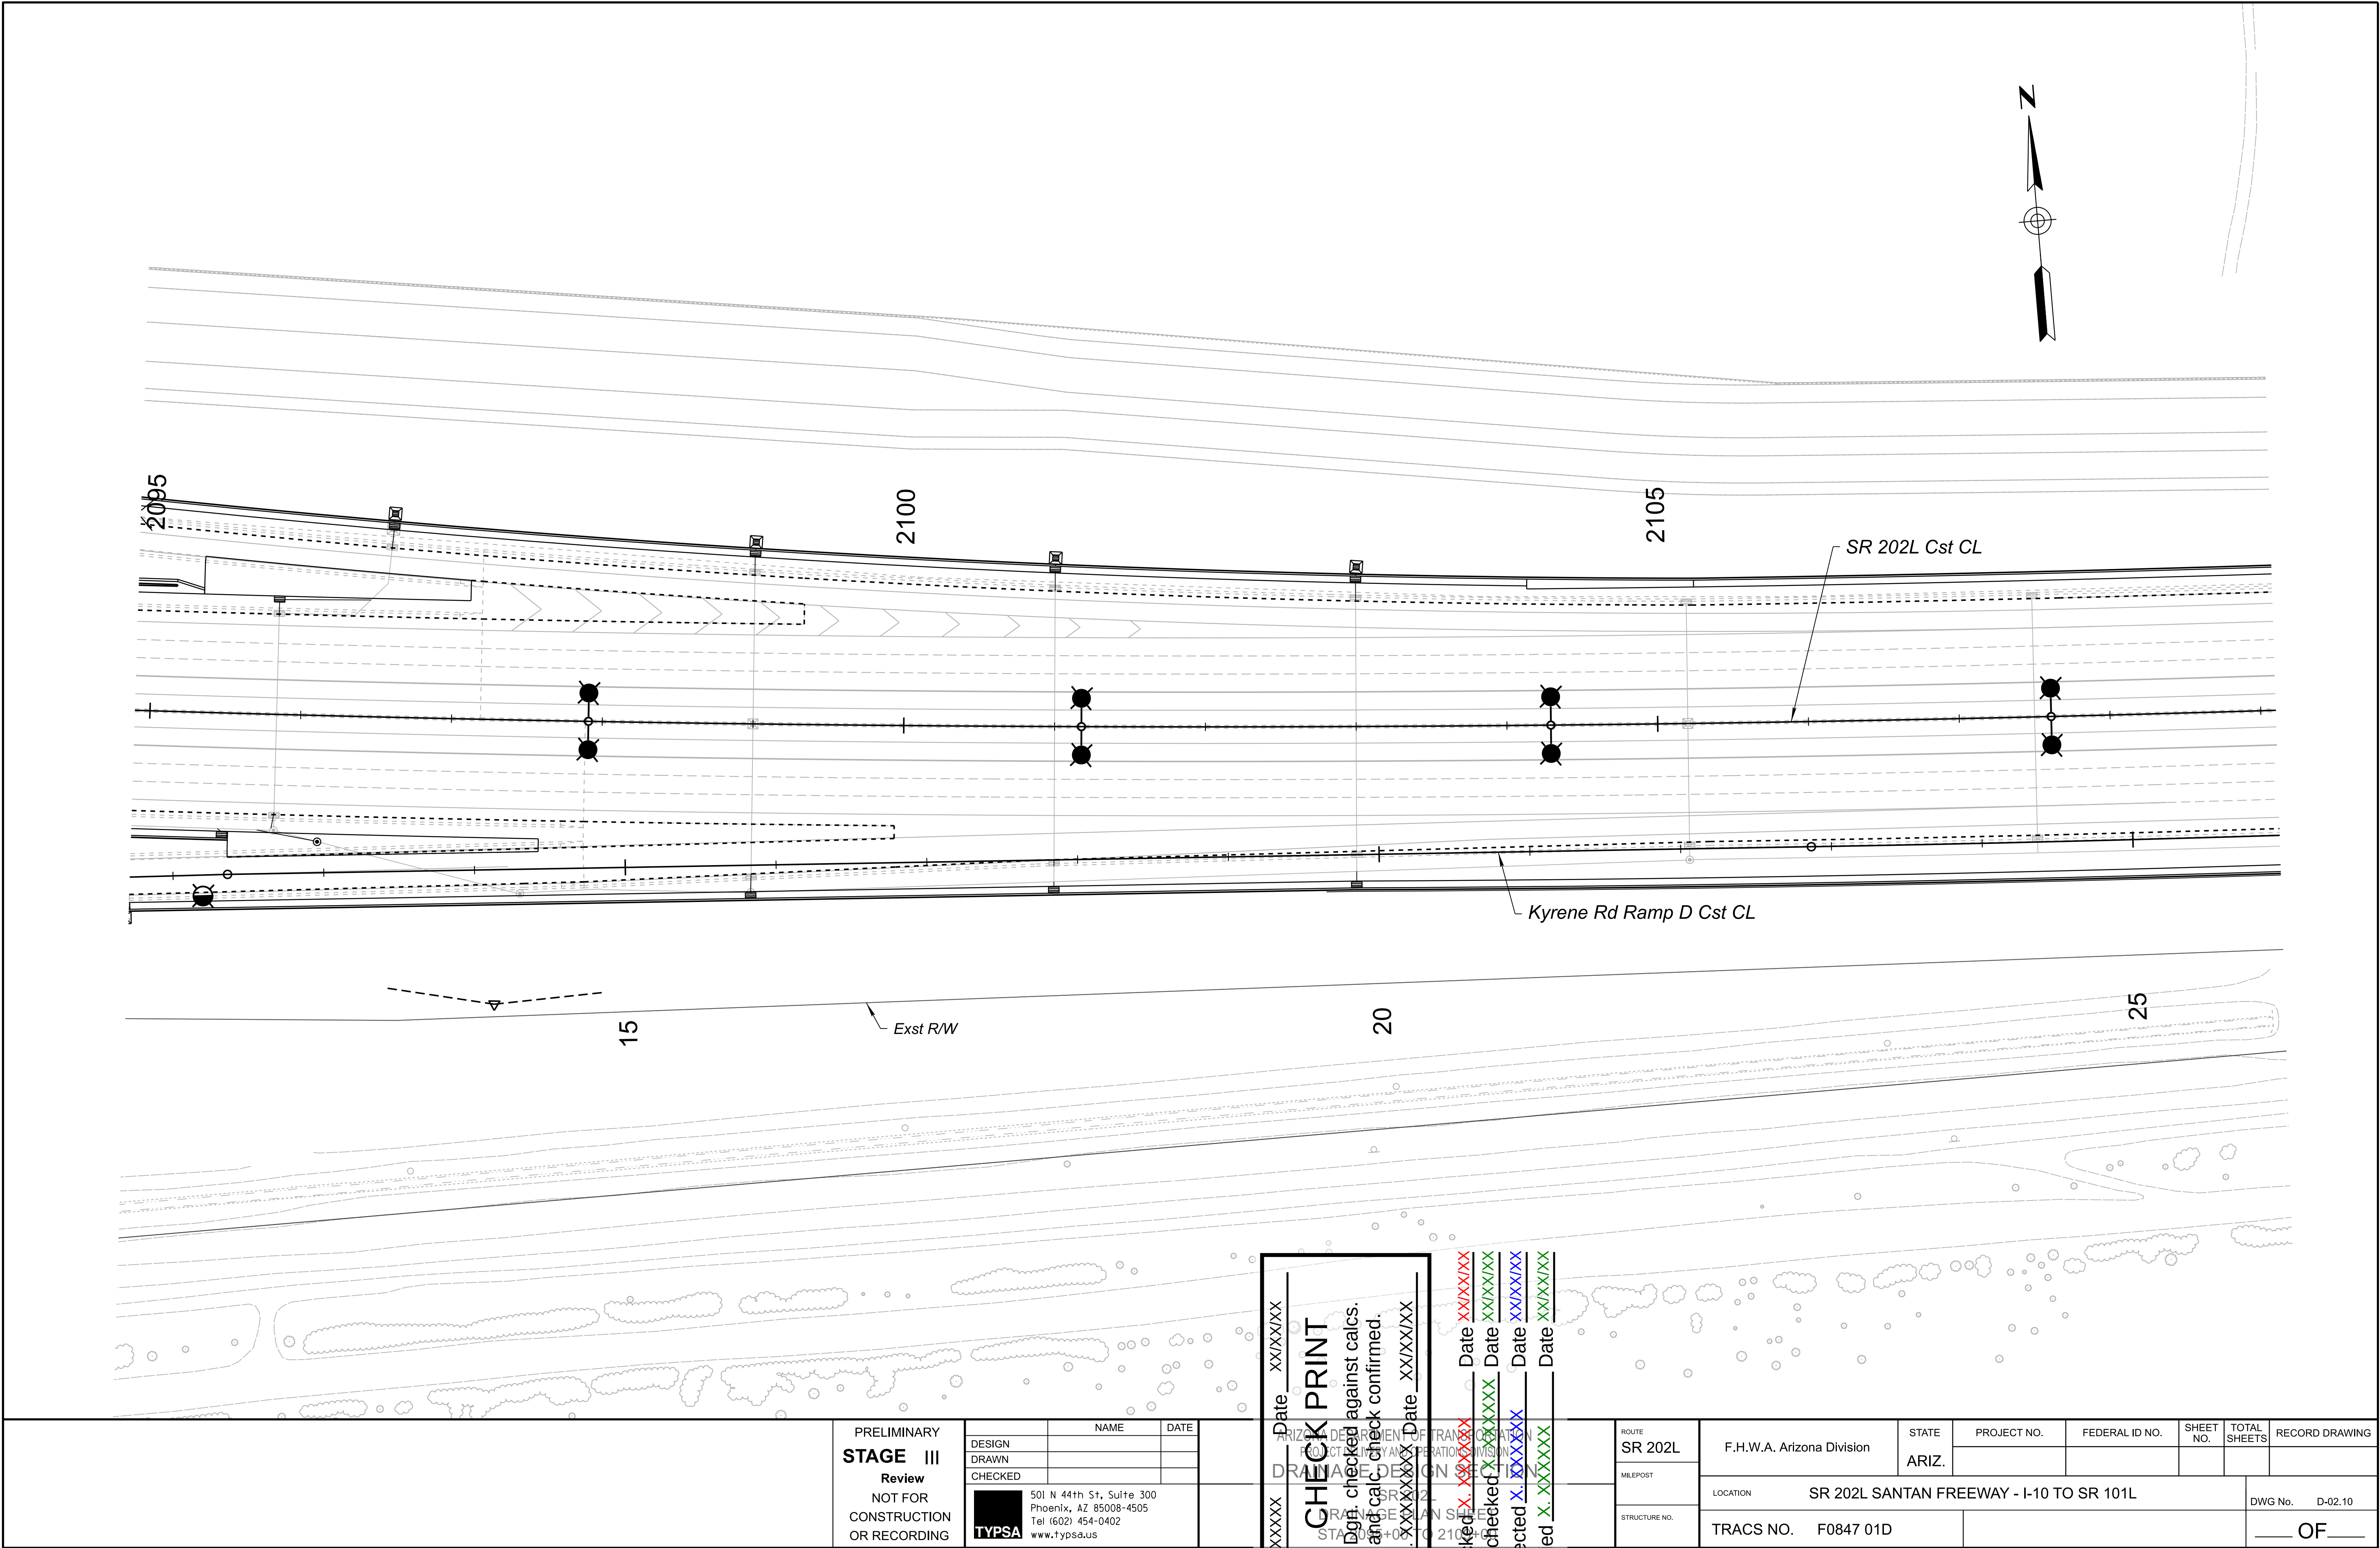

PRELIMINARY
STAGE III
Review
NOT FOR
CONSTRUCTION
OR RECORDING

DESIGN	NAME	DATE
DRAWN		
CHECKED		
	501 N 44th St, Suite 300 Phoenix, AZ 85008-4505 Tel (602) 454-0402 www.typsa.us	

No. XXXXX	Date XXXXXX
CHECK PRINT	
Dgn. checked against calcs. and calc. check confirmed.	
By: XXXXXX	Date XXXXXX
Checked X XXXXX	Date XXXXXX
Backchecked X XXXXX	Date XXXXXX
Corrected X XXXXX	Date XXXXXX
Verified X XXXXX	Date XXXXXX

ROUTE SR 202L	F.H.W.A. Arizona Division	STATE ARIZ.	PROJECT NO.	FEDERAL ID NO.	SHEET NO.	TOTAL SHEETS	RECORD DRAWING
MILEPOST	LOCATION SR 202L SANTAN FREEWAY - I-10 TO SR 101L						
STRUCTURE NO.	TRACS NO. F0847 01D						DWG No. D-02.10 ____ OF ____