


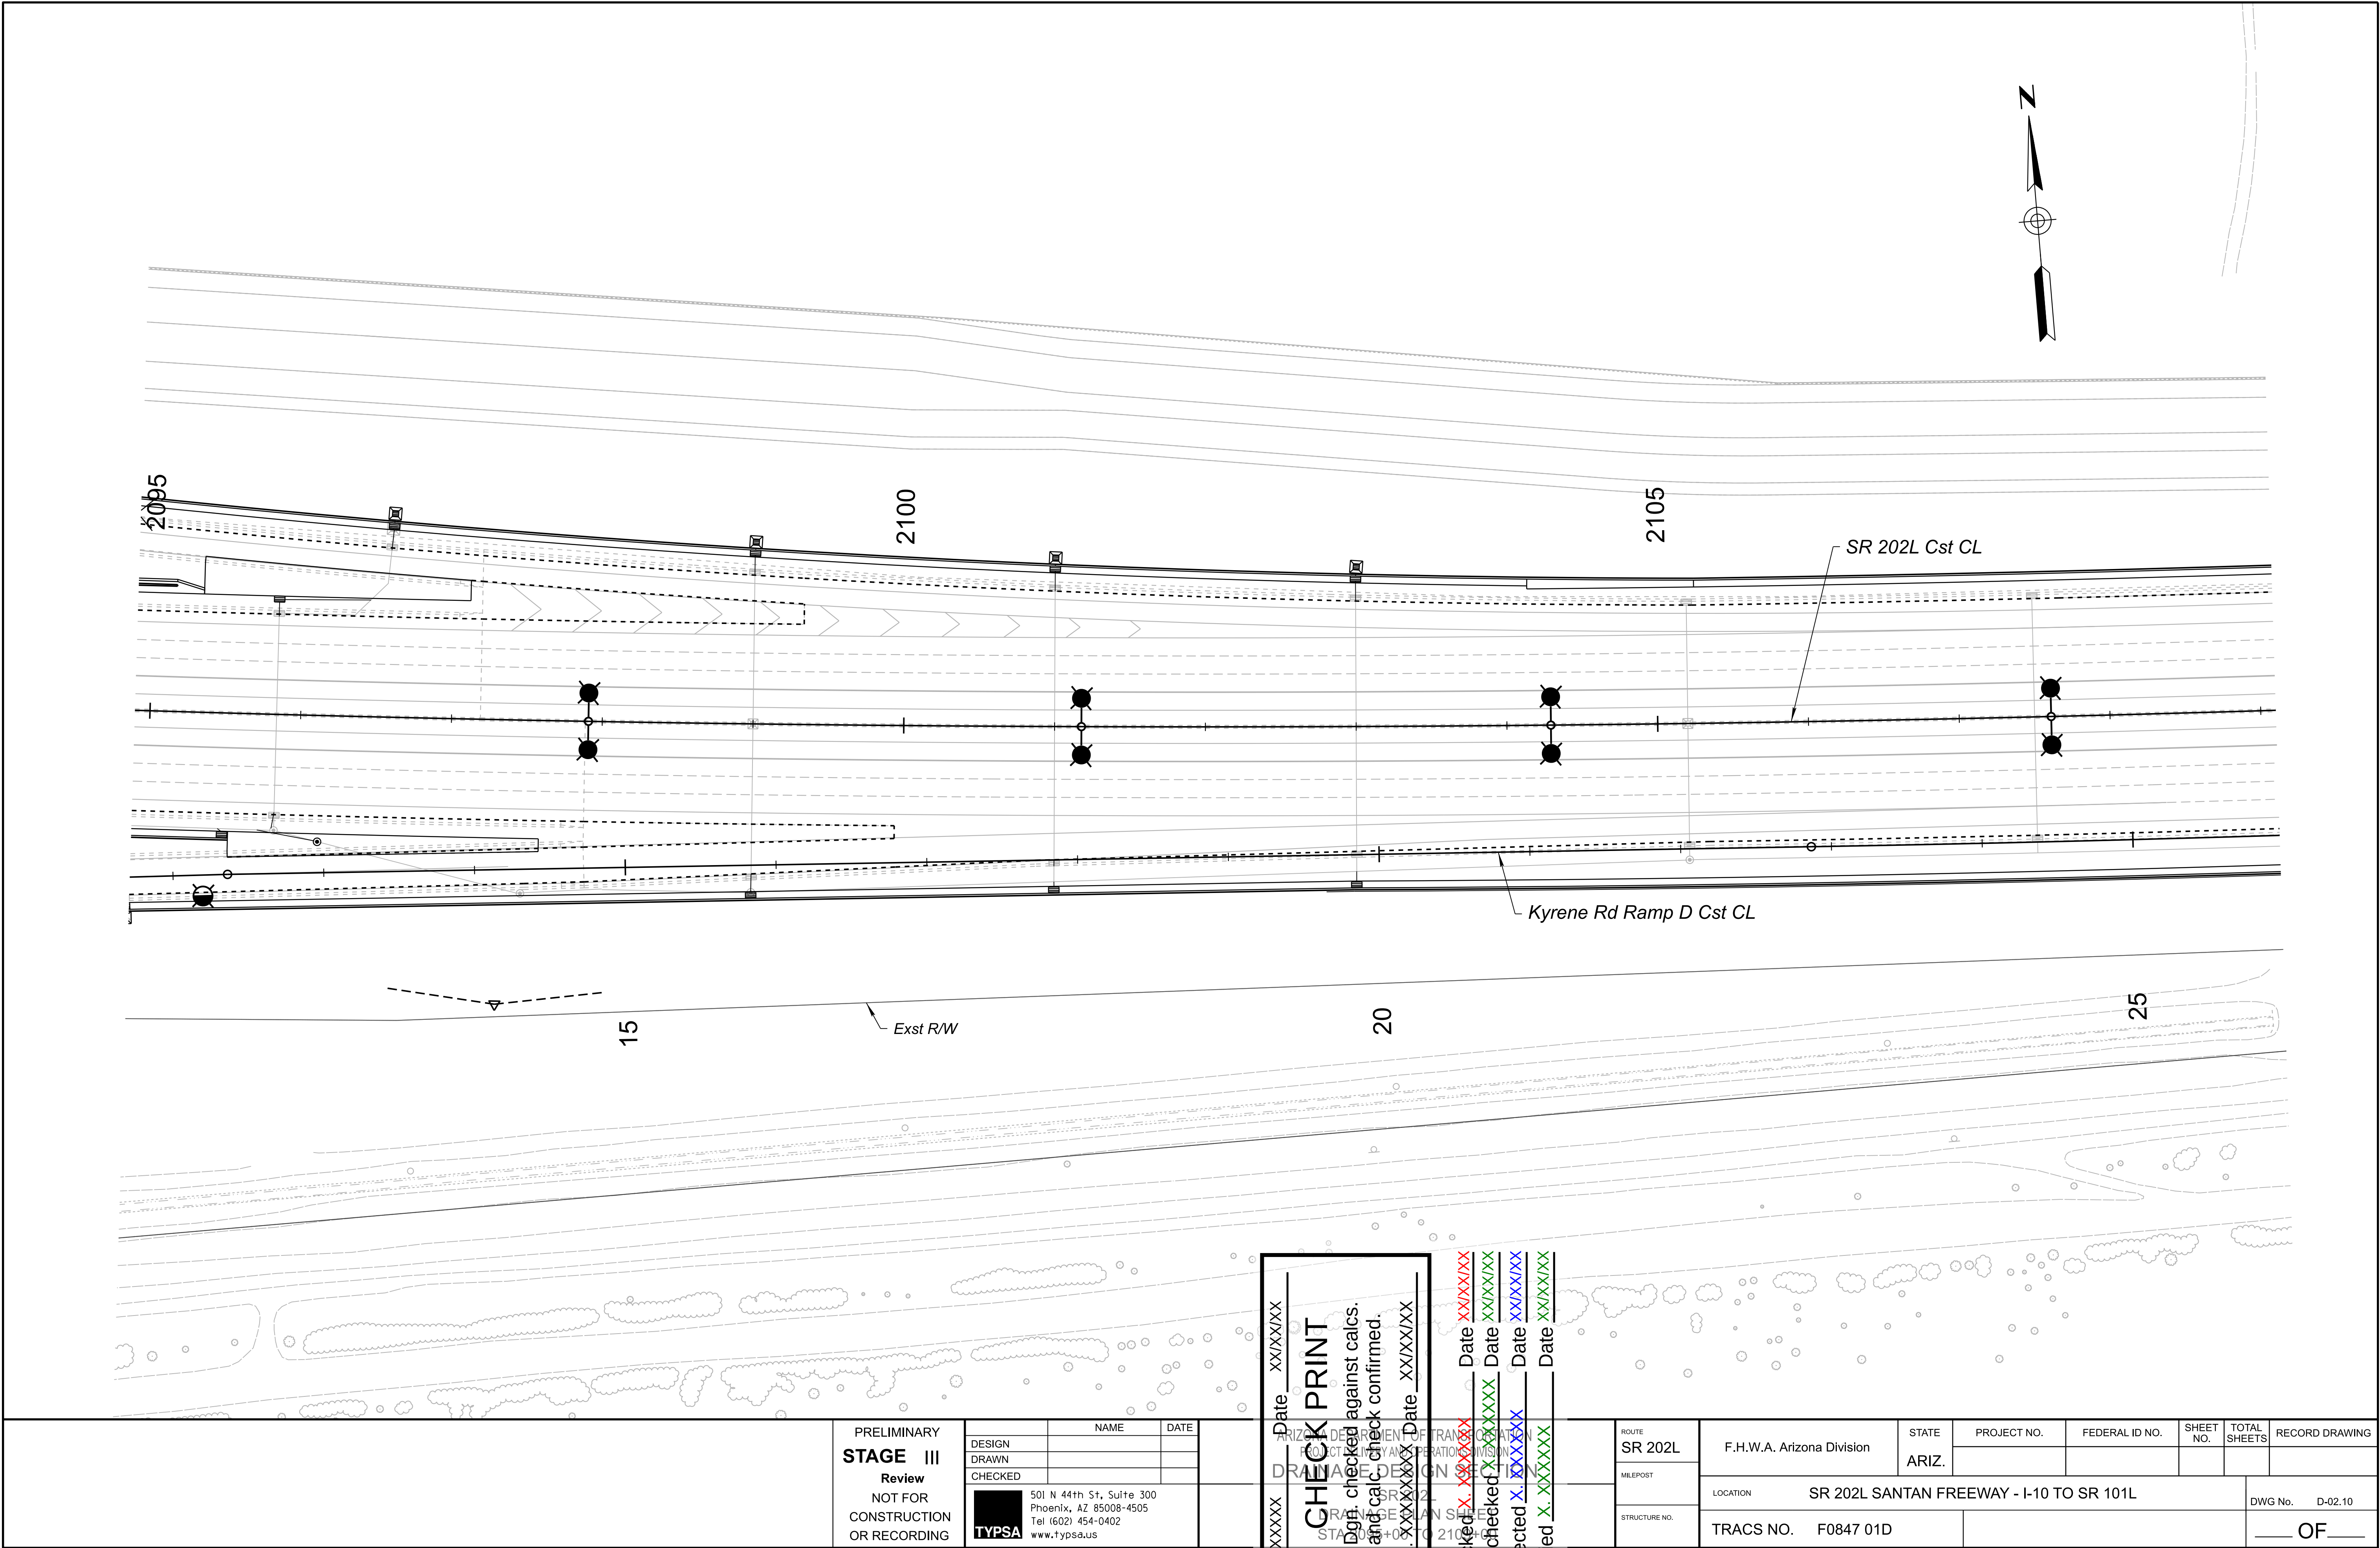

PRELIMINARY STAGE III Review NOT FOR CONSTRUCTION OR RECORDING	DESIGN	NAME	DATE	No. <u>XXXXX</u> Date <u>XXXXXX</u> CHECK PRINT Dgn. checked against calcs. and calc. check confirmed. By <u>XXXXXX</u> Date <u>XXXXXX</u> Checked <u>X</u> <u>XXXXXX</u> Date <u>XXXXXX</u> Backchecked <u>X</u> <u>XXXXXX</u> Date <u>XXXXXX</u> Corrected <u>X</u> <u>XXXXXX</u> Date <u>XXXXXX</u> Verified <u>X</u> <u>XXXXXX</u> Date <u>XXXXXX</u>	ROUTE SR 202L	F.H.W.A. Arizona Division	STATE ARIZ.	PROJECT NO.	FEDERAL ID NO.	SHEET NO.	TOTAL SHEETS	RECORD DRAWING
	DRAWN				MILEPOST	LOCATION SR 202L SANTAN FREEWAY - I-10 TO SR 101L					DWG No. D-02.10	
	CHECKED				STRUCTURE NO.	TRACS NO. F0847 01D					OF	

501 N 44th St, Suite 300
Phoenix, AZ 85008-4505
Tel (602) 454-0402
www.typpsa.us

TYPPSA