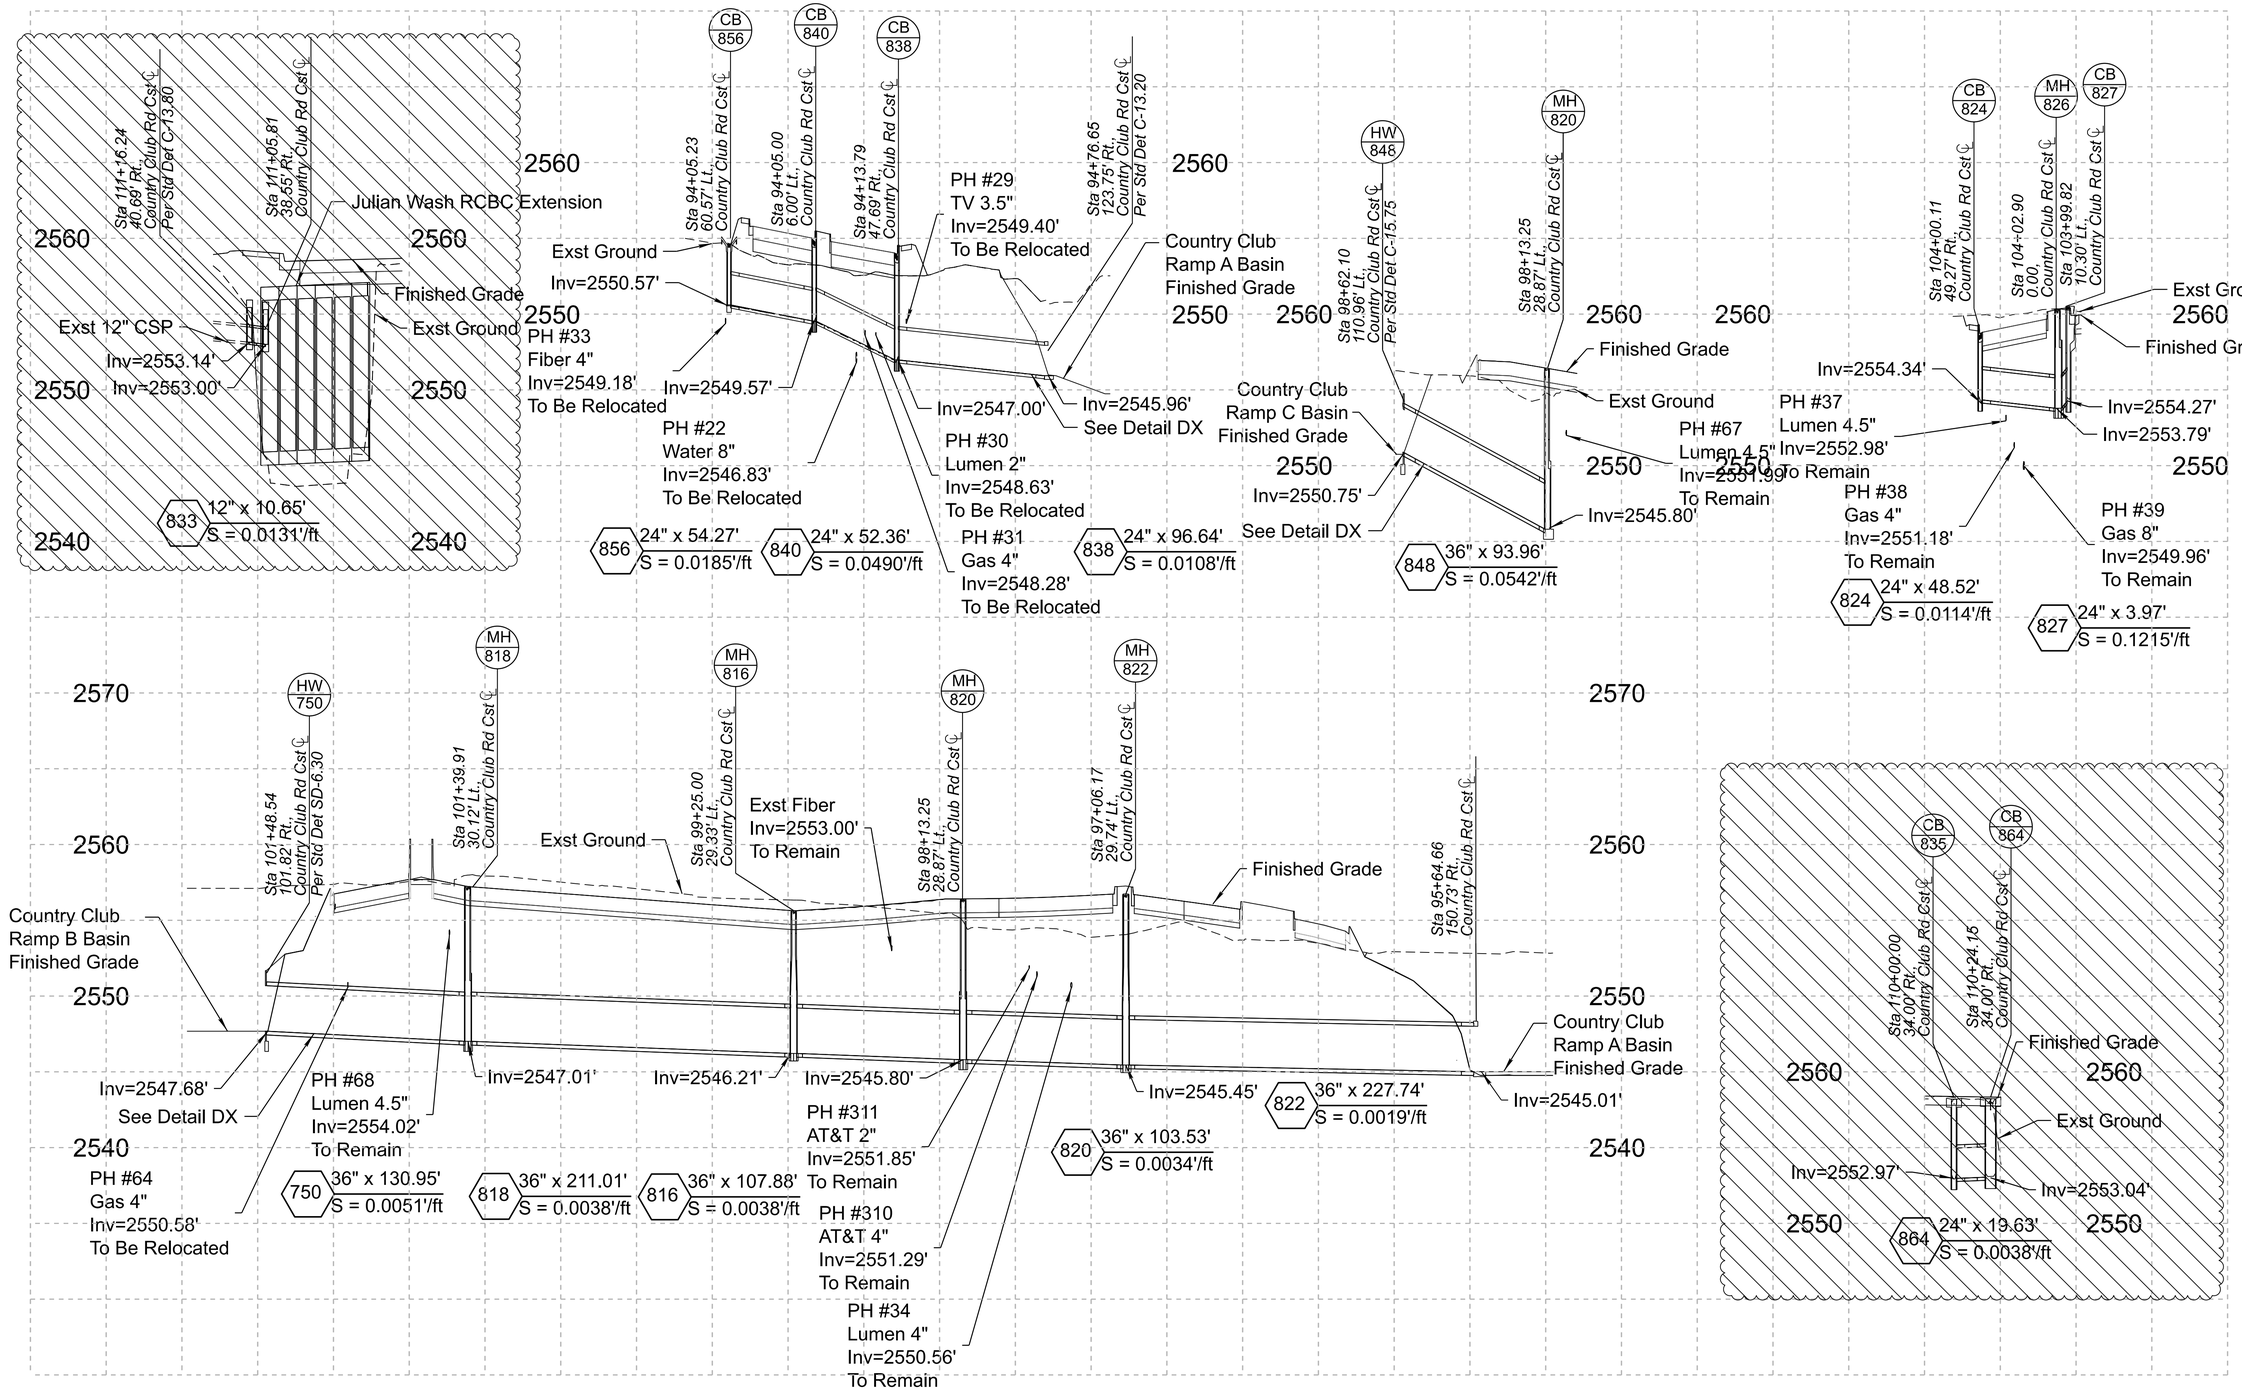

NO.	DESCRIPTION OF REVISIONS	BY	DATE
0	RFC RELEASE	TM	08/18/25

	NAME	DATE
DESIGN	J. FLINT	9/25
DRAWN	L. BREINING	9/25
CHECKED	T. MAHON	9/25

AZTEC TYPSA

Registered Professional Engineer (Civil) CERTIFICATE NO. 65939 TIMOTHY MAHON Date Signed ARIZONA, U.S.A.

ARIZONA DEPARTMENT OF TRANSPORTATION
INFRASTRUCTURE DELIVERY AND OPERATIONS DIVISION
ROADWAY DESIGN SECTION

DRAINAGE PROFILE SHEET

ROUTE I-10
MILEPOST
STRUCTURE NO.

F.H.W.A. Arizona Division

STATE	PROJECT NO.	FEDERAL ID NO.	SHEET NO.	TOTAL SHEETS	RECORD DRAWING
ARIZ.	010 PM 262	010-E(232)S			

LOCATION I-10 COUNTRY CLUB RD AND KINO PKWY TIS

DWG NO. D-02.22

TRACS NO. F0548 01C

ADOT

____ OF ____

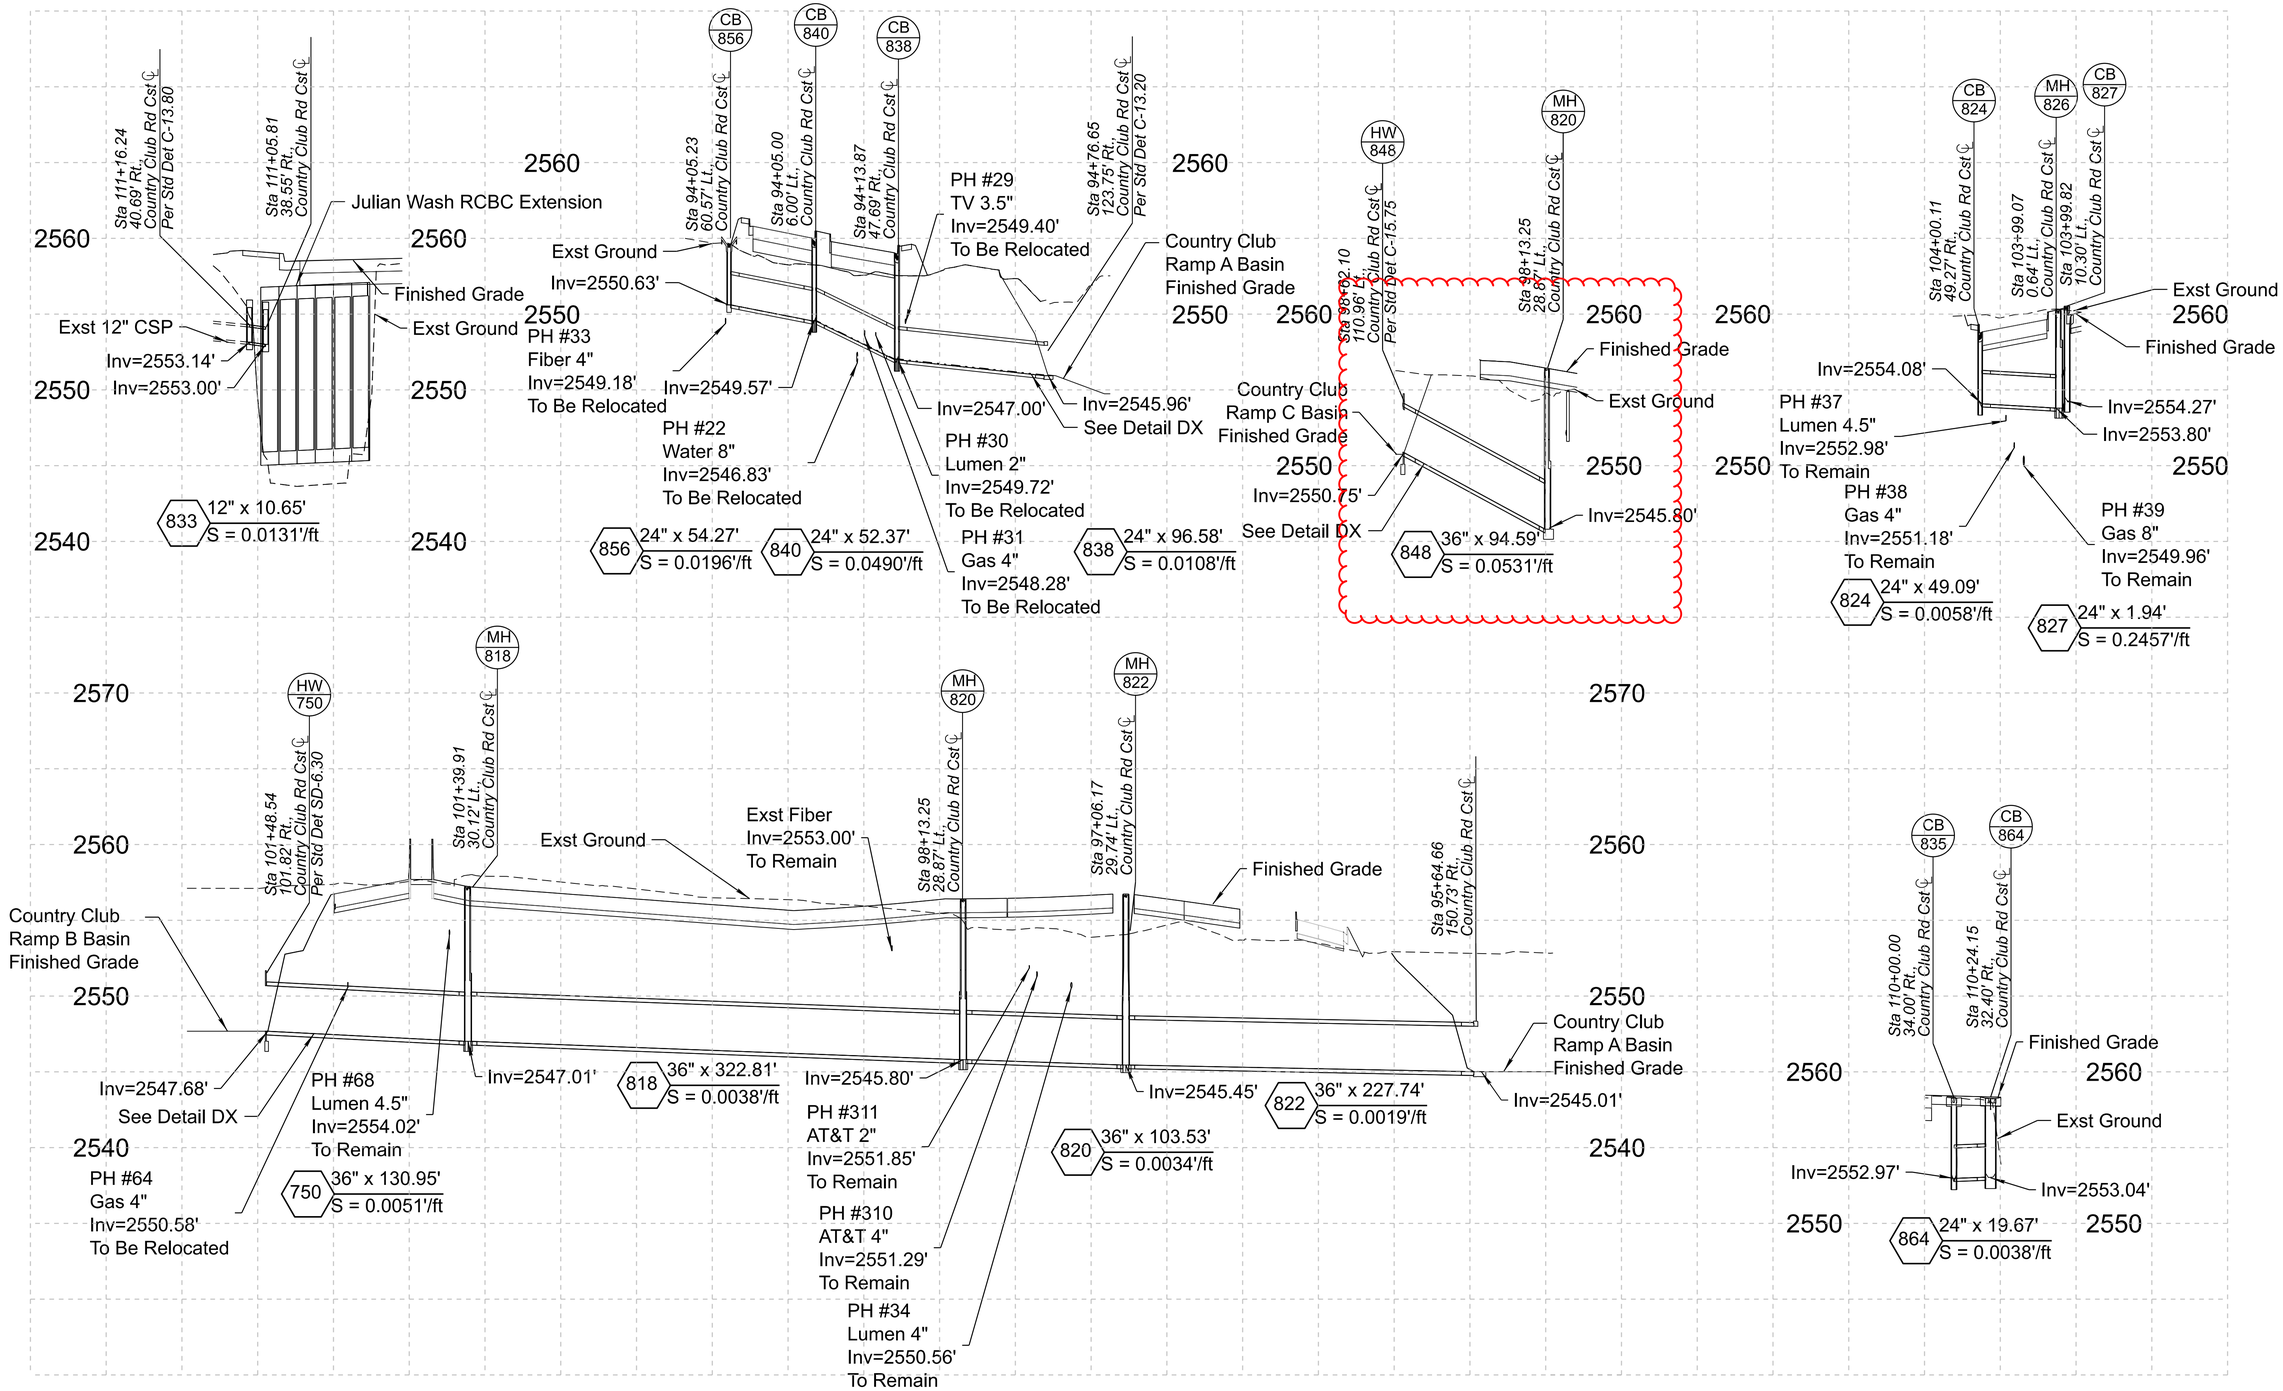

NO.	DESCRIPTION OF REVISIONS	MADE BY	DATE
R00	RFC RELEASE	TM	08/18/25

DATE - LOCATION - REVISIONS - FINISHED PLANS - SURVEY NO.

Registered Professional Engineer (Civil) CERTIFICATE NO. 65939 TIMOTHY MAHON Date Signed ARIZONA, U.S.A.

	NAME	DATE
DESIGN	J. FLINT	8/25
DRAWN	L. BREINING	8/25
CHECKED	T. MAHON	8/25

SUNDT AZTEC TYPSA

ARIZONA DEPARTMENT OF TRANSPORTATION
INFRASTRUCTURE DELIVERY AND OPERATIONS DIVISION
ROADWAY DESIGN SECTION

DRAINAGE PROFILE SHEET

ROUTE I-10
MILEPOST
STRUCTURE NO.

F.H.W.A. Arizona Division	STATE	PROJECT NO.	FEDERAL ID NO.	SHEET NO.	TOTAL SHEETS	RECORD DRAWING
	ARIZ.	010 PM 262	010-E(232)S			

LOCATION I-10 COUNTRY CLUB RD AND KINO PKWY TIS

DWG NO. D-02.22

TRACS NO. F0548 01C

ADOT

____ OF ____

8/6/2025 10:44:07 AM pw://jacobs-us-va-pw.bentley.com:jacobs-us-va-pw-04/Documents/W7Y58401 - I-10 - Kino Parkway Design Build/30 Project Data/PID/Drainage_Aztec/Sheets/f0548dv206