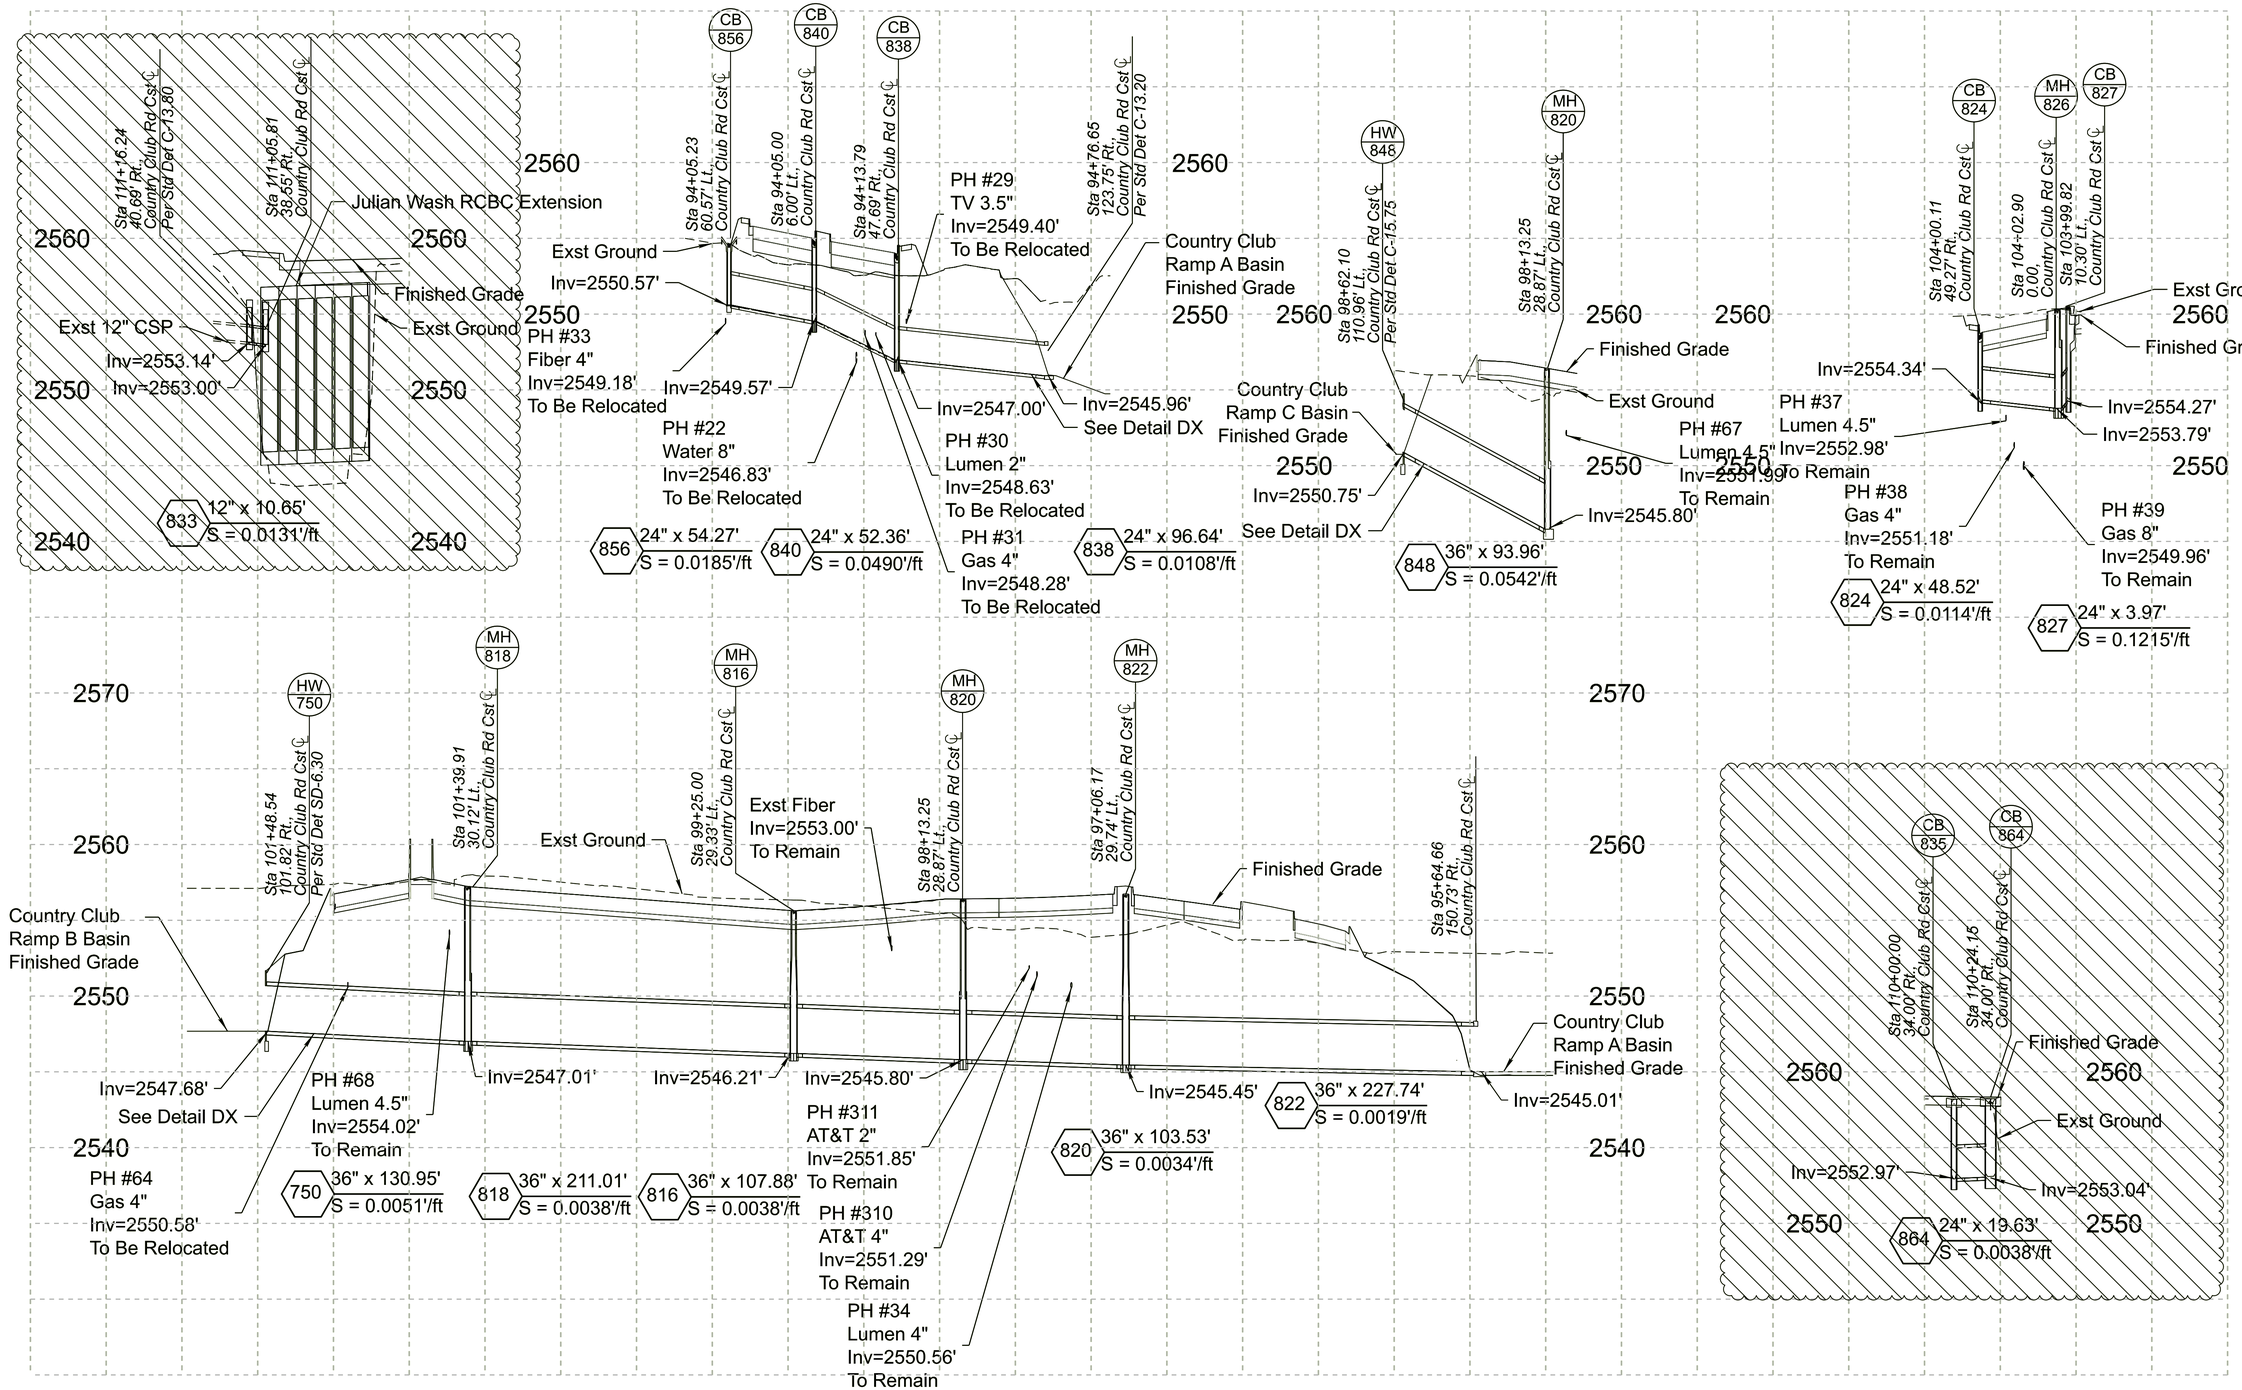

NO.	DESCRIPTION OF REVISIONS	BY	DATE
0	RFC RELEASE	TM	08/18/25

Registered Professional Engineer (Civil) CERTIFICATE NO. 65939 TIMOTHY MAHON Date Signed ARIZONA, U.S.A.

	NAME	DATE
DESIGN	J. FLINT	9/25
DRAWN	L. BREINING	9/25
CHECKED	T. MAHON	9/25

AZTEC TYPSA

ARIZONA DEPARTMENT OF TRANSPORTATION
INFRASTRUCTURE DELIVERY AND OPERATIONS DIVISION
ROADWAY DESIGN SECTION

DRAINAGE PROFILE SHEET

ROUTE I-10
MILEPOST
STRUCTURE NO.

F.H.W.A. Arizona Division

STATE	PROJECT NO.	FEDERAL ID NO.	SHEET NO.	TOTAL SHEETS	RECORD DRAWING
ARIZ.	010 PM 262	010-E(232)S			

LOCATION I-10 COUNTRY CLUB RD AND KINO PKWY TIS

TRACS NO. F0548 01C

ADOT

DWG NO. D-02.22

____ OF____

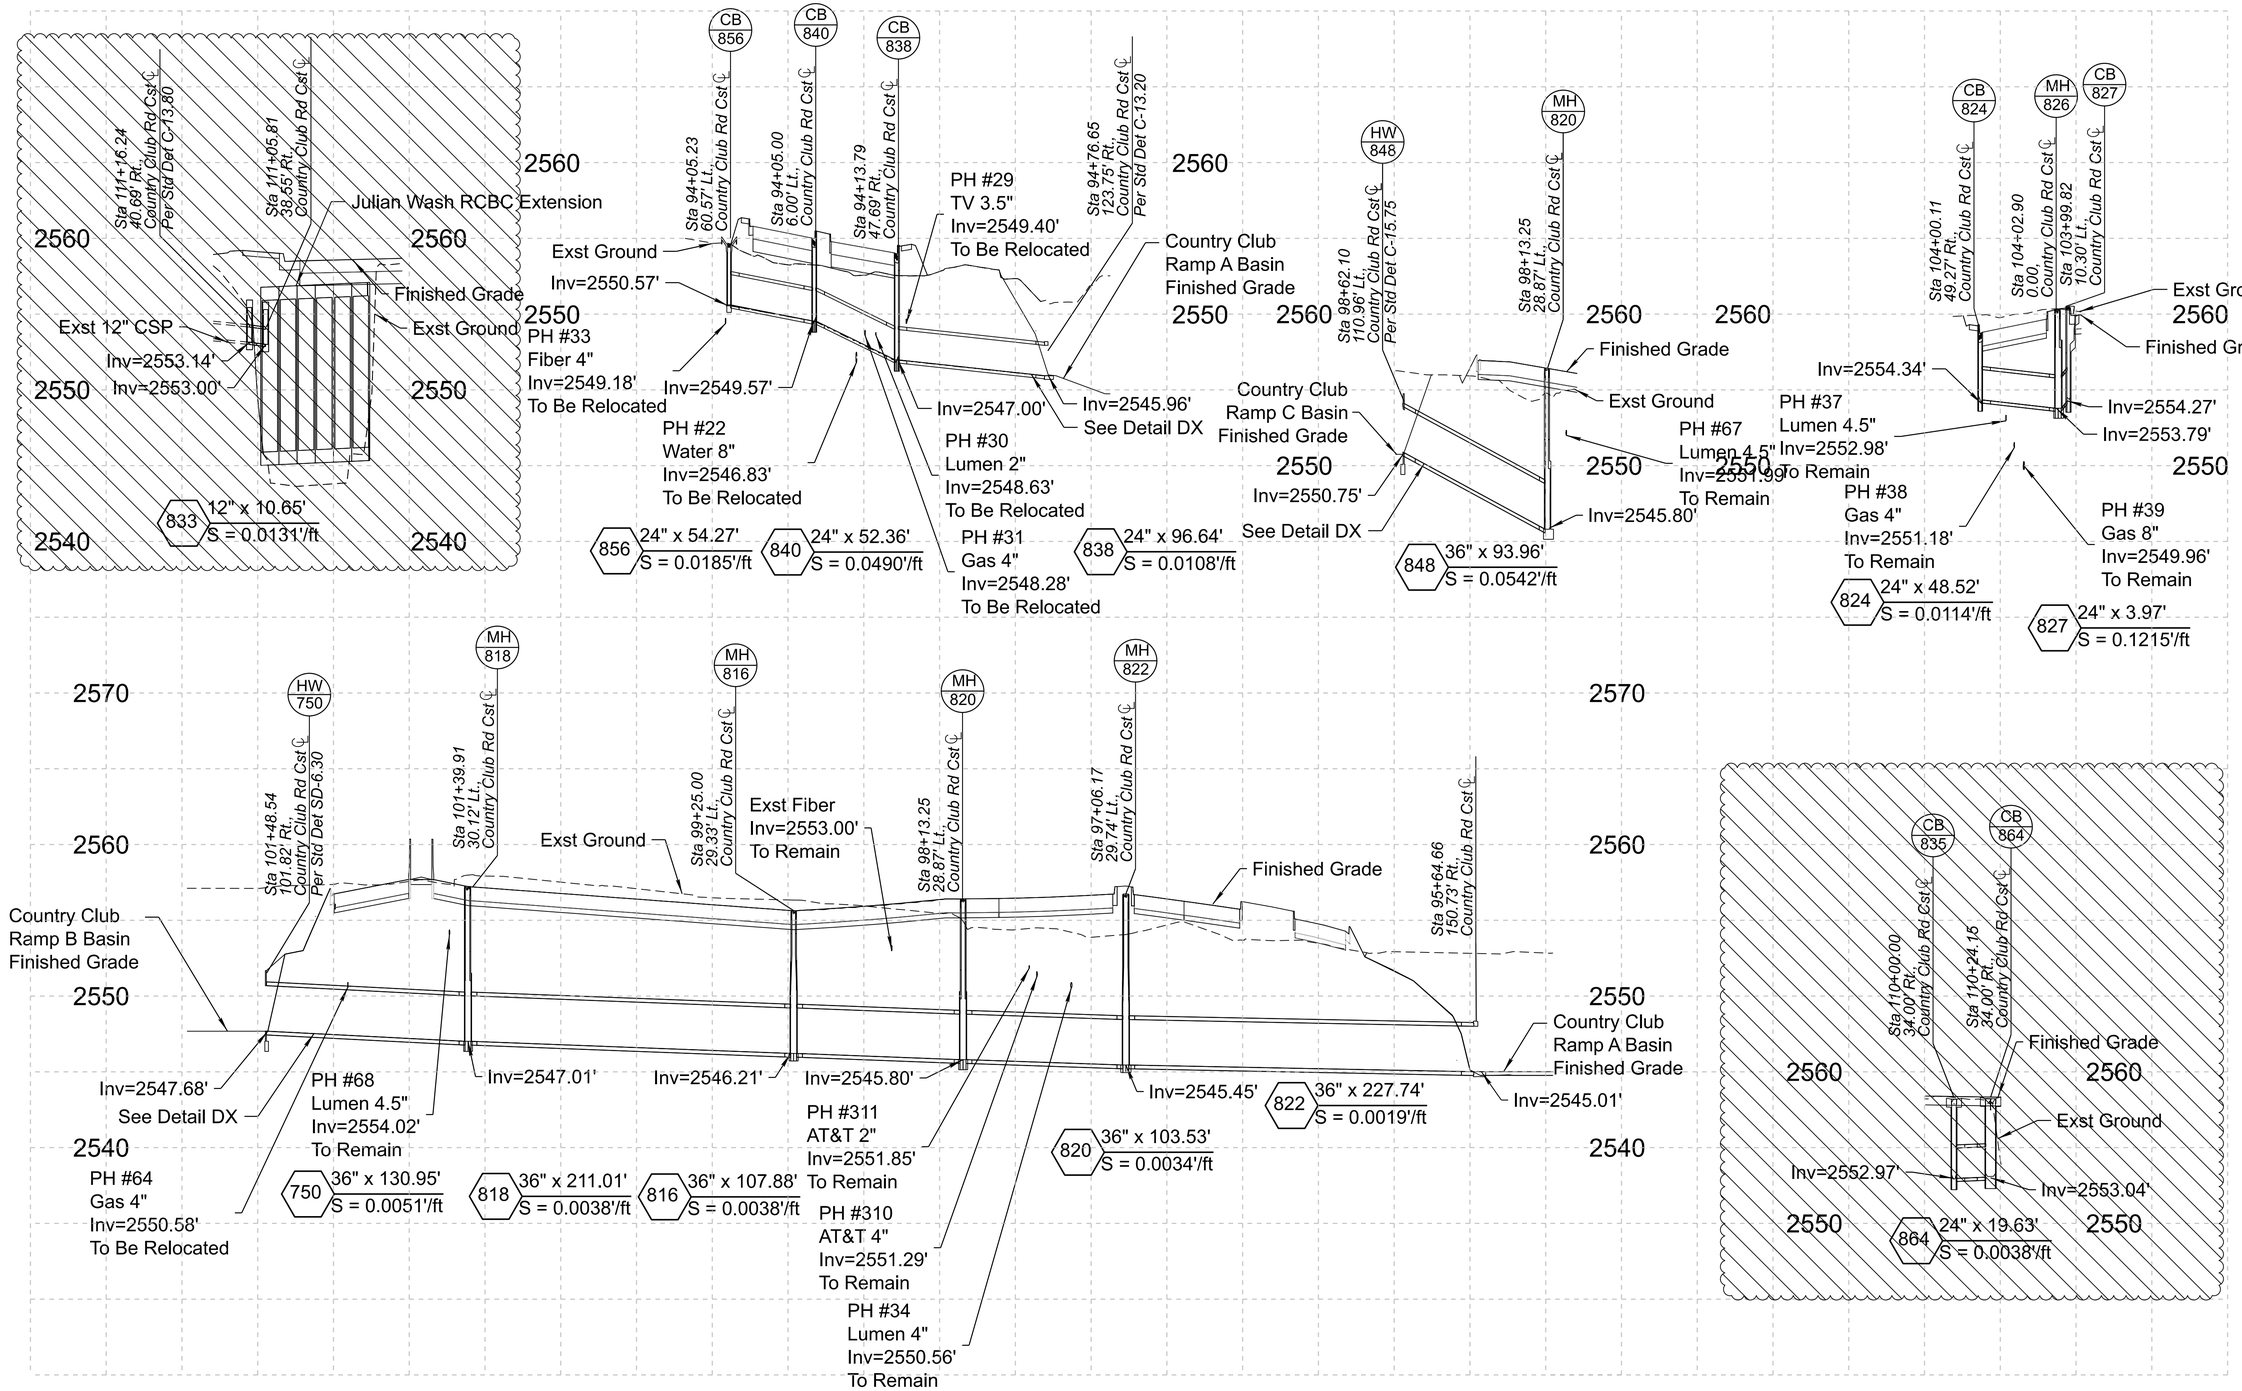

NO.	DESCRIPTION OF REVISIONS	BY	DATE
0	RFC RELEASE	TM	08/18/25

Registered Professional Engineer (Civil) CERTIFICATE NO. 65939 TIMOTHY MAHON Date Signed ARIZONA, U.S.A.

	NAME	DATE
DESIGN	J. FLINT	9/25
DRAWN	L. BREINING	9/25
CHECKED	T. MAHON	9/25

SUNDT AZTEC TYPSA

ARIZONA DEPARTMENT OF TRANSPORTATION
INFRASTRUCTURE DELIVERY AND OPERATIONS DIVISION
ROADWAY DESIGN SECTION

DRAINAGE PROFILE SHEET

ROUTE I-10
MILEPOST
STRUCTURE NO.

F.H.W.A. Arizona Division	STATE	PROJECT NO.	FEDERAL ID NO.	SHEET NO.	TOTAL SHEETS	RECORD DRAWING
	ARIZ.	010 PM 262	010-E(232)S			

LOCATION I-10 COUNTRY CLUB RD AND KINO PKWY TIS

DWG NO. D-02.22

TRACS NO. F0548 01C

ADOT

____ OF ____

9/8/2025 3:00:14 PM pw://jacobs-us-va-pw.bentley.com:jacobs-us-va-pw-04/Documents/W7Y58401 - I-10 - Kino Parkway Design Build/30 Project Data/PID/Drainage_Aztec/Sheets/f0548dv206