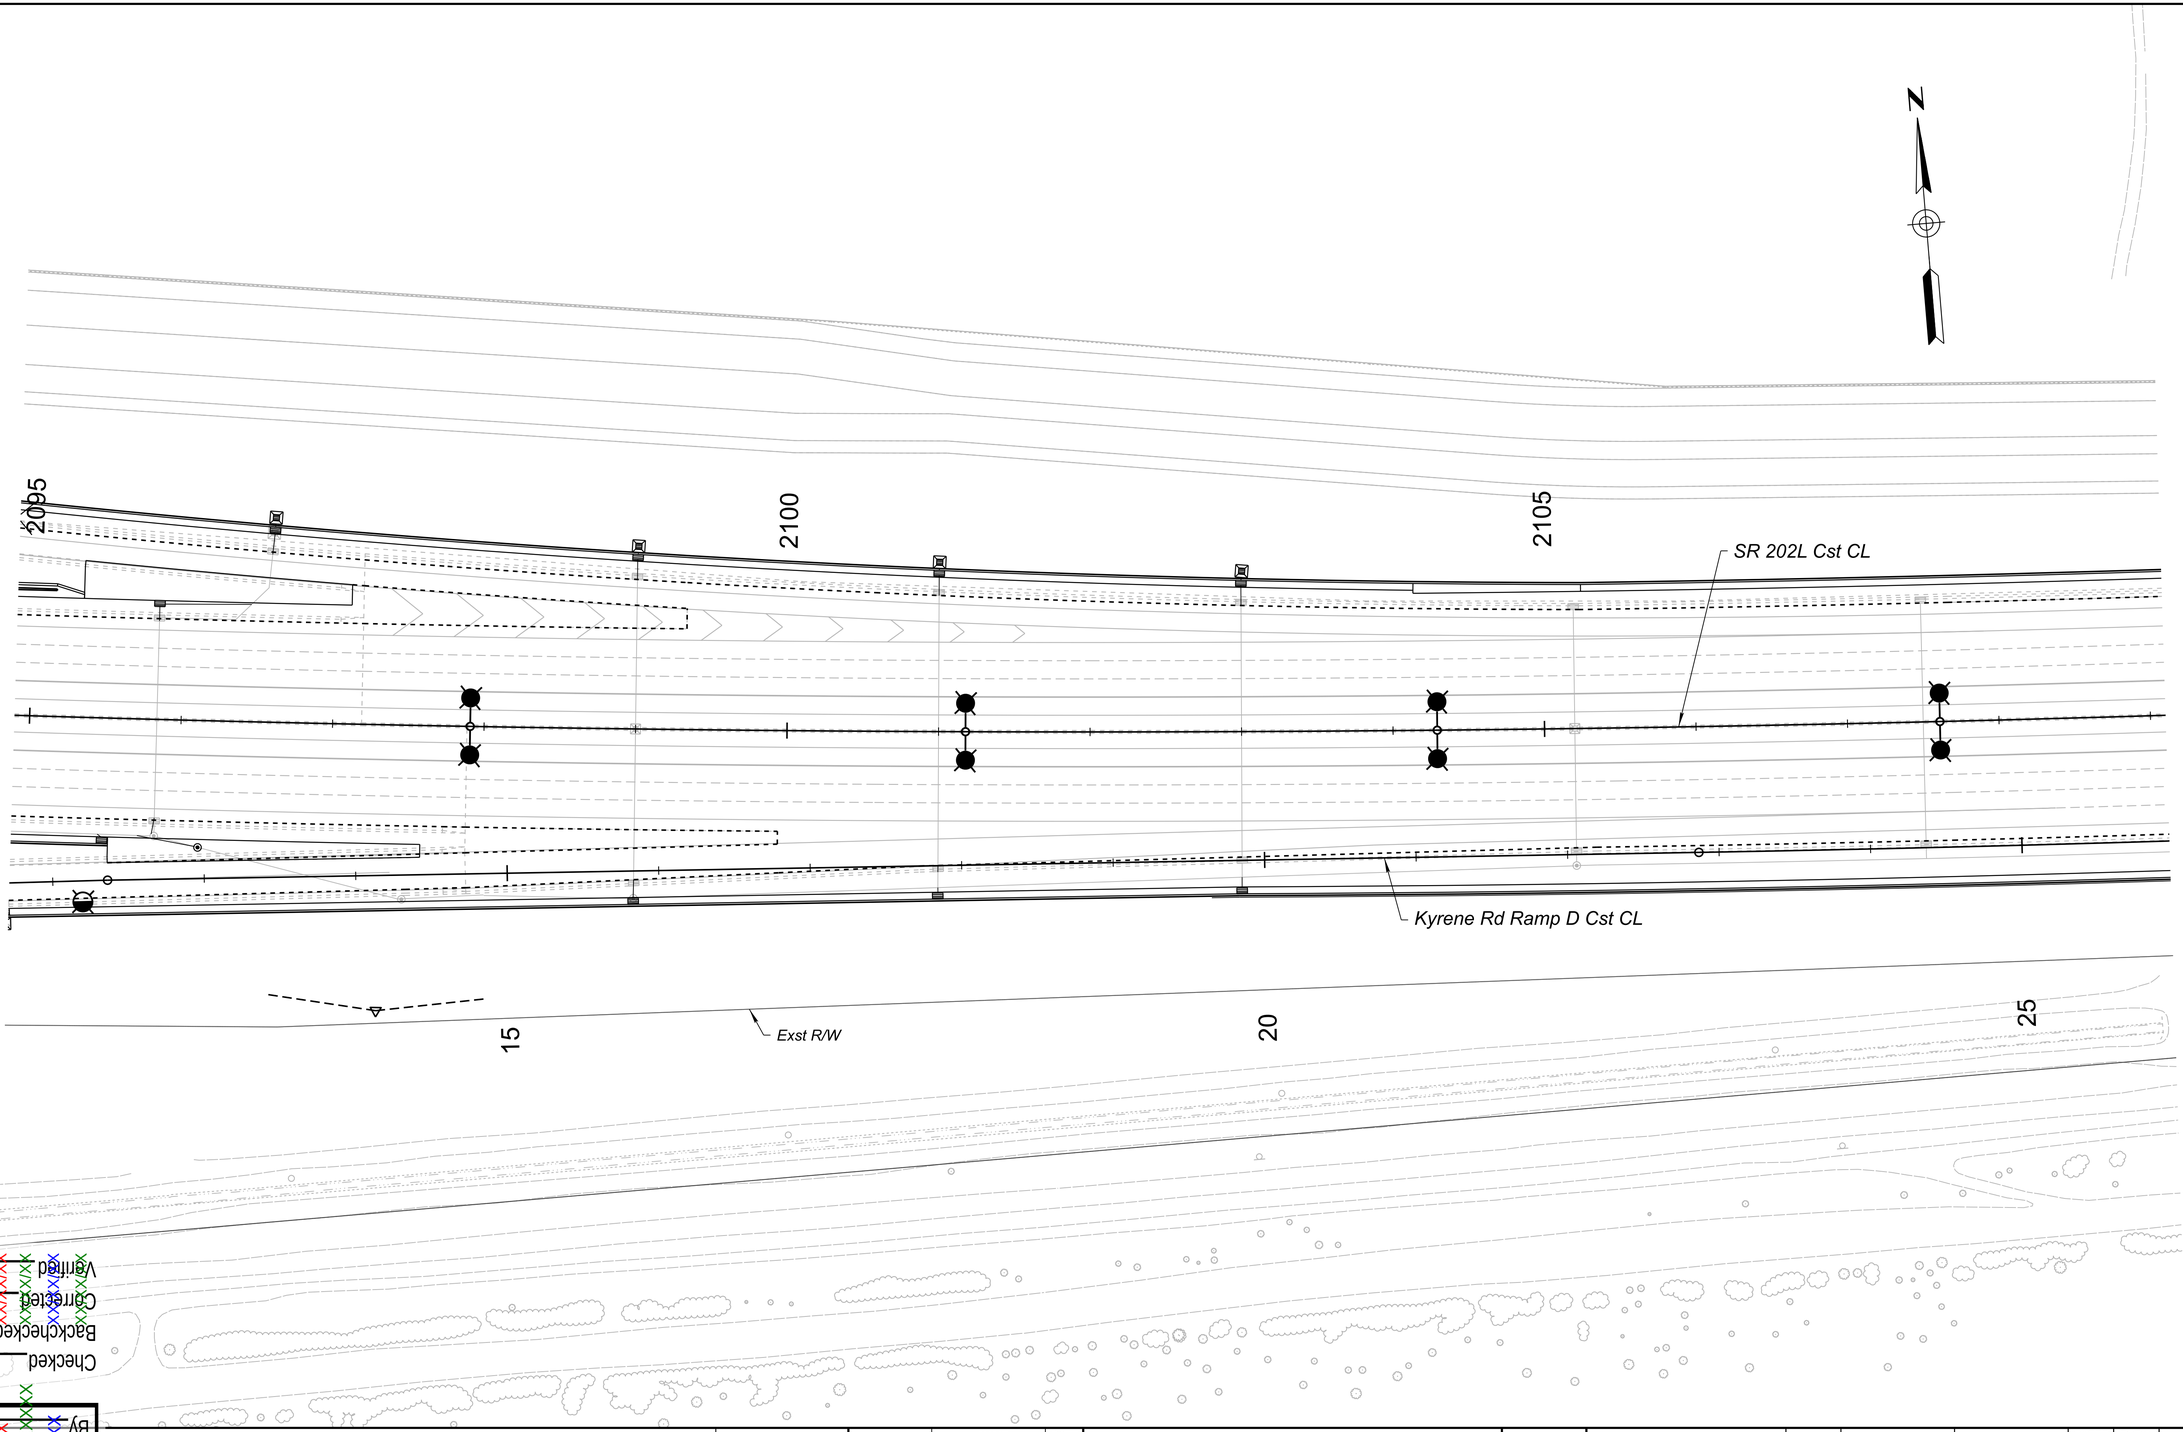

Checked Date
Backchecked Date
Corrected Date
Verified Date

CHECK PRINT
Dgn. checked against calcs.
and calc. check confirmed.
By Date
No. Date

PRELIMINARY
STAGE III
Review
NOT FOR CONSTRUCTION OR RECORDING

	NAME	DATE
DESIGN		
DRAWN		
CHECKED		

TYPSA
501 N 44th St, Suite 300
Phoenix, AZ 85008-4505
Tel (602) 454-0402
www.typsa.us

ARIZONA DEPARTMENT OF TRANSPORTATION
PROJECT DELIVERY AND OPERATIONS DIVISION
DRAINAGE DESIGN SECTION

SR 202L
DRAINAGE PLAN SHEET
STA 2095+00 TO 2109+00

ROUTE SR 202L
MILEPOST
STRUCTURE NO.

F.H.W.A. Arizona Division	STATE	PROJECT NO.	FEDERAL ID NO.	SHEET NO.	TOTAL SHEETS	RECORD DRAWING
	ARIZ.					

LOCATION SR 202L SANTAN FREEWAY - I-10 TO SR 101L
DWG No. D-02.10
TRACS NO. F0847 01D
____ OF ____

Jake 2/11/2026 3:00:52 PM AZDOT 2024\AZFWY1704-FD02-SR202 - I-10 to SR101\CADD\Sheets\050_D-02.10_d0847drn.dgn