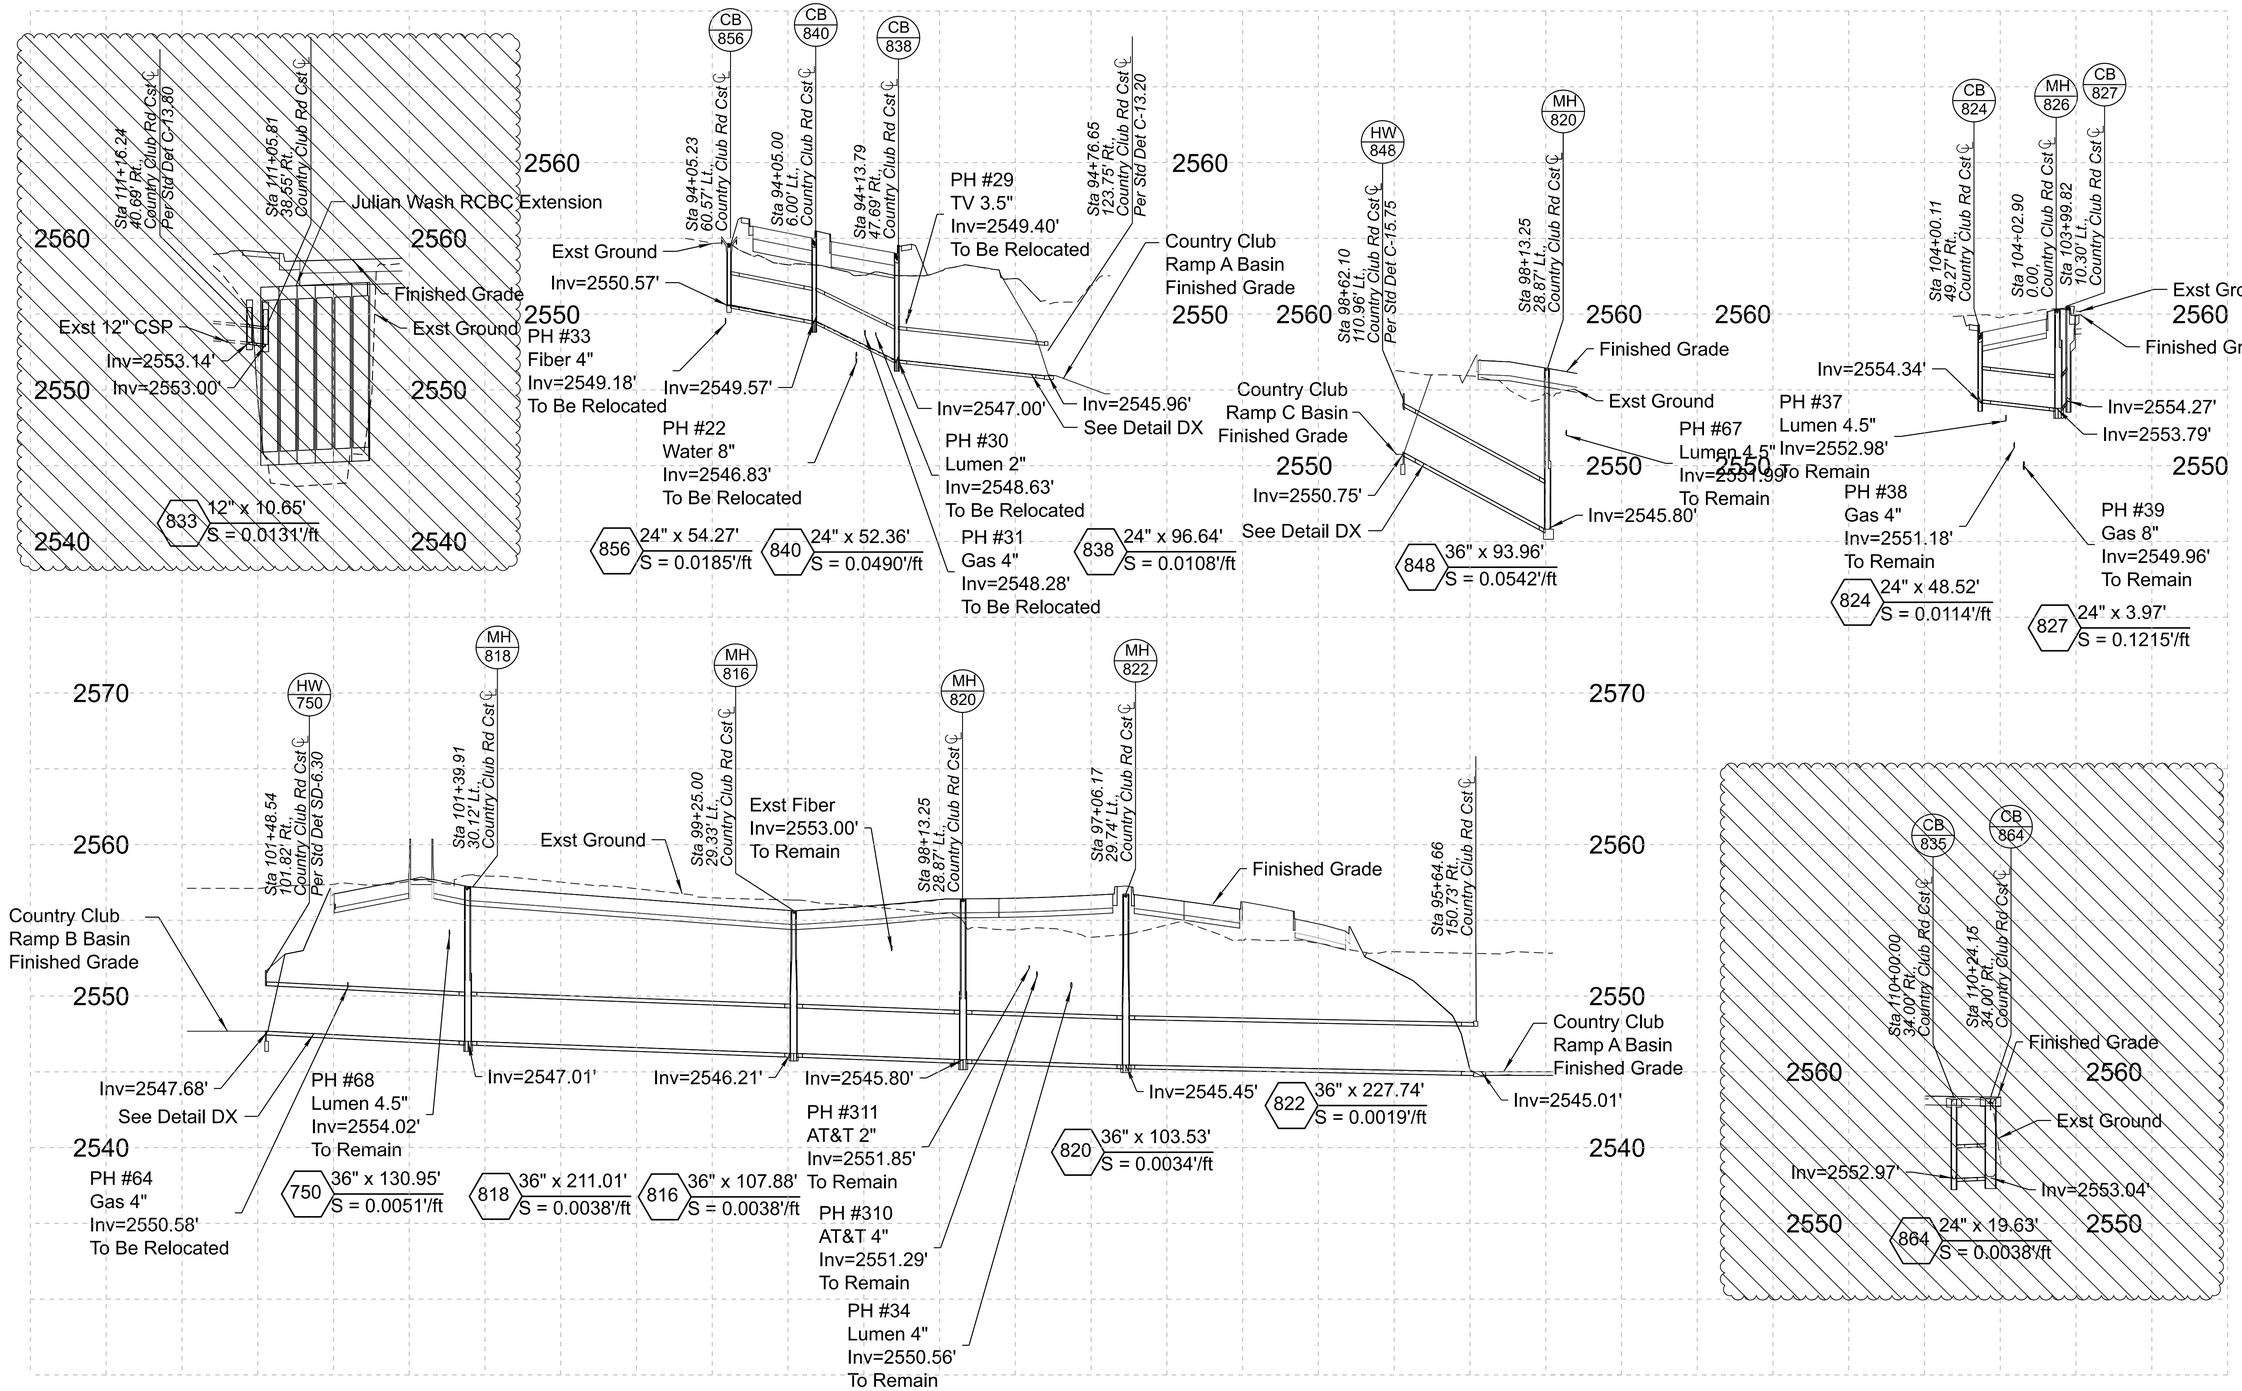

NO.	DESCRIPTION OF REVISIONS	BY	DATE
0	RFC RELEASE	TM	08/18/25

Registered Professional Engineer (Civil) CERTIFICATE NO. 65939 TIMOTHY MAHON Date Signed ARIZONA, U.S.A.

	NAME	DATE
DESIGN	J. FLINT	9/25
DRAWN	L. BREINING	9/25
CHECKED	T. MAHON	9/25

SUNDT AZTEC TYPSA

ARIZONA DEPARTMENT OF TRANSPORTATION
INFRASTRUCTURE DELIVERY AND OPERATIONS DIVISION
ROADWAY DESIGN SECTION

DRAINAGE PROFILE SHEET

ROUTE I-10
MILEPOST
STRUCTURE NO.

F.H.W.A. Arizona Division	STATE	PROJECT NO.	FEDERAL ID NO.	SHEET NO.	TOTAL SHEETS	RECORD DRAWING
	ARIZ.	010 PM 262	010-E(232)S			

LOCATION I-10 COUNTRY CLUB RD AND KINO PKWY TIS

DWG NO. D-02.22

TRACS NO. F0548 01C

ADOT

____ OF ____

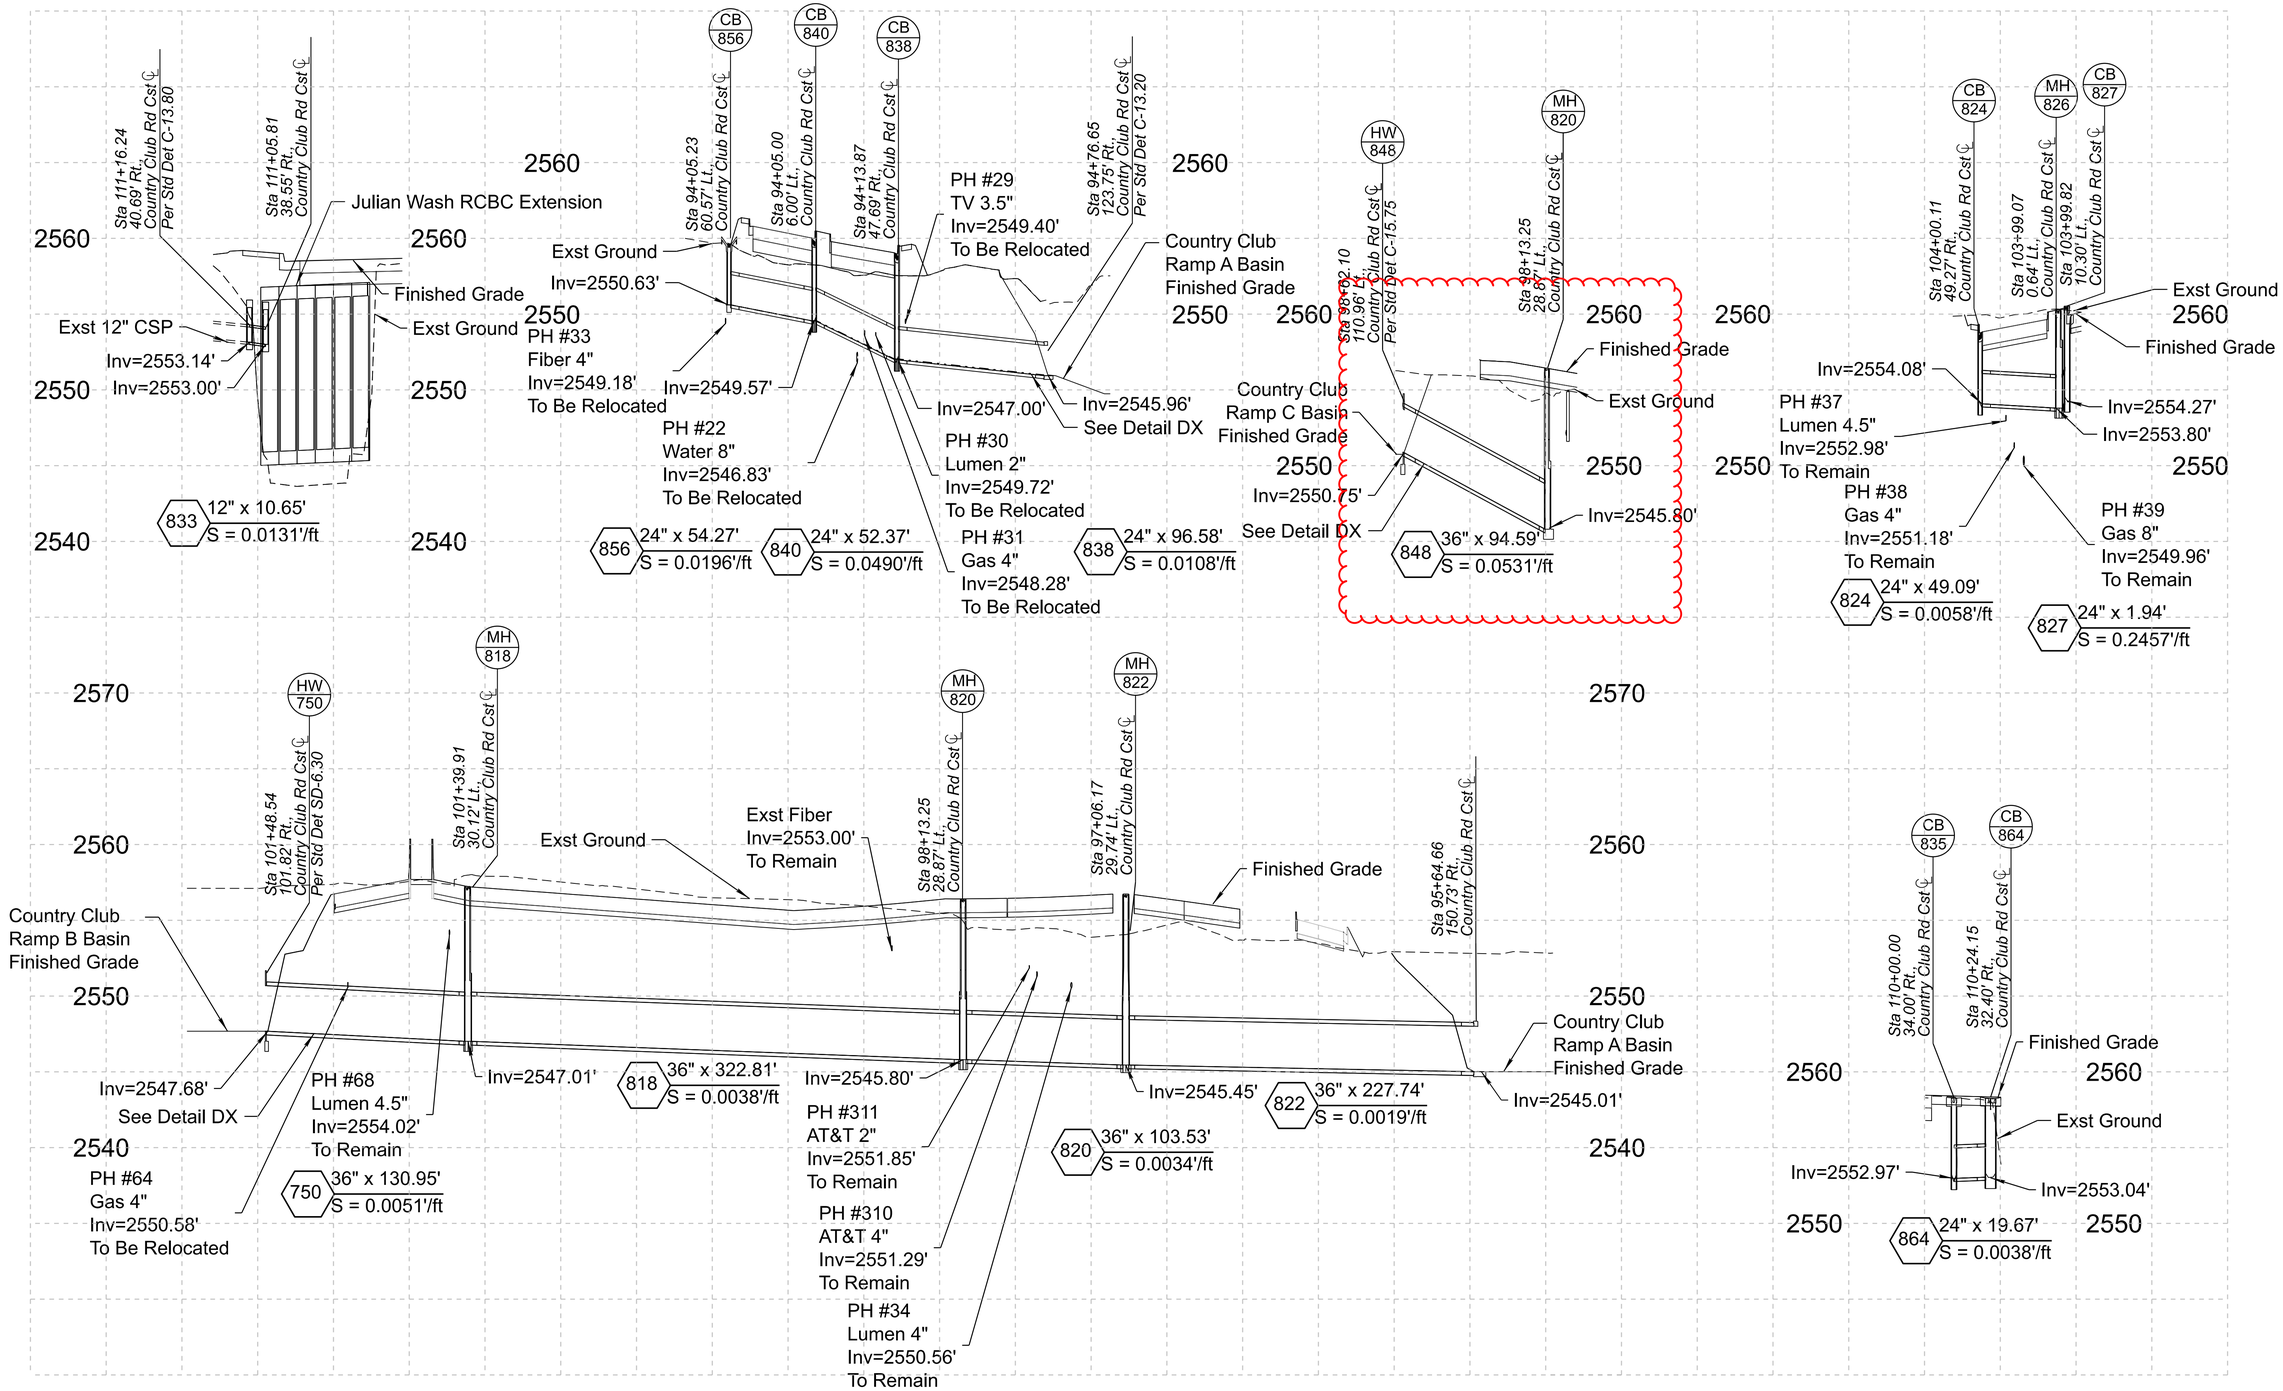

NO.	DESCRIPTION OF REVISIONS	MADE BY	DATE
R00	RFC RELEASE	TM	08/18/25

DATE - LOCATION - REVISIONS - FINISHED PLANS - SURVEY NO.

Registered Professional Engineer (Civil) CERTIFICATE NO. 65939 TIMOTHY MAHON Date Signed ARIZONA, U.S.A.

	NAME	DATE
DESIGN	J. FLINT	8/25
DRAWN	L. BREINING	8/25
CHECKED	T. MAHON	8/25

SUNDT AZTEC TYPSA

ARIZONA DEPARTMENT OF TRANSPORTATION
INFRASTRUCTURE DELIVERY AND OPERATIONS DIVISION
ROADWAY DESIGN SECTION

DRAINAGE PROFILE SHEET

ROUTE I-10
MILEPOST
STRUCTURE NO.

F.H.W.A. Arizona Division	STATE	PROJECT NO.	FEDERAL ID NO.	SHEET NO.	TOTAL SHEETS	RECORD DRAWING
	ARIZ.	010 PM 262	010-E(232)S			

LOCATION I-10 COUNTRY CLUB RD AND KINO PKWY TIS

DWG NO. D-02.22

TRACS NO. F0548 01C

ADOT

____ OF ____

8/6/2025 10:44:07 AM pw://jacobs-us-va-pw.bentley.com:jacobs-us-va-pw-04/Documents/W7Y58401 - I-10 - Kino Parkway Design Build/30 Project Data/PID/Drainage_Aztec/Sheets/f0548dv206